


5/3/43

Found flat stone 2"x8"x12" on top of  
stone 5"x5"x19. Brick around both  
stones and placed mon. 8" below  
surface

J.H. Tuskeep  
Lane Kerns  
Paul Foot

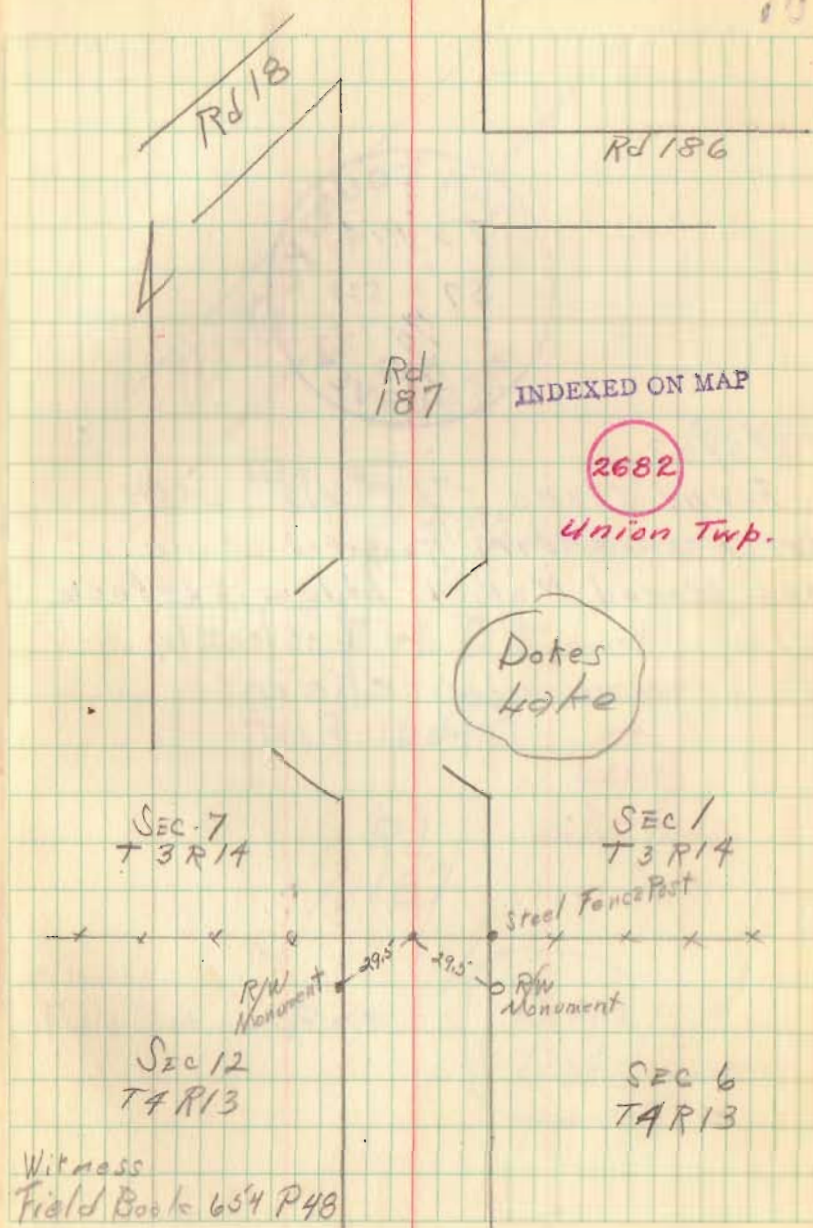

Witness  
Field Book 654 P48