

Road No. 198 Union Township Logan Co.

11+00 Monuments (Hubs Sat)

6100 Monuments

Index 3603

1400 Monuments


Note. - Road 198 Width 30'
Road 198 Width 40' see
Easement Plans X-198
From CH 18 to CH 200
Jan. 6, 1941

Revised Aug.

Angle
to Sec. Line $14+40.7'$
 $1^{\circ}-16' L.$
 $2^{\circ}-32' L.$

Oct. 8, 1939 31
E. Cole
G. Wilgus
J. H. Inskoop
C. Keysar
M. Jones

Ohio

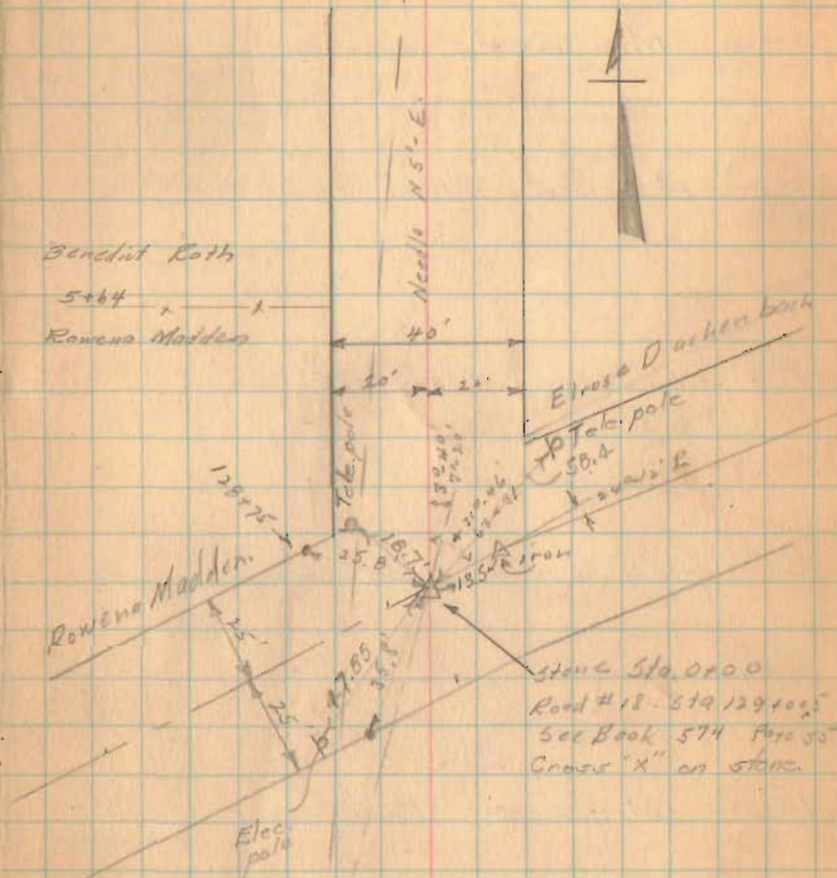

J. Roth
stone
Sec 7 73 R14
Sec. 12 74 R13 15
Roy H. Keens

J. Roth
James B. Bastian

Road 198. Union Twp.

33+00 Monuments (Hubs Set)

30+00 Monuments (Hubs Set)

24+00 Monuments (Hubs Set)

20+00 Monuments (Hubs Set)

15+00 Monuments (Hubs Set)




10/8/39

32


E. K. Corb
G. Wilcox
✓ H. Inskip
C. Keyser
M. Jones

Jesse C. Hostetter
28+15.3
x
Leslie Mohr

Leslie Mohr
x 21+32.2
David E. Stonacker

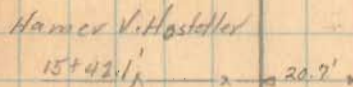

Cemetery

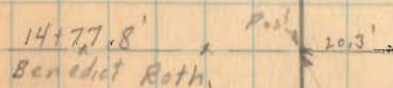

David E. Stonacker
et al

Stoner
51+14+40.7
00-37' Right
10-14'



W. J. Bachelderbaugh

10" Hickory

W. J. 24' Oak

Road # 198 Union Twp.

57+00 Hubs set for Man. (10/16/50)

56+00 Monuments (Hubs set)

54+00 Monuments (Hubs set)

50+00 Hubs set for R/W Man. (10/16/50)

42+00 Monuments (Hubs set)

41+00 Monuments (Hubs set)

37+00 Monuments (Hubs set)

10/8/39

33

E. Lane
G. H. Jones
J. H. Inskoop
C. E. Keyser
M. E. Jones

D.R. Spike cor
57+07.7

6' 00" cor
post

20.6'

(shuttle N 5° E)



iron pin

115'

R.L. Fultz

post

49+35.7

Mollie I Detrick

Elsie R. Fry

Sec 8 T. R

Mollie I Detrick
Sec 8 T. R

stone
sh 41+65.7
0° 23' R.
Road # 43
0° 46'

Tal. Pole.
Notar-See
FB 660 pg 9
for new witnesses



Sec 7 T R
Amos Husteller

E.L. Pole


Sec 7 T R
Jessie C Hartzler

90° 53'
181° 46'

steel post.


10/9/39 - 34
 E.K. Cole
 J.H. Inskoop
 C.E. Kepsel
 M.E. Jones
 Moses Curl

Road #198 Union Twp

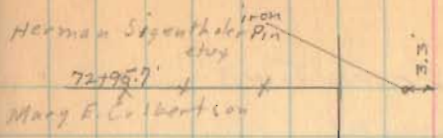


J.M. Sigalosa
 no fence 70+94.5
 R.L. Feltz

72+00 Monuments (Huber Set)

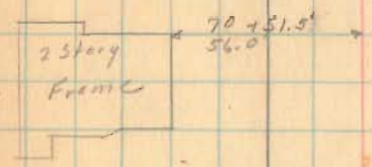


Mary F. Colbedson

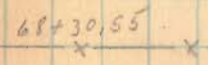

Elsie R. Fry




66+00 Monuments (Huber Set)

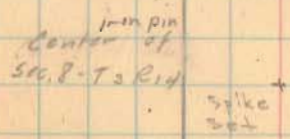

65+59

65+44

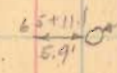

2" Oak

61+00 Monuments (Huber Set)

10/9/39
E. K. Cox
J. H. Inglish
C. E. Keyser
M. E. Jones
Moses Curl

35


Road # 198 Union Twp.

87+00 Monuments (Hub Set)



Milton Jacobs

82+00 Monuments (Hub Set)

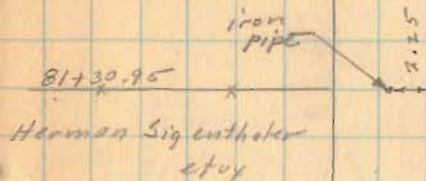

H. W. Ewing et ux

77+00 Monuments (Hub Set)



80+27.7
A. B. Barnes




H. B. Barnes
J. M. Sigafos

Road # 198 Union Twp.

10/9/39
E.K. Cook
J. H. Inskip
C. E. Keyser
M.E. Jones
Misses Carl

36

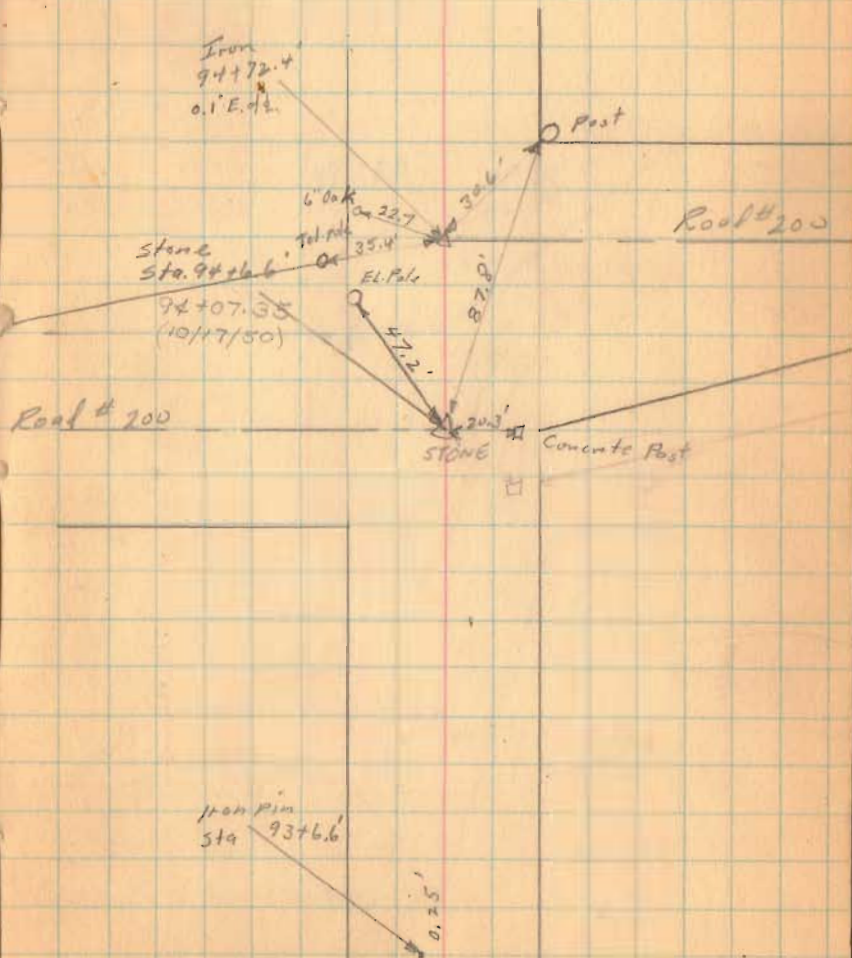

93+00 Monument (Hub Set)

72.4
22.7
22.7