


FB 700

C.H. # 187
Union Twp.

Stakes set on Divens
farm 20' from R - 70' R/W

D. Dodson
G. Wilgus
V. Detrick

Mar. 20, 1953
Warm 63

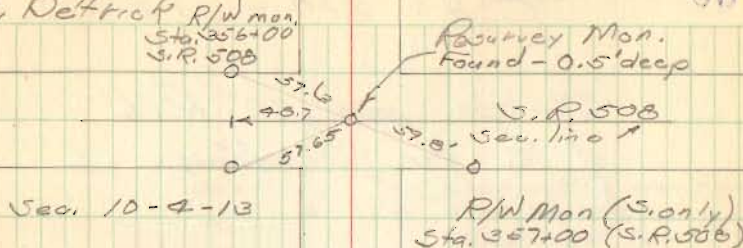


See F. B. 582 pp. 27
for survey of S.R. 508

C.H. # 187



4376

INDEXED ON MAP

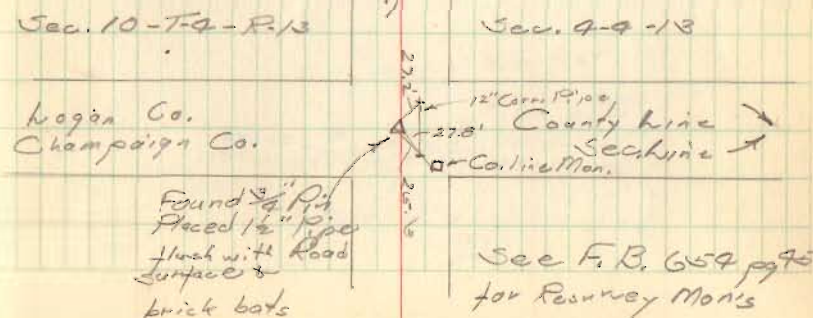

Found 3/8" P.
Placed 1/2" P.
Flush with Road
Surface
brick bats

See F. B. 654 pp. 75
for Resurvey Mon's