The following described real estate situated in the Township of Union, County of Logan, State of Ohio and being a part of the east hald of Section 7, Town 3, Range 14, B. M. R. S. and being out of the northwest corner to A. Q. R. Nicholl's present 9.00 Acre tract and being more particularly described as follows:

Beginning at a stone, marking the northwest corner to said 9.00 Acre tract and being in the centerline of C. H. No. 18 at Station No. 152 + 77 as shown in Logan County Engineers Field Book No. 574 Pages 56-57:

Thence with the centerline of C. H. No. 18, N. 58° 00' E. 337.50 feet to a R. R. Spike set;

Thence S. 7° 28' W. 273.30 feet to an iron bar set, passing through an iron bar at the south right of way line of C. H. No. 18 at 32.40 feet:

Thence N. 83° 04' W. 260.60 feet to an iron bat set in the west line of said 9.00 Acre tract;

Thence with the west line of said 9.00 Acre tract, N. 7° 28° E. 61.00 feet to the place of beginning, passing through an iron bar at 28.60 feet, containing 1.00 Acres, more or less.

I hereby certify that this is a description prepared from a survey made by Owen K. Shirk, October 23, 1965 as recorded in his Field Book No. 9 Page 14.


Daniel E. Gilbert, P.S.

Reg. Sur. No. 5402

1041 N. Main St.

Bellefontaine, Ohio 43311



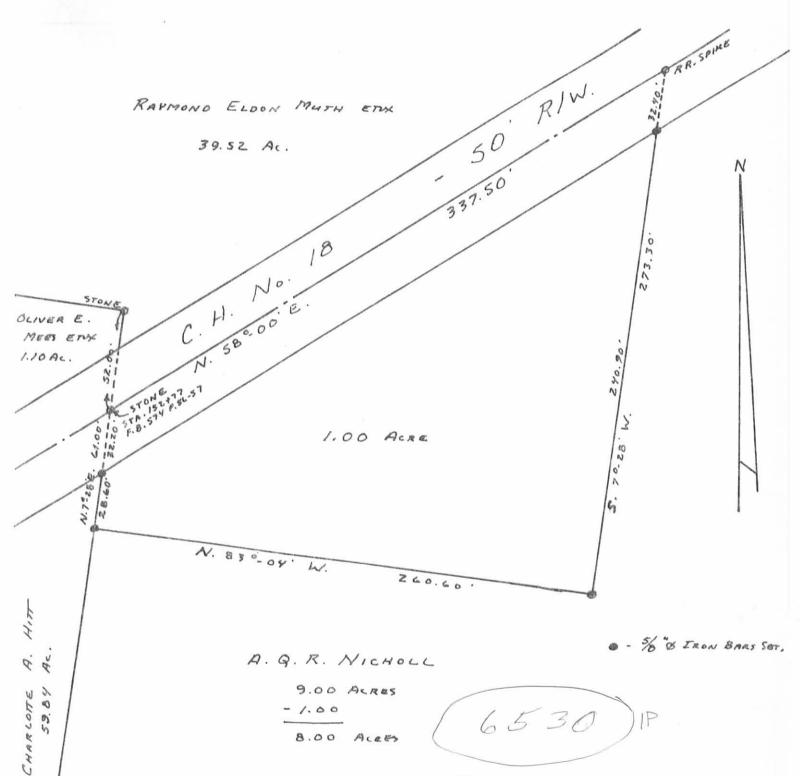

NOTE: THIS PLAT AND DESCRIPTION COMPILED FROM SURVEY MADE BY OWEN K. SHIRK (10-23-1965)

PLAT AND DESCRIPTION BY DANIEL E. GILBERT, P.S. REG. SUR. NO. 5402 1041 N. MAIN ST. BELLEFONTAINE, OHIO 43311

INDEXED ON MAP

NICHOLL SURVEY SECTION 7 T.3 R. 18/B.M.R.S. UNION TOWNSHIP LOGAN COUNTY, OHIO JUNE 3, 1981

SCALE: 1"=50"