

at 100 poles came to the south bank of the lake referred to by Mr Snoddy in said depn, which lake is 30 poles wide; at 160 poles took the ^{westerly} part of the deposition of John Moore et al and the depn of G. J. Dunn et al continued to 320 poles, to a stake in the edge of a prairie — thence with the line between Sect. 14 & 9 in said T.R. 189^E came to the side of deep pond at 60 poles, which is 42 poles wide, passed the original go sec. corner at 164 poles, one of the bearing trees is yet standing and bears S 85 E 10 L mts dist. the root & place of the other was found, continued 326 poles to the original corner of Sect 14 & a white oak originally marked when 26^{ds}, bears N 21 W 30 L a hickory 160^{ds}. N 14 W 65 L — thence with the line between T 3 & 4 R 11 & 10 320 poles to the original corner of said Township, a white oak 16^{ds}. or 62 M 18 L yet standing — the other a white oak 175 E 12 L. is down, but the root is remaining — thence with the line between R 13 & 14 & T 89 N 66 poles to the beginning — The red line shewz the claim of the defft.

Robert McMillan
Mr Snoddy

John McMillan
65 L. 6.

8th mo, Augt 5th 1834

Surveyor W. D. C.

Doc & dem.

Logan Com. pleat April term 1834

Vincent Gray

In Ejectment

Richd. Roe

In obedience to an order of said Court made in the above cause at said term, and in accordance to a notice served on the Pltf in said cause, by the defendant in the same, which said notice said Pltf acknowledged service of on the 29th of July A.D. 1834, I proceeded on the 5th day of August to survey the premises in controversy, under the directions of said Deft's agent and attorney —


187

Beginning at the corner of Townships $\text{er}^{\circ} 4 + 5$
 R^W S^E 13^S & R^W 12. N. M.P.S., this being the south east corner
 of sect. 1 in T^S R^W 14 M.P.S. the original bearing trees here
 as called for by the notes which I have for each of these
 Towns are a "white oak 16 in. diam N^E 8^W E 12 L. a white oak
 16 in. diam N^E W 18 L" the former of these is fallen, the root
 is remaining. — Hence with the line between Town^S 3^N
 R^W 14 and sec^W 14 31 in said Town, N^E 8^W 22 poles to the ori-
 = ginal corner between said sec^W 14 2 T^S R^W 14 & sec^W 3 18 32
 T^S R^W 11, represented on the plat by the letter B, original
 bearing trees standing a "white oak 26 L. 52 1/2 in. dbh
 a hickory 16 L. 27 1/2 in. dbh." — Continued on the
 same course between sect 2 & 32 of T^S R^W 14 32 poles to
 the original between sect 2 & 32 & 33 of said T^S R^W 14
 a "white oak 16 L. 56 2/8 in. dbh. a black oak 25 L.
 47 1/2 in. dbh." — Hence between sect 2 & 3 T^S R^W 14 38 2 W
 (crossed a prairie)

a small branch
 twice at 40 poles
 321 poles poles
 to the original
 corner between

sec^W 12 & 3. T^S 8
 in said Town
 R a "white oak
 12 L. 56 9 E 8 L
 a hickory 16 L.
 65 1/2 W 38 L"

the former tree at G 58 9 1/2 E 8 33 1/4 H 58 9 1/2 W 30 8 6
 this corner is down

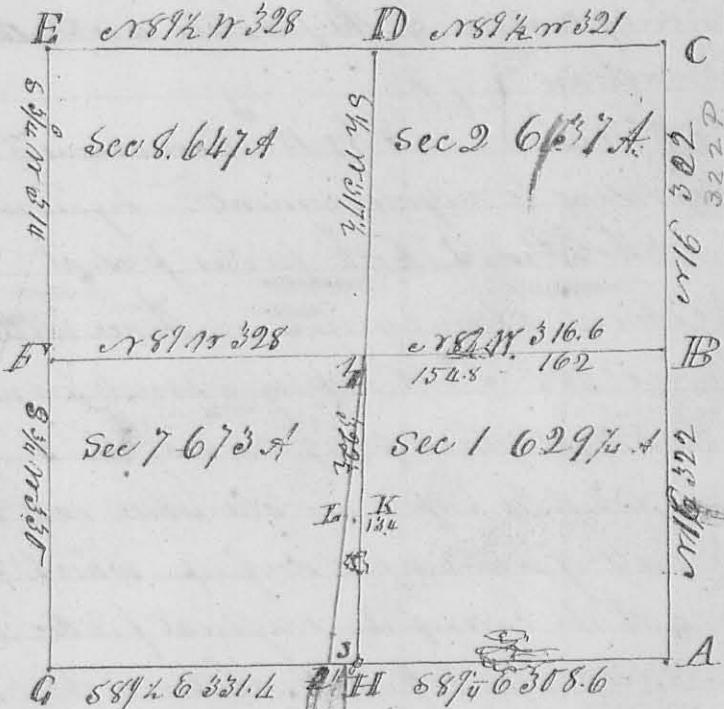

A Beginning

the sign of the root yet remaining. — Continued same course
 between sect 8 & 9 same T^S R^W 14 crossed a small branch at
 180 poles) 328 poles set a stake in a prairie 5.6 poles south
 of the end of the line between sec^W 14 & 15 (the original
 field notes call for a stake here) — Hence with the old
 line between sect 8 & 14, N^E W 31 4 poles to the original corner
 between sect 9 & 13 & 14. the original bearing trees are down.

yet there are some remains of their roots here. — Continued same course between secs 7 & 13 330 poles to the original corner of Secs 7 & 13 T 3 R 16 and Secs 12 & 18 T 4 R 13. — The original bearing trees a white oak 18 I.D. & 48' W 56 L. a white oak 22 I.D. & 69' E 51 L" both yet standing. — Hence on the original line between said T 4 R 13 & T 3 R 16 58 $\frac{1}{2}$ E. crossed a small branch at 40 poles 316 passed a stake at the end of the line between Secs 6 & 12 T 4 R 13 396 poles, set a stake in a prairie. Continued S 89 $\frac{1}{2}$ E on the old line came to a deep pond at 186 poles, which is 60 poles wide 392 poles to the place of beginning, including 4 sections in the E. E. corner of said T 3 R 14. —

From the corner between Sec 14 & 2 with the original line 189 $\frac{1}{2}$ 7162 poles, found the original gr sec corner between Secs 14 & 2 as per field notes a "white oak 16 I.D. 326' W 8 a white oak 16 I.D. 185' E 10 L" the latter is standing the place of the former was found continued came to a deep pond at 228 poles, 49 poles wide, set a stake at 326 poles at figure 1 near the latter. Then adjourned by consent of the parties until the 12 inst

Ja Broughtow { C. C.

Robert McCready } Day 12th recommended to survey ~~again~~ again according to adjournment — beginning at the corner of Secs 2 & 8, at the latter D both parties present Daniel Robinson & Daniel McCrat chain carrying. — Hence with the original line between Secs 2 & 8 S 2 $\frac{1}{2}$ W crossing a small branch 238 poles to the line 1 B 3.2 poles east of figure 1 at the E. — Continued same course, at 156 poles passed an old white oak stump, and the place where the roots of a tree were dug up, which correspond very nearly with the eales of the original field notes for the gr sec corner between Secs 14 & 7, but whether either the stump remaining or the tree whose roots were dug up were ever marked it is now impossible for me to say, at 212 poles came to a deep pond which is 30 poles wide) 326 poles set a stake at the latter E. — Then travelled to the end of the line 1 B and began at figure 1 and continued said line N 89 $\frac{1}{2}$ W 326 poles to the corner between Secs 7 & 13 ~~found the~~ 8 & 14 passing the original gr sec corner at 166 poles) The red line drawn from the point I through the point Ia to the figure 2 represents a line drawn from

189

from the intersection of the lines E B & D H and passing by the place which the Plff claims to be the origin of the corner between Secs 14 & 7, and terminates on the range line 12 poles west of the north end of the line between Secs 6 & 12 in T 4 R 13 which line is drawn with red ink and its intersection with said S line is represented by the figure 3.

The number of acres in each section as represented by the black drawing line is represented by the figures thereon,

Daniel Robinson { 66 Sa. W. Harmon
David Merritt } C. S. L. G.