


I.P. in center of Conc. 2' north of Witness-Conc. fda. for Arch N.E. 68
Construction joint marked by cross in Hickory tree South 73.3

N 55° W

(240)
INDEXED ON MAP

SURVEY of LOT NO 1.
SIESTA PARK
for
Stella Hagan
SEC 36 T 6 R 8 East
in Washington Tp.
Scale 1" = 100' *Feb 28/1922*
Earl H. Jewell
Dep. Co. Surveyor.

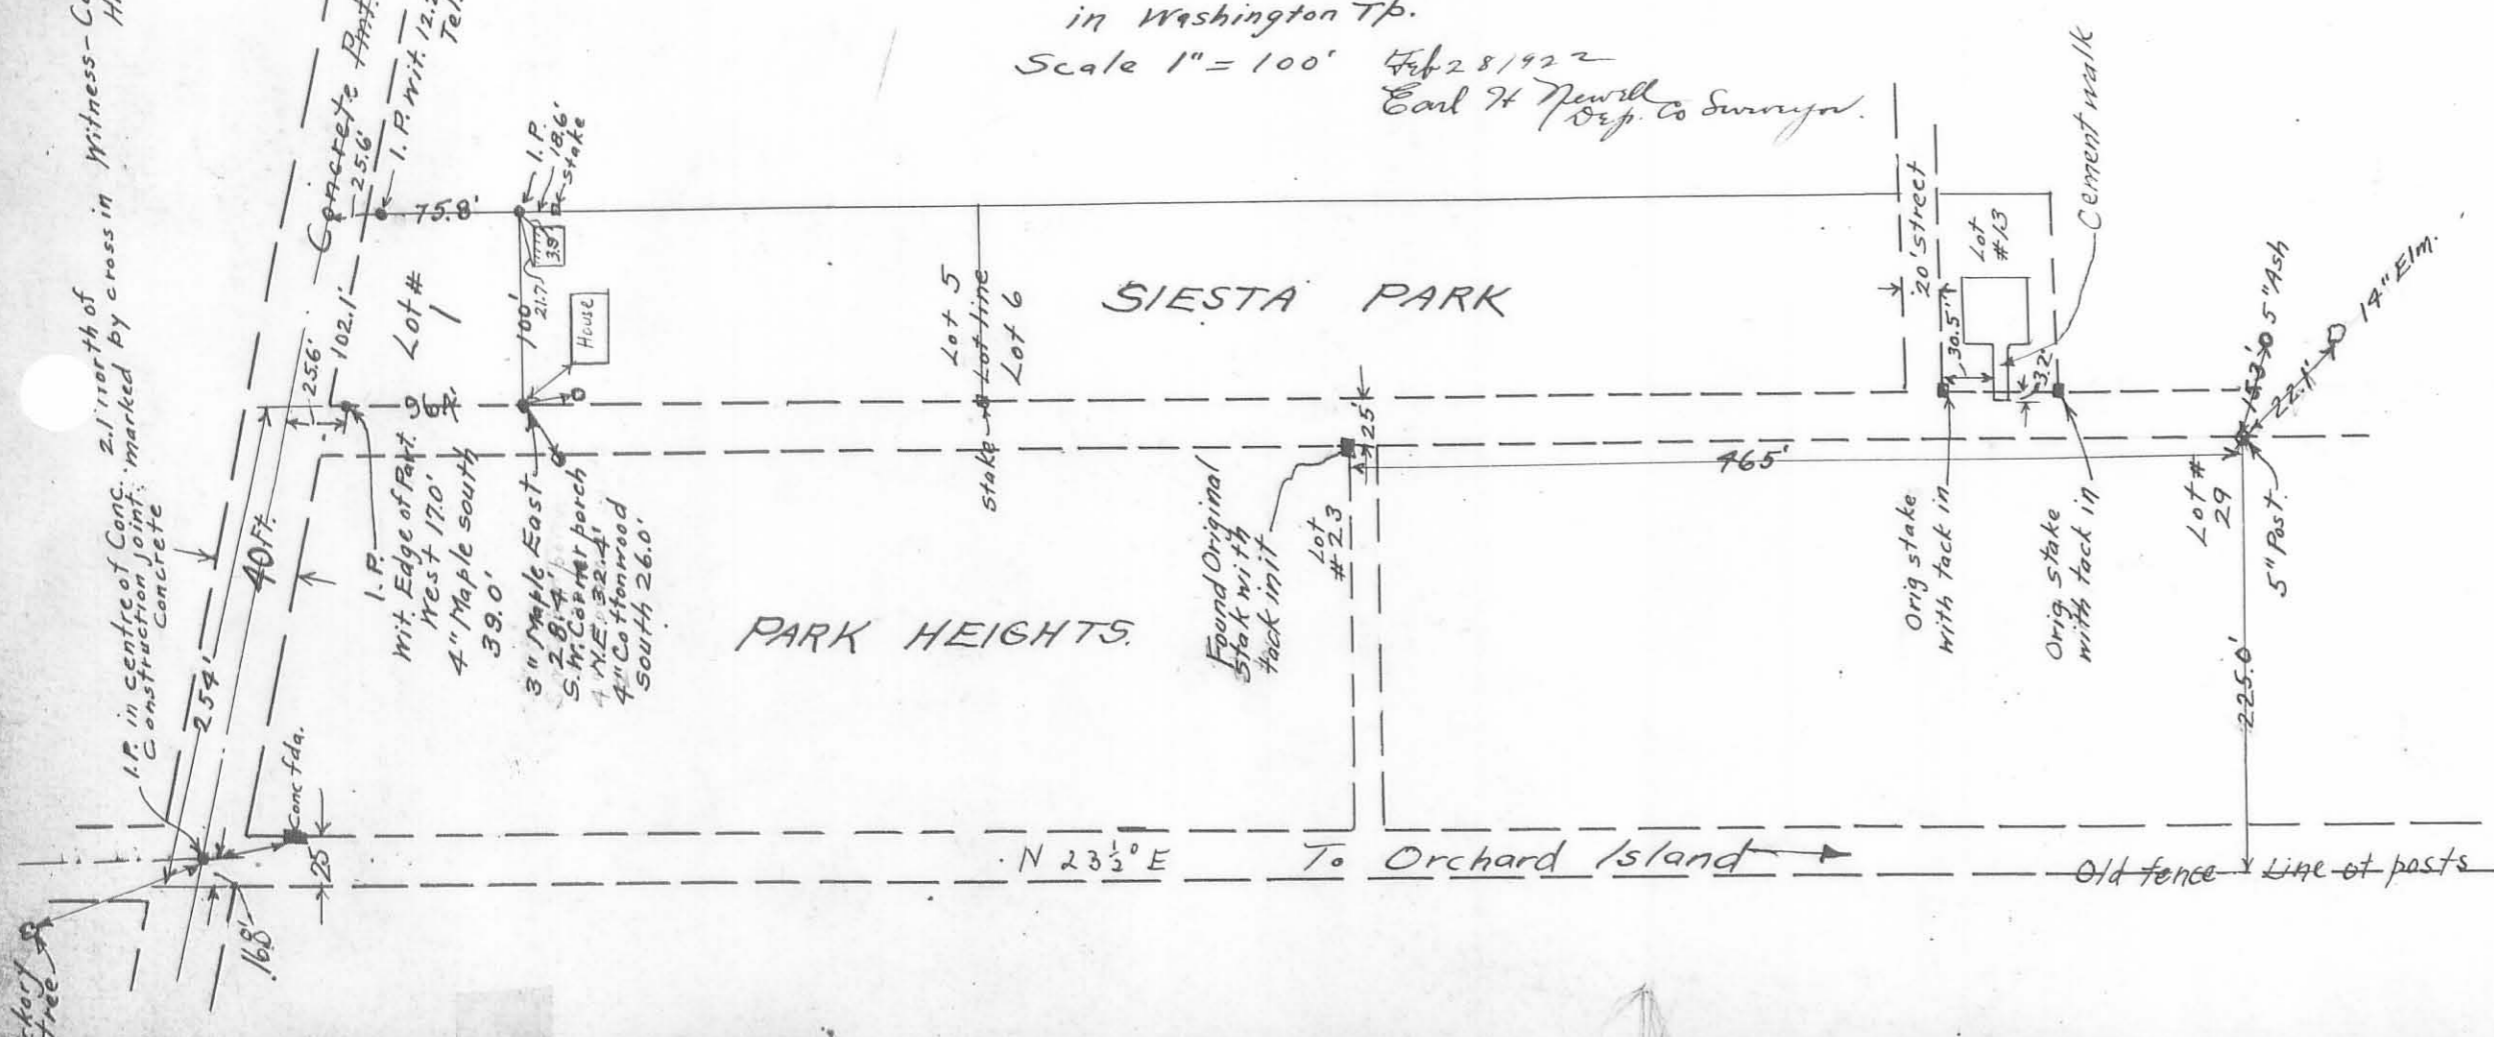

To Orchard Island

Old fence line of posts

SIESTA PARK

PARK HEIGHTS

SEC F

Lot # 1

Lot 5
Lot 6

Lot # 23

Lot # 29

20' street

Lot # 13

Hickory tree

160'

House

Cement mark