

Survey for Robt Moore
Sec 31 T-2-R-14
15


Washington Township.

583
INDEXED ON MAP



March 18 1926.
Spring day

W A Montgomery 30
W M Smucker

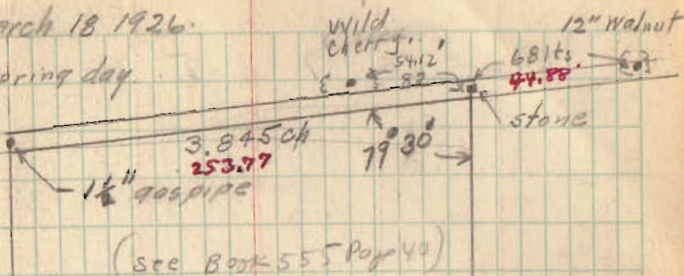

12 Acres

