

Addition To Murriny Site

- A - Iron Pin
- B - Stone
- AB - straight Line

Note!

Murriny site No 2  
did not include all land  
shown on this page.

614


INDEXED ON MAP

August - 14 1916

25

Wat.  
Wright  
Ed. Conc

Iron sec  
Book 390  
page 3  
for Reference

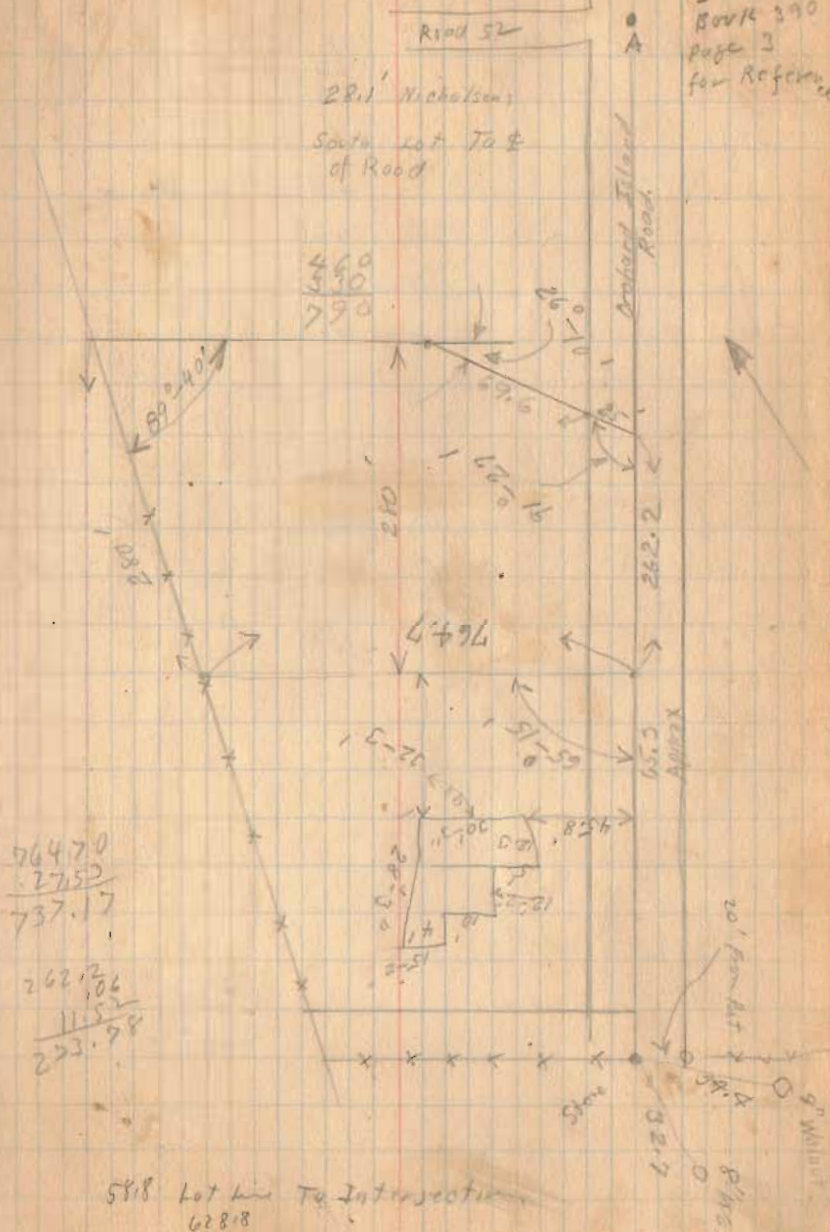

Aug 1924

26

Wright  
S. Wheeler

Lakeview City Building

	ts.	H.L.	-S.	Elev.
B.M.	5.26			
			5.88	
			6.30	
			5.92	
			6.50	

B.M. on Walk.

North	side	15'	W. of walk
"	"	65	" " "
South	"	65	W. " "
"	"	15	" " "

Levels taken on city lot.