


state Mon. Waterburg.

312
400
30
420
500
700
700

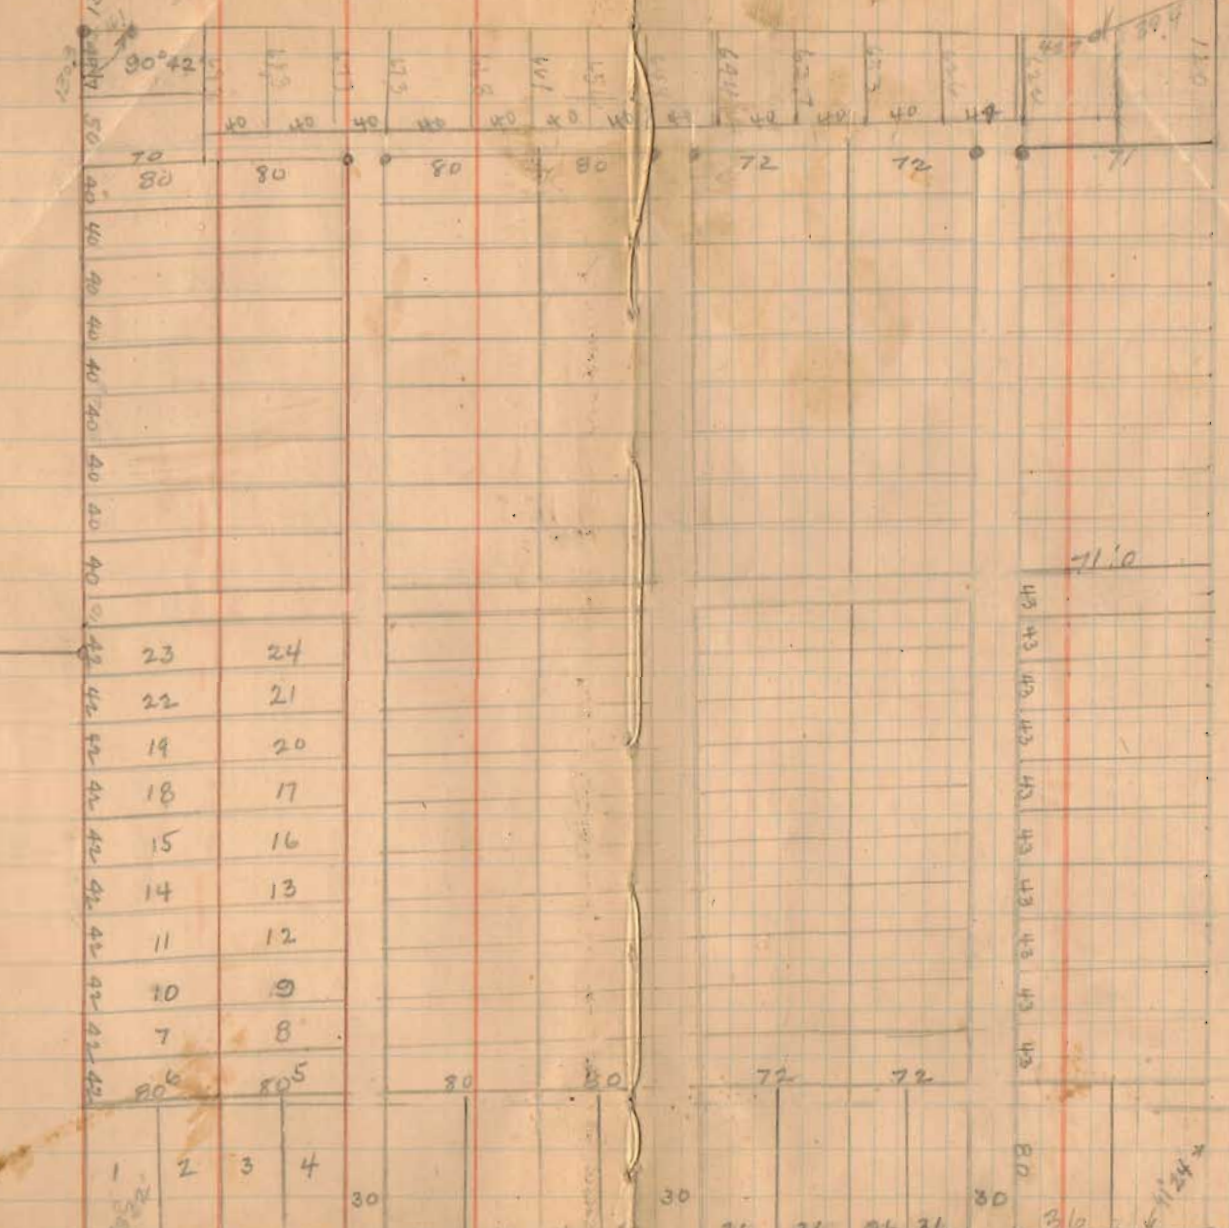

23 24
22 21
19 20
18 17
15 16
14 13
11 12
10 9
7 8
80⁶ 80⁵

1 2 3 4
30 40 40 40 40 40 36 36 36 36 30 36 36


6 June 9-10 1910
W.A. Montgomery
Ed Core
Frank Spain
Dr Waterbury

Montgomery
Wash. Temp

Cement Pavement

1000
 1500
 2000
 2500

Waterbury ✓ 8

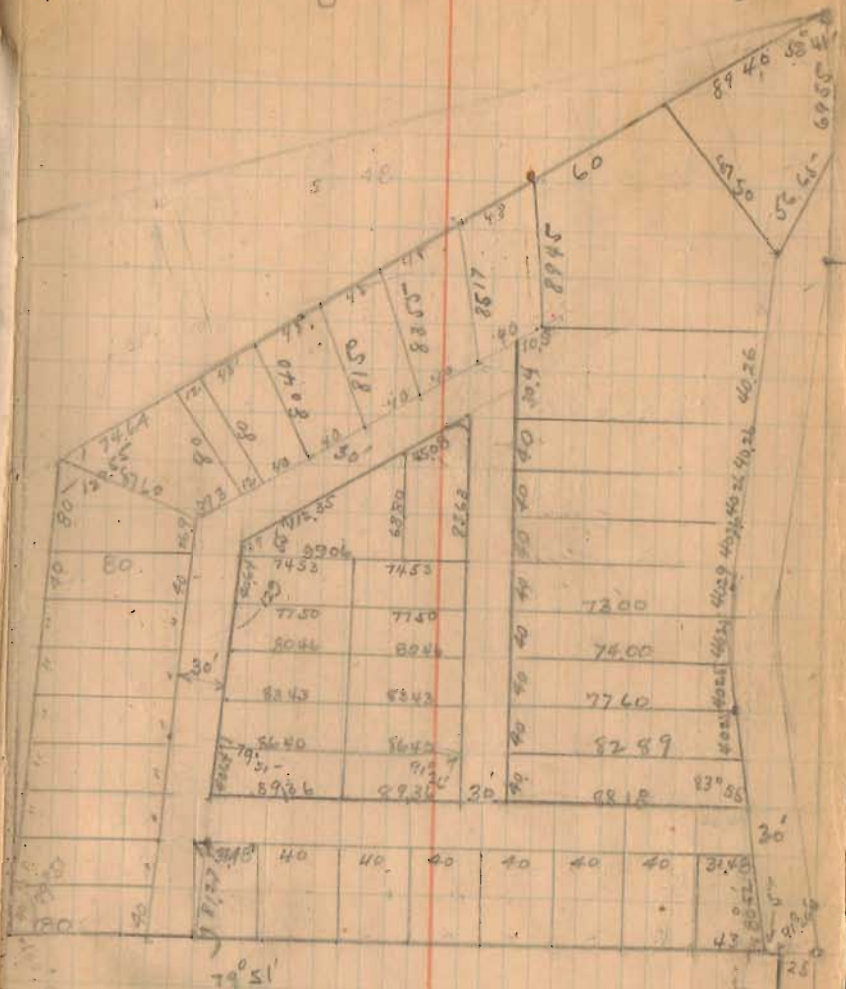

See Plot J-41