

Levels at Turkey Foot 7/13/38

F.H.V.	47.0	104.40		
WT 9/13/38	7	7.50	96.90	
		9.14	100.26	
Around IP at Cor.	312	104.18		
		318	101.00	
	489	105.99		

B = Stone found.

C = Post said to have been in place more than 21 years.

D = Stone found.

A = 1 P. n. 1 in diameter driven by Montg.

E = 1 1/2" IP

" " "

G = 3/4" bolt.

" " "

H = 1 1/2" Gas pipe

" " "

I = 1 1/2" " "

" " "

M = 1 1/2" " "

" " "

Sec = 1,104.1 } 725° 05' Sec 25 20 5T
 Tan 46.81 }
 Rosebrook } Ed Cora } 9/13 and 15/ }
 Chas Taylor } } 24 }
 W H Montgomery } } 24 }
 C } 1505.5 }
 A } 495.09 }
 ① 901.51 } ② 176.73 }
 ③ 57.55 } .160.81 }
 ④ 64.40 } 49.63 }
 ⑤ 305.43 } (4) }
 ⑥ 288.92 } (5) }
 ⑦ 269.67 } 249.2 }
 ⑧ 271.11 } (6) }
 ⑨ 161.1 }
 ⑩ 5306.7 }
 ⑪ 289.85 }
 ⑫ 271.13 }
 ⑬ 8 }
 ⑭ 251.57 } 151 }
 ⑮ (7) }
 ⑯ 201.11 }
 ⑰ 195.9 }
 ⑱ 42.3 }
 ⑲ 27.60 }
 Orchard Road }
 Pond Road }
 ⑳ 50.5 }
 ㉑ 56.03 }
 ㉒ 92.92 }
 ㉓ 19.93 }
 ㉔ 3.33 }

Gillen Water
Cynxma


P 1B
see: P 1B
1230

INDEXED ON MAP

The following described land situated in Sec. I, T.7, R.8,
Washington Township, Logan County, Ohio.

- No. 1 & 2 Beginning at an iron bolt 24.3 feet S. 24° 20' W. from a stone in center of the Orchard Island road (south) at the N.E. corner of Cynthia Gillenwater's 5½ acre piece; thence S.89° W. 337.5 feet to an iron pipe thence S.1° E. 67.8 feet to an iron pipe; thence N.89° E. 305.4 feet thence N.24° 20 E. 75 feet to place of beginning containing ¼ acre of which ½ acre is the same as described in deed from Cynthia Gillenwater to James Gillenwater, Recorded in Logan County deed records Vol. 129 Page 510.
- (3) Beginning at an iron pipe 99.3 feet S.24° 20 W., from a stone in center of Orch rd Island road (south) at the N.E. corner of Cynthia Gillenwater's 5½ acre piece; thence S.89° W.305.4 feet to an iron pipe; thence S.1° E. 30.8 feet to an iron pipe; thence N.89° E. 288.0 feet to an iron pipe thence N.24° 20 E. 40.6 feet to the beginning containing ¼ acre.
- (4) Beginning at an iron pipe 139.9 feet S.24° 20' W., from a stone in center of the Orchard Island road (south) at the N.E. corner of Cynthia Gillenwater's 5½ acre tract; thence S.89° W. 288.0 feet to an iron pipe; thence S. 1° E. 38.9 feet to an iron pipe; thence N. 89° E. 269.6 feet to an iron pipe; thence N.24° 20 E. 43.1 feet to the beginning containing ¼ acre.
- (5) Beginning at an iron pipe 183.0 S. 24 ° 20 W. from a stone in center of the Orchard Island road at the N.E. corner of Cynthia Gillenwater's 5½ acre tract; thence S. 89° W. 269.6 feet to an iron pipe; thence S. 1° W. 41.7 feet to an iron pipe; thence N. 89° E. 249.8 feet to an iron pipe; thence N. 24° 20' E. 46.2 feet to place of beginning containing ¼ acre.
- (6) Beginning at an iron pipe 469.5 feet S. 24° 20' W. of a stone in center of Orchard Island road (south) at the N.E. corner of Cynthia Gillenwater's 5½ acre tract; thence S. 89° 15' E. 306.7 feet to an iron pin in the section line; thence S. ¾° E. 36.5 feet to an iron pipe, thence N.89° 15' W. 289.8 feet thence N. 24° 20' E. 40.3 feet to the beginning containing ¼ acre.
- (7) Beginning at an iron pipe 509.8 feet S. 24° 20' W. of a stone in center of Orchard Island Road (south) at the N.E. corner of Cynthia Gillenwater's 5½ acre tract; thence S. 89° 15' E. 289.8 feet to an iron pipe in Section line; thence S. ½ E. 38.9 feet to an iron pipe thence N.89° 15 E. 271.7 feet to an iron pipe thence N.24° 20' E. 43.0 feet to the beginning containing ¼ acre.
- (8) Beginning at an iron pipe 552.8 feet S.24° 20' W. of a stone in center of Orchard Island road (south) at the N.E. corner of Cynthia Gillenwater's 5½ acre tract; thence S. 89° 15 W. 271.7 feet to an iron pipe in section line; thence S. ¾ E. 41.7 feet to an iron pipe thence N.89° 15 E. 251.6 feet to an iron pipe thence N.24° 20' E. 46.0 feet to the beginning containing ¼ acre.
- (9) Beginning at an iron pipe 598.8 feet S.24° 20' W. of a stone in center of Orchard Island Road (south) at the N.E. corner of Cynthia Gillenwater's 5½ acre tract; thence S.89° 15' W. 251.6 feet to an iron

pipe in Section line; thence S. $\frac{3}{4}$ E. 95.0 feet to an iron pipe at the North line of a 25 $\frac{1}{2}$ lane thence N. $89^{\circ} 15'$ E. with said land 207.1 feet to an iron pipe in center of Orchard Island road; thence N. $24^{\circ} 20'$ E. with said road 104.9 feet to place of beginning containing $\frac{1}{2}$ acre of which $\frac{1}{2}$ acre is the same as deeded to Iva Rosebrook in Logan County deed records Vol. Page .

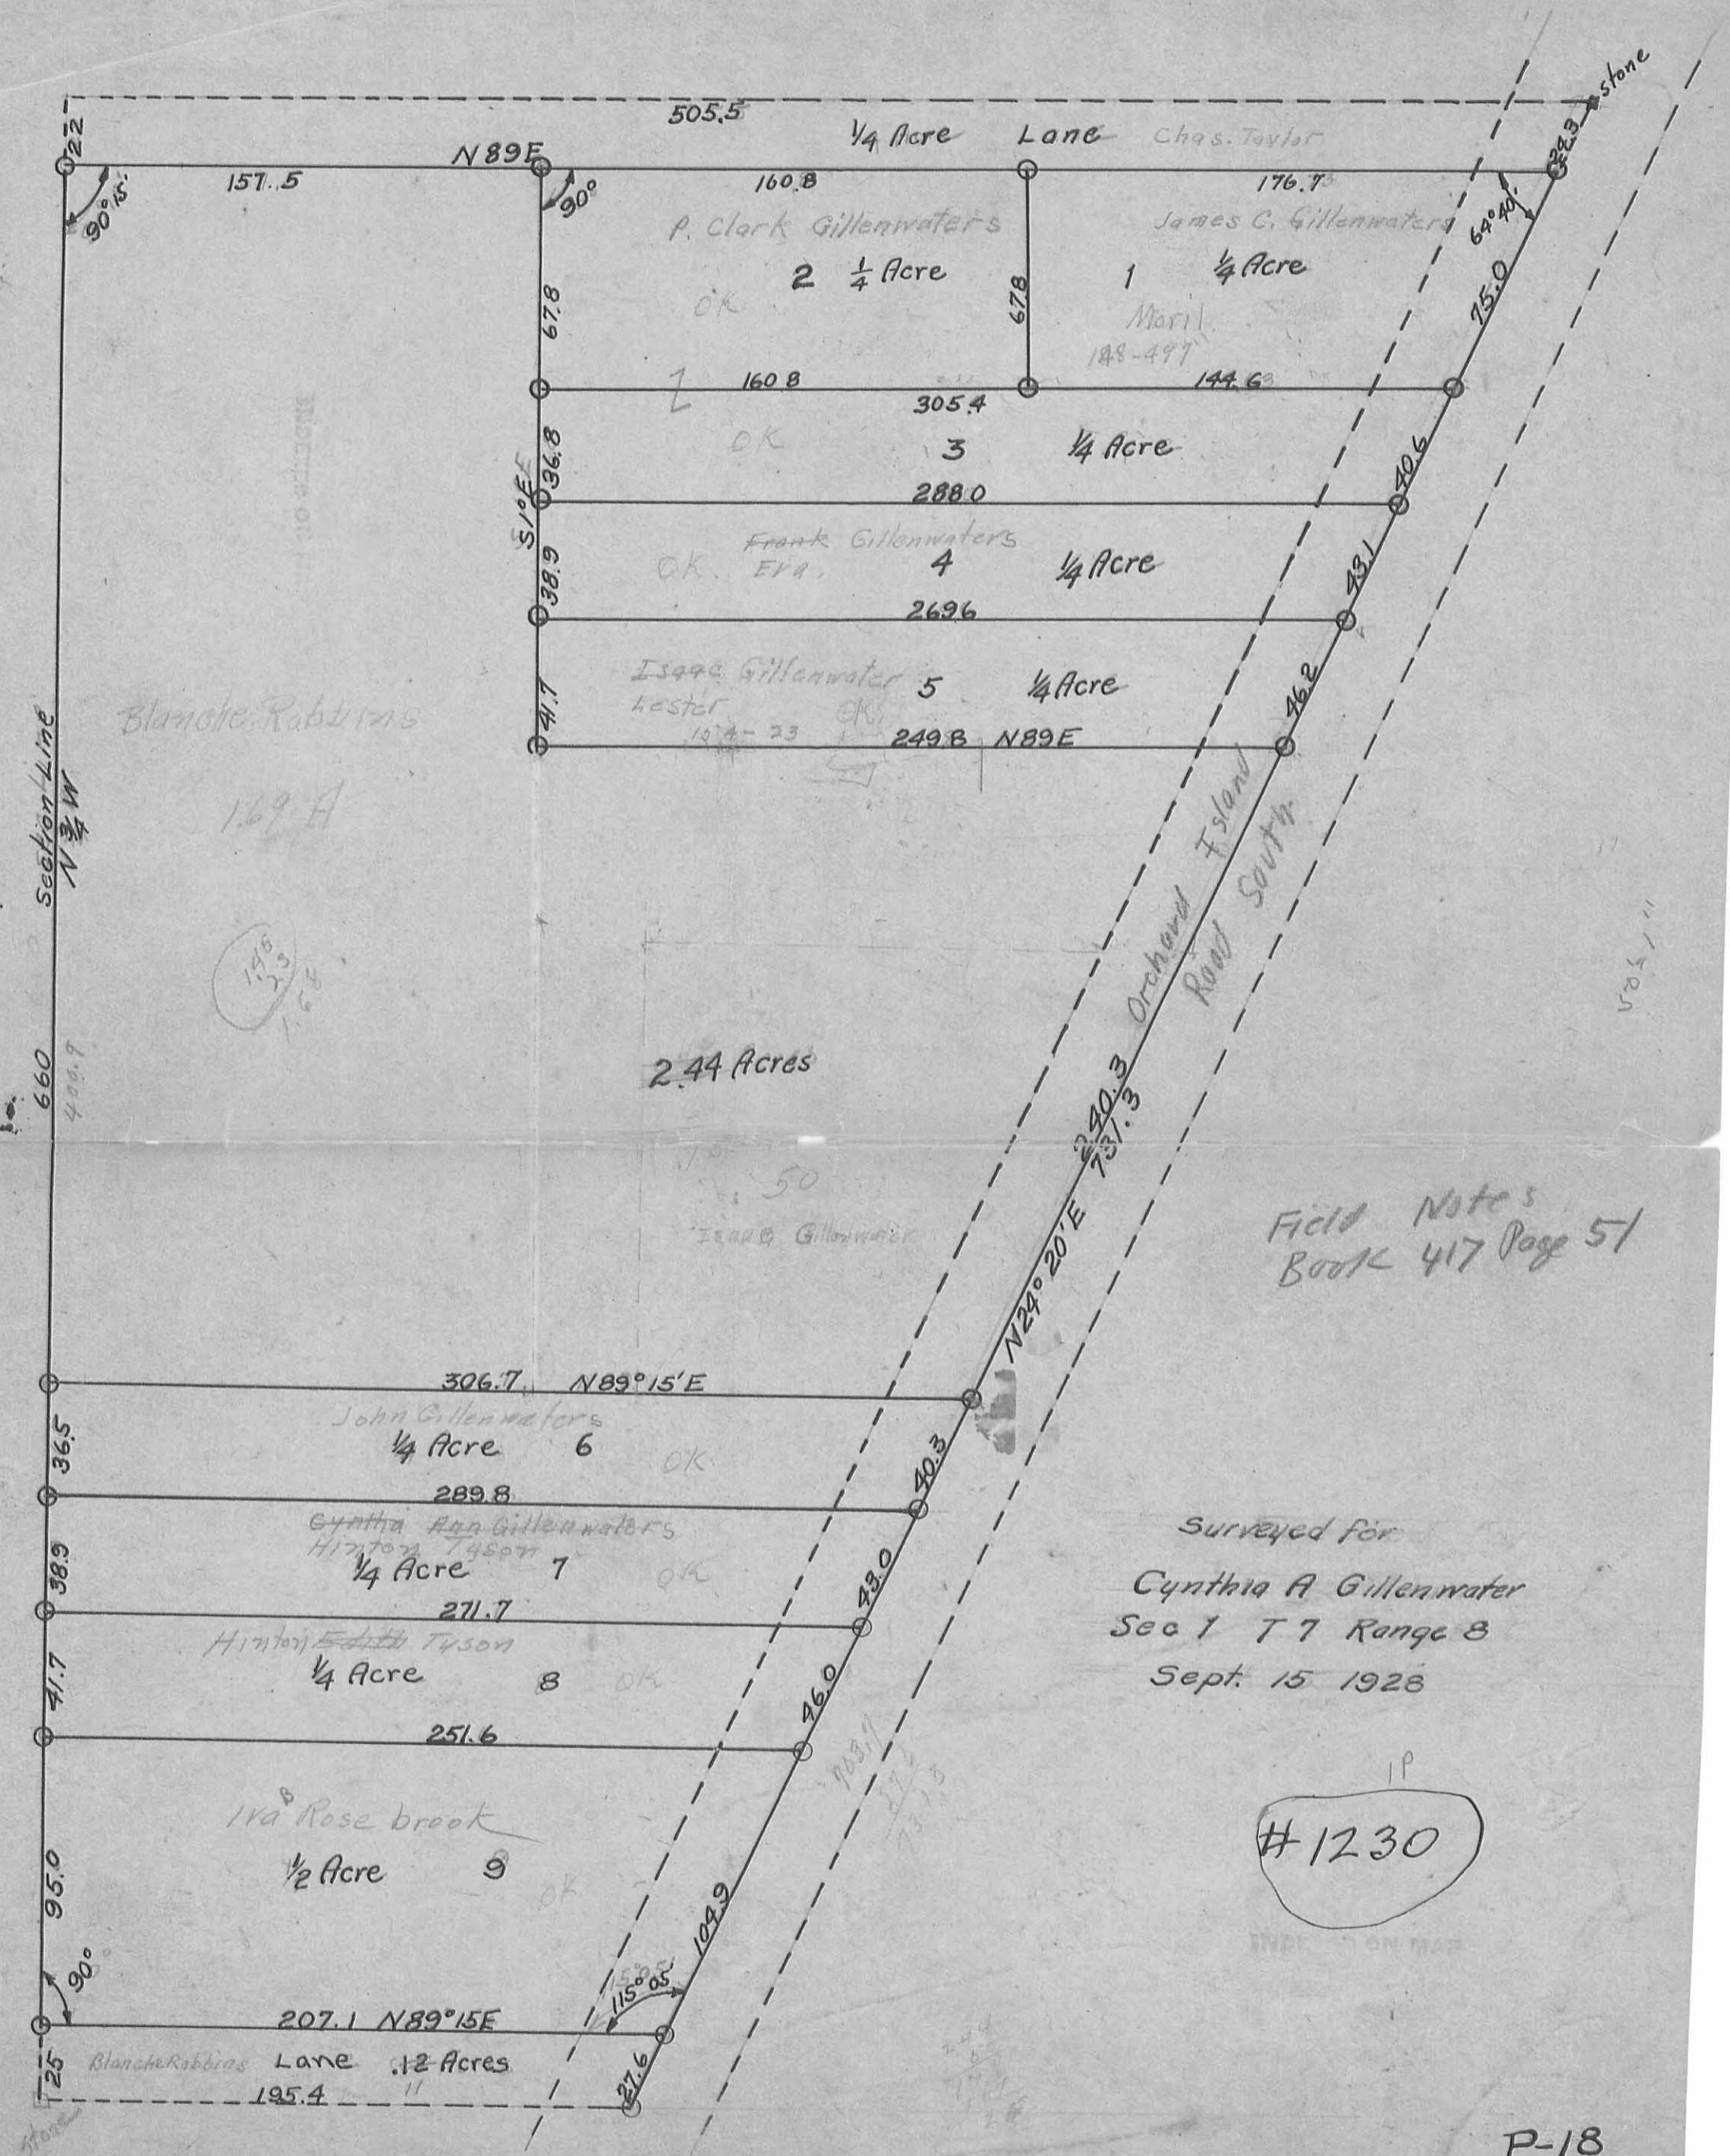

7/8" pipe
Found

0.5' 0.5'

0.5'

Shultz Survey
Washington Township ...
(Gillenwater Tract)
See Plot P-18 & File No. 1230
Co. Eng. Office

7/8" Iron
Set

66.26

50
60
50
50
50

3/4" pipe
Found

7/8" Iron
Set

114.5'

306.7 Deed

Guy Shultz 0.25 A.

289.8 Deed

3/4" pipe
Found

INDEXED ON MAP
1230

D. Dodson
L. Gieslin

9/1/56
201-

24

240.8 Deed

Iron pin
Found
1/2"

181.1 Deed

Guy Shultz
0.50 A.

1/2" Iron
Pin found
110.0 meas
(110.5 Deed)
(176.26 Deed)

Guy Shultz

1/2" Iron
Found

3/4" pipe
Found

3/4" pipe Found (bent)
replaced with 7/8" Iron
driven on angle


7/8" Iron
Set

27.00'

Shultz Survey
Russell point

9/1/56
Dobson
Garrison

43

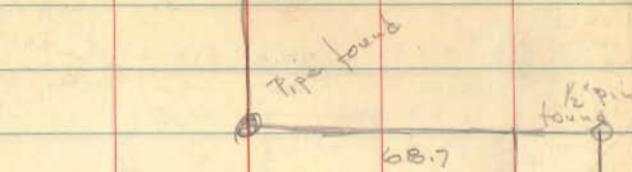

See Plan P-18

Index No. 1230

(Gillenwater tract)

Set $\frac{7}{8}$ "
Iron
 (66.26)
65.76'

110.0
110.5

176.26

($\frac{1}{2} \times 5.3$)
 $\frac{1}{2} \times 5.3$

$\frac{1}{4}$ " Iron
Found

176.26
110.50
65.76

110.64
125.
55320
22128
27.6600

Pipe
Found

Set $\frac{7}{8}$ "
Iron
Snow
306.7

1445

($\frac{1}{2} \times 5.3$)
 $\frac{1}{2} \times 5.3$

$\frac{1}{4}$ " pipe
found

15.
10.

Pipe
Found

found $\frac{1}{4}$ " pipe (bent)

Set $\frac{7}{8}$ " Iron
(driven in angle)

INDEXED ON MAP

1230

DESCRIPTION OF THE LAND:

Being part of Sec 1-T7-R8 Washington Twp, Logan County, Ohio and being more fully described as follows:

Beginning at the intersection of the southernmost corporation line of the Village of Russells Point, Ohio and the section line between Sec 1-T7-R8 and Sec 2-T7-R8, said point of intersection also being the south west corner of the corporation of the village of Russells Point, Ohio; thence in a southerly direction along said section line between Sec 1-T7-R8 and Sec 2-T7-R8 a distance of 22 feet to an iron pipe; thence N 89°15' E parallel to the said southernmost corporation line of the Village of Russells Point, O. a distance of 318.3 feet to an iron pin, which pin is the true place of beginning of this tract; thence continuing N 89°15' E 176.7 feet to an iron pin in the centerline of St 869, St 708, passing an iron pin at 149.05 feet; thence with the center of said St 708 S 24°35' W a distance of 75.0 feet to an iron pin; thence S 89°15' W a distance of 144.6 feet to an iron pin crossing an iron pin at 27.65 feet; thence N 0°45' W a distance of 67.8 feet to the true place of beginning. Said tract contains 0.25 acres more or less.

The above description is a true representation of a survey made by me on February 27, 1954.

William H. Lewis Surveyor-in-charge

Attest:

W. H. Lewis

Feb 2002

INDEXED ON MAP
1230