

# Hicks Survey

Lots 27-28-29-30

See Page 40-65

A - Old Hub Found

B - Old Hub Found. Placed  $\frac{3}{4}$ " Bolt Head Down

C - Old Hub Found

D - Old Hub Found. Placed  $\frac{3}{4}$ " Bolt Head Down

E - Nail in root of tree found

F. Placed Hub,

G. Hub Found

H. Hub Found.


1253

INDEXED ON FILE

Feb. - 6 - 1931

Windy  
Wright  
Mr. Hicks  
Bill Wright.

44

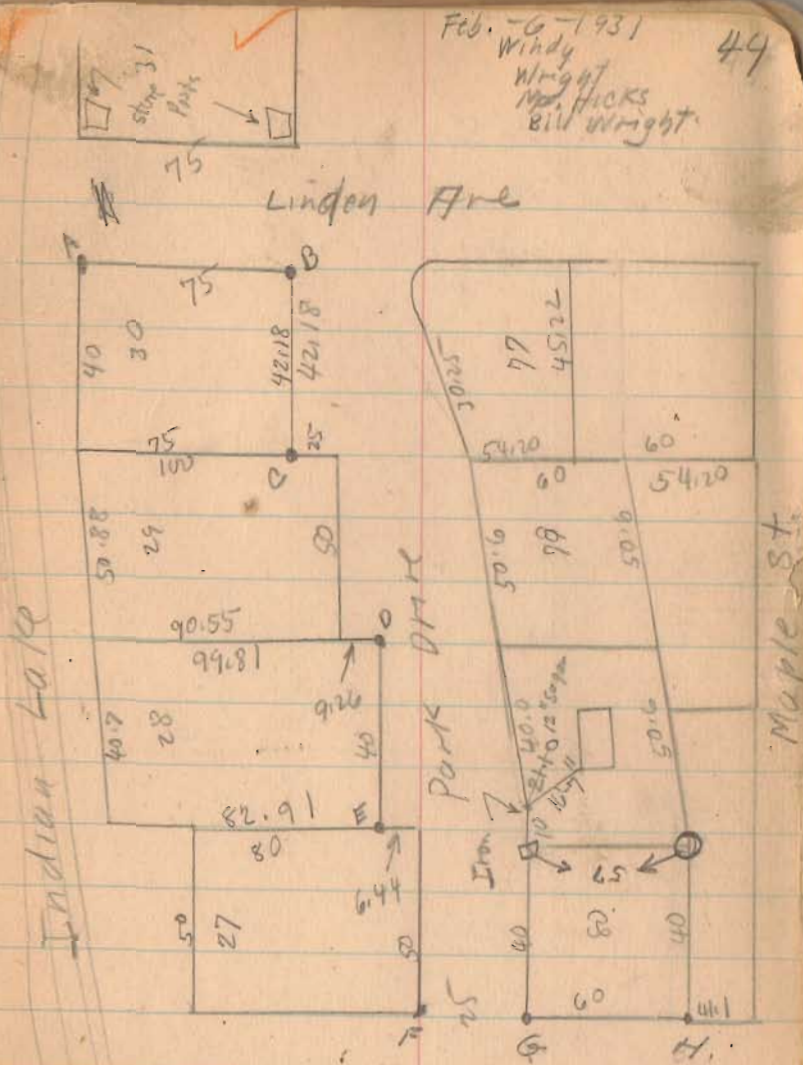

(over)

Hickes Survey Continued

INDEXED ON MAP  
1253

Stake Relocate  
July-18-1934  
F. Wright  
W.R. Wright

2-6-31

45

(See Page 44)

