


Orchard Island.

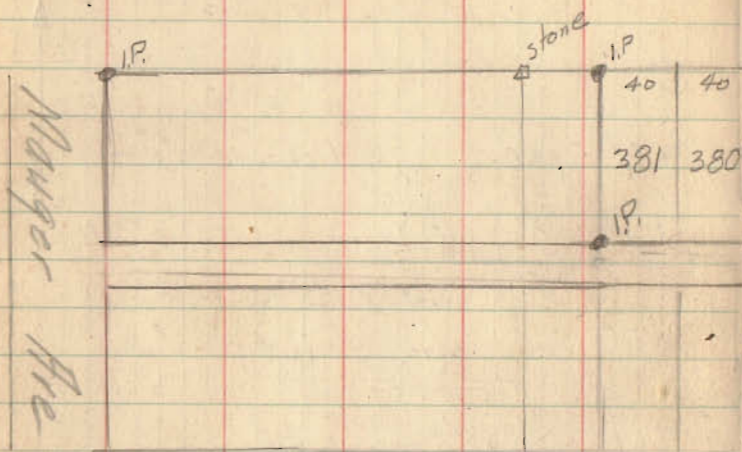

The I.P. found at Lot 379 on Auditorium was 0.5 to far south when measured from Conc marker at NE corner of 428. This marker conformed to old stks found.


1490

INDEXED ON MAP

Oct 31 1925

W H Montgomery  
Harry Kilgore

Auditorium street

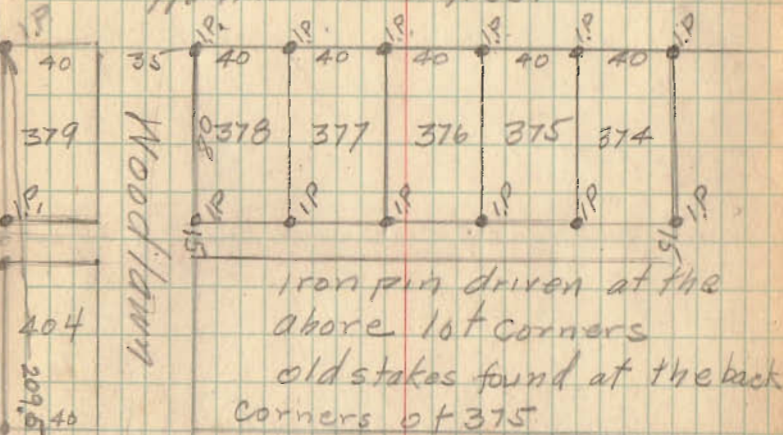

iron pin driven at the above lot corners  
old stakes found at the back corners of 375

Crescent St.

Conc. Marker  
old stk  
40

428

35'

Ave

conc. marker

Post

462

463