

Road. 91

Washington Top

50' Road. Lewistown New Hampshire Pike

Stake placed 25' from ϕ for 50' Road.

1585
INDEXED ON MAP

July - 13 - 1934

Clear - warm

Wright

J. Montgomery

56

LEWISTOWN

Road. No. 54

Road. 54

Road 91

Road. 91
see BOOK 552
Page 41

Road. 91

Status set for

Mr. House

March -20, 1905

F. Wright

E. care.


1585

INDEXED ON MAP

Road 91

7-10-39


54

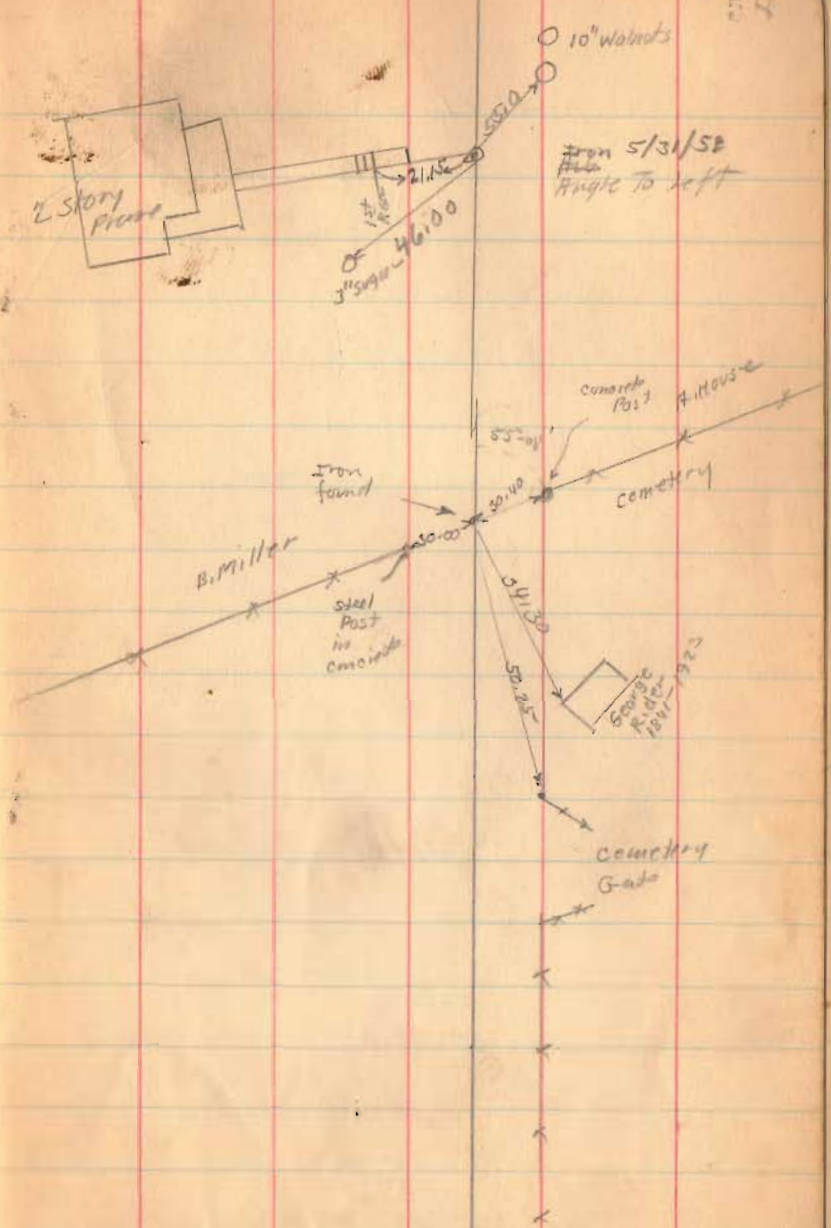

585

INDEXED ON MAP

Road 91

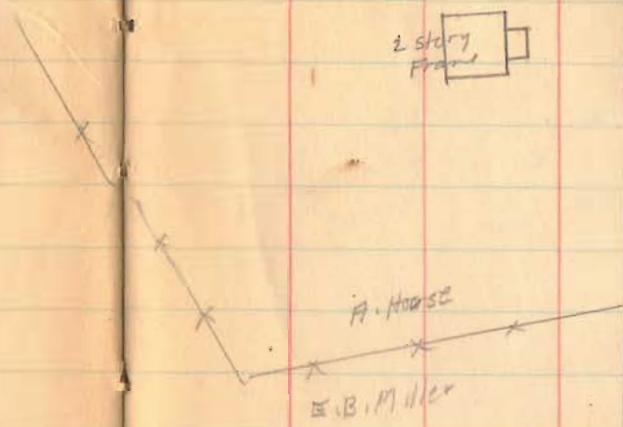

1585


INDEXED ON MAP


Road 91

1585
INDEXED ON MAP

7-13-34

60

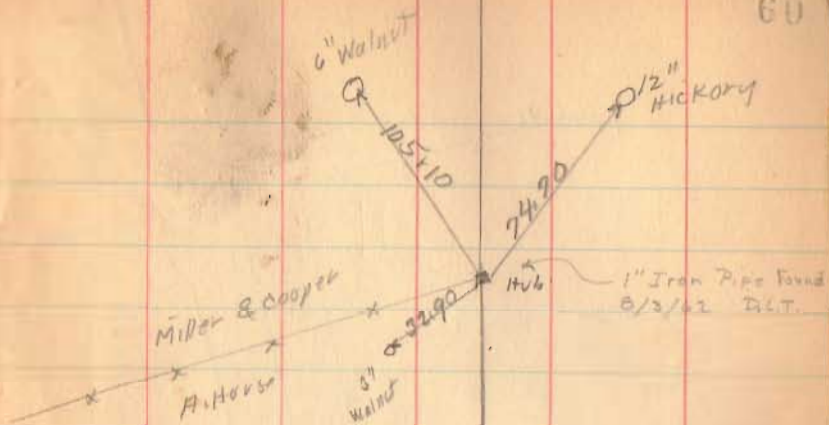

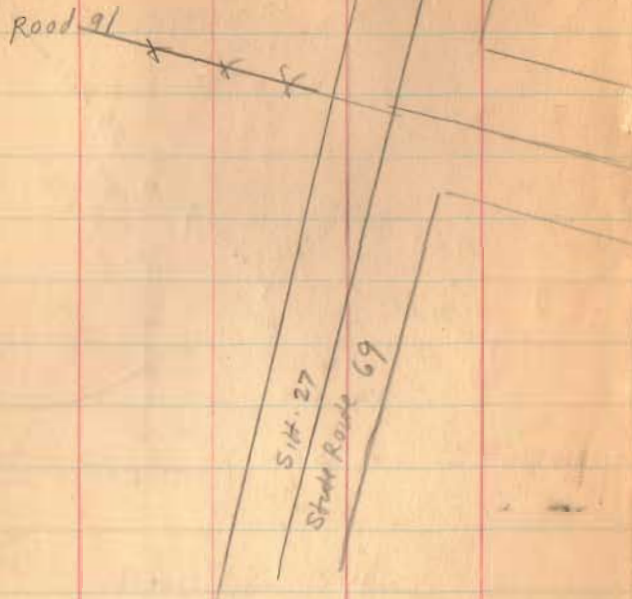

SURVEY FOR METHODIST CHURCH

PARTY: D. TEVIS AUG. 3, 1962
 T. TILLMAN
 D. RICKETTS 85°

R. P. ROTHMAN TO LEWISTOWN METHODIST
 CHURCH - 0.62 AC.

1585

INDEXED ON MAR

