



Orchard Island.  
Park near lot 52

- Irons
- Hubs

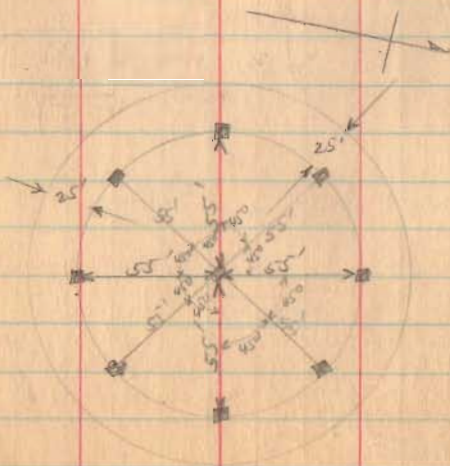

April - 6 - 1933  
Snow - Wind  
Bad day  
F. Montgomery  
E. Core  
J. Montgomery

32

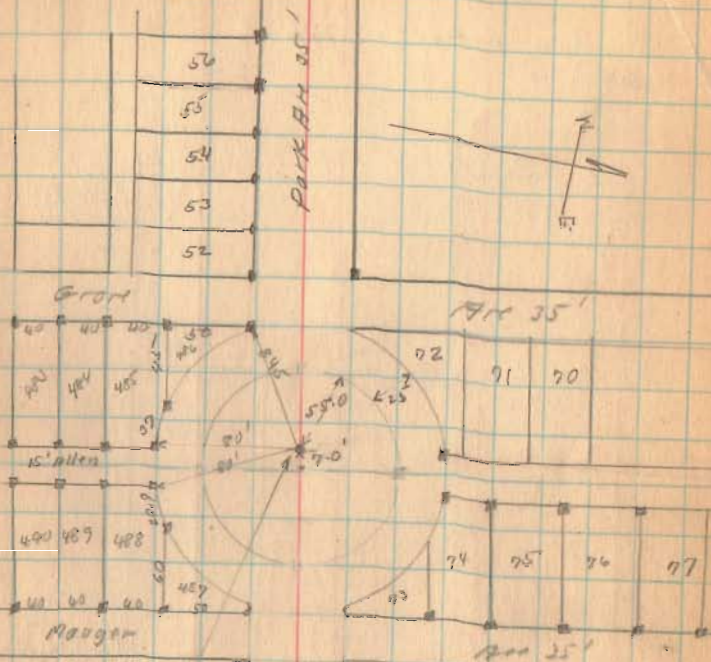

2" Iron center  
of circle  
Poor scale.  
710' from E  
alley and on  
E Park Ave.

$$D = 55' = 2376' \\ .05 \text{ Acres}$$

1650  
INDEXED ON MAP