


INDEXED ON MAP

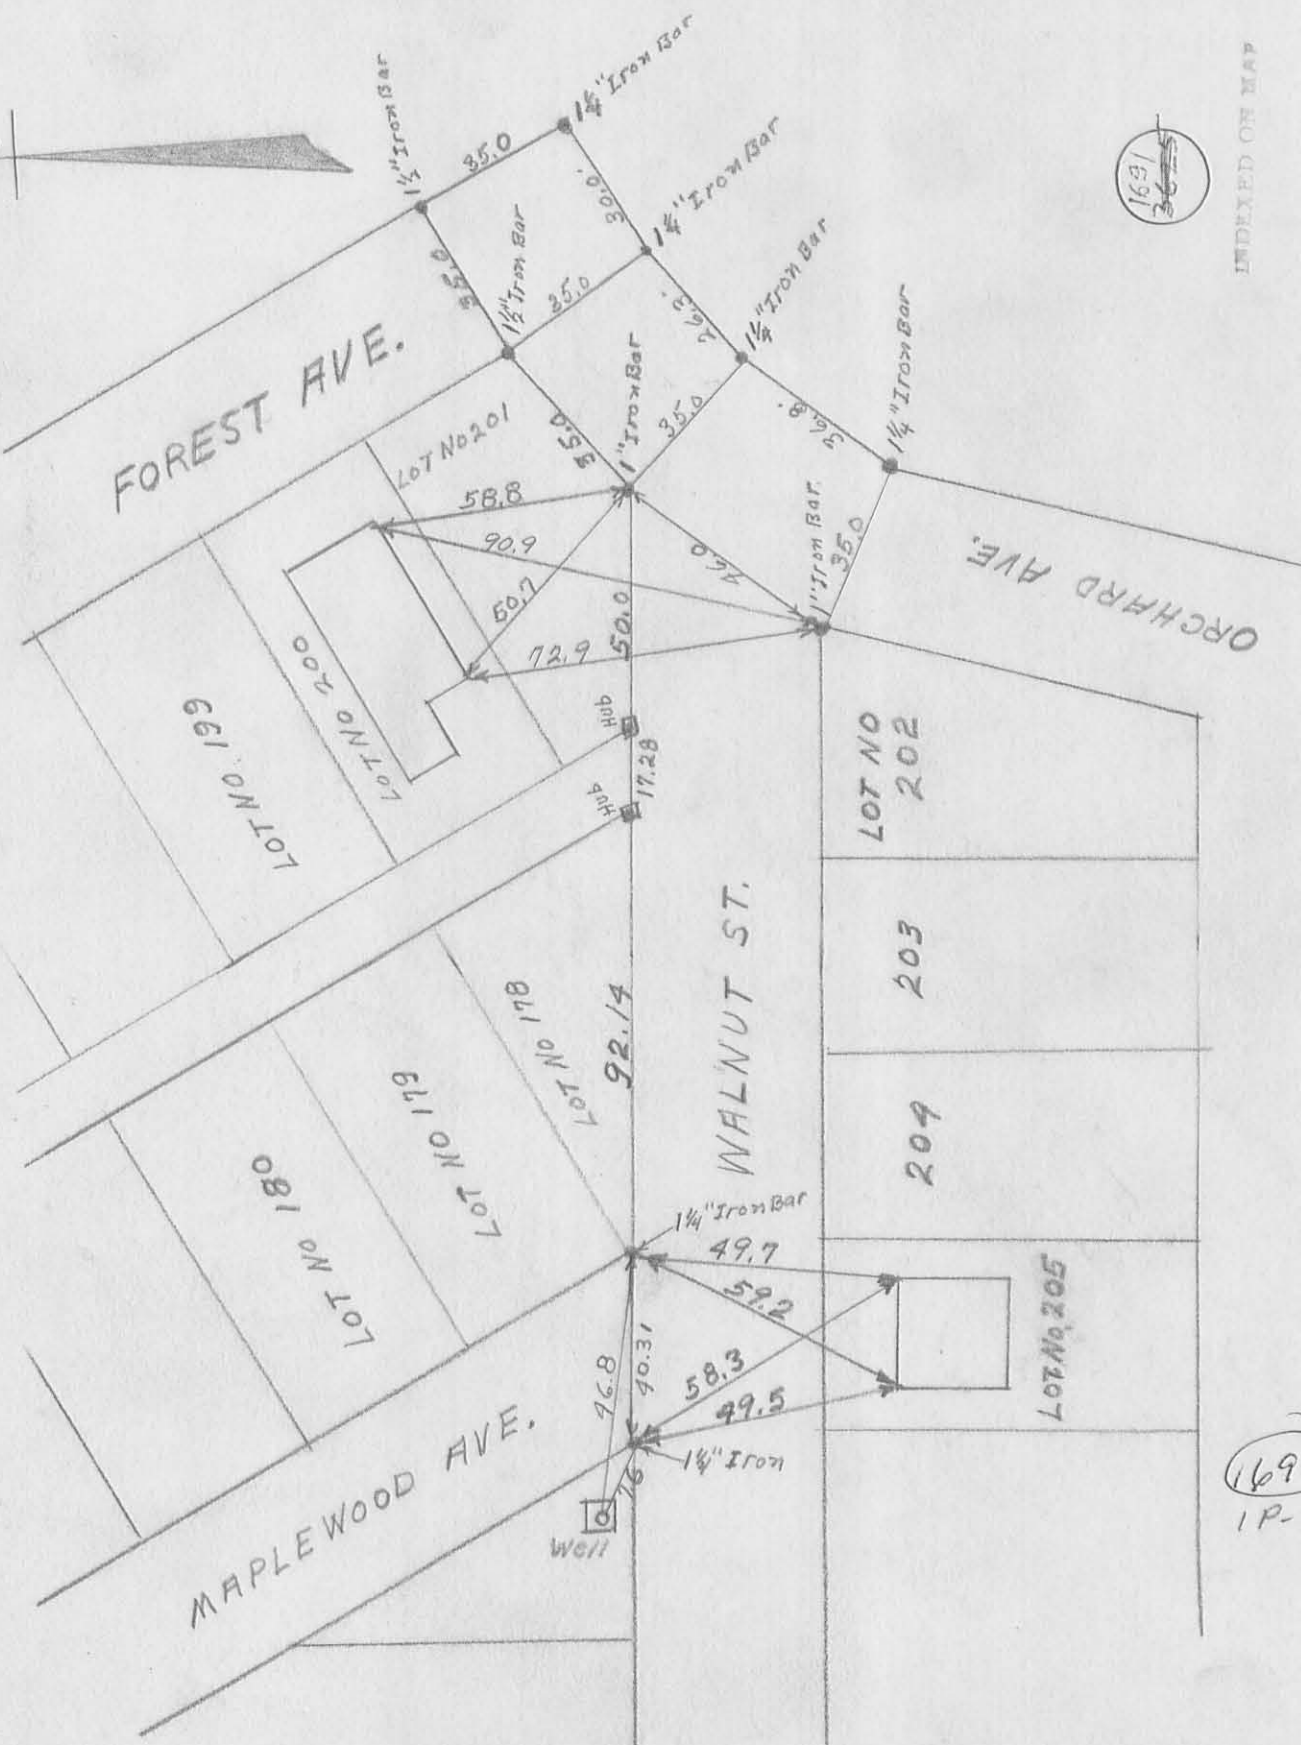

MAPLEWOOD AVE. WALNUT ST FOREST AVE & ORCHARD AVE.

1691
1P-13



PINE ST.

1/4" Iron Bar

34.1

58.6

70.51

13.4

12.7


1/4" Iron Bar

MAPLEWOOD AVE


MAPLEWOOD AVE. & PINE ST.

169
~~378~~
1P-14

INDEXED ON MAP

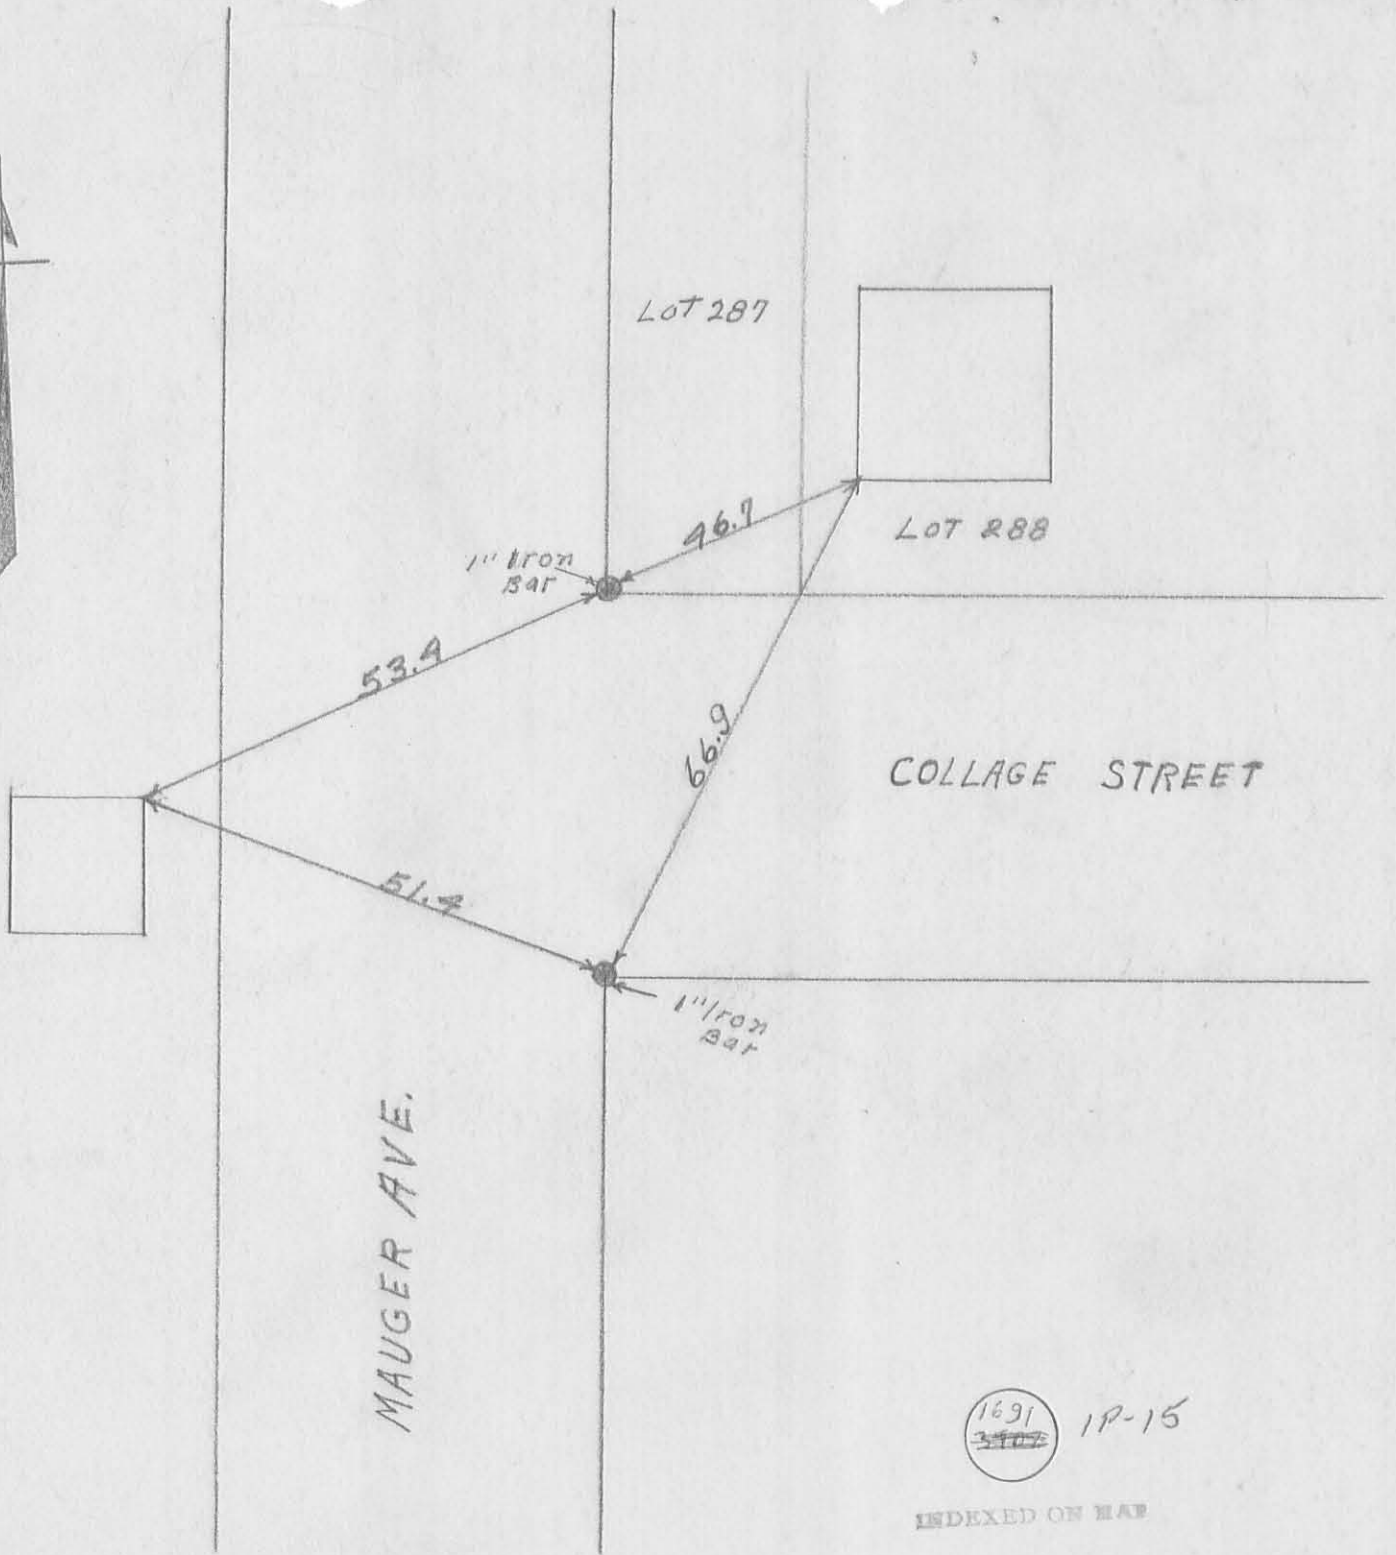

MAUGER AVE. ^{9th} COLLAGE STREET.

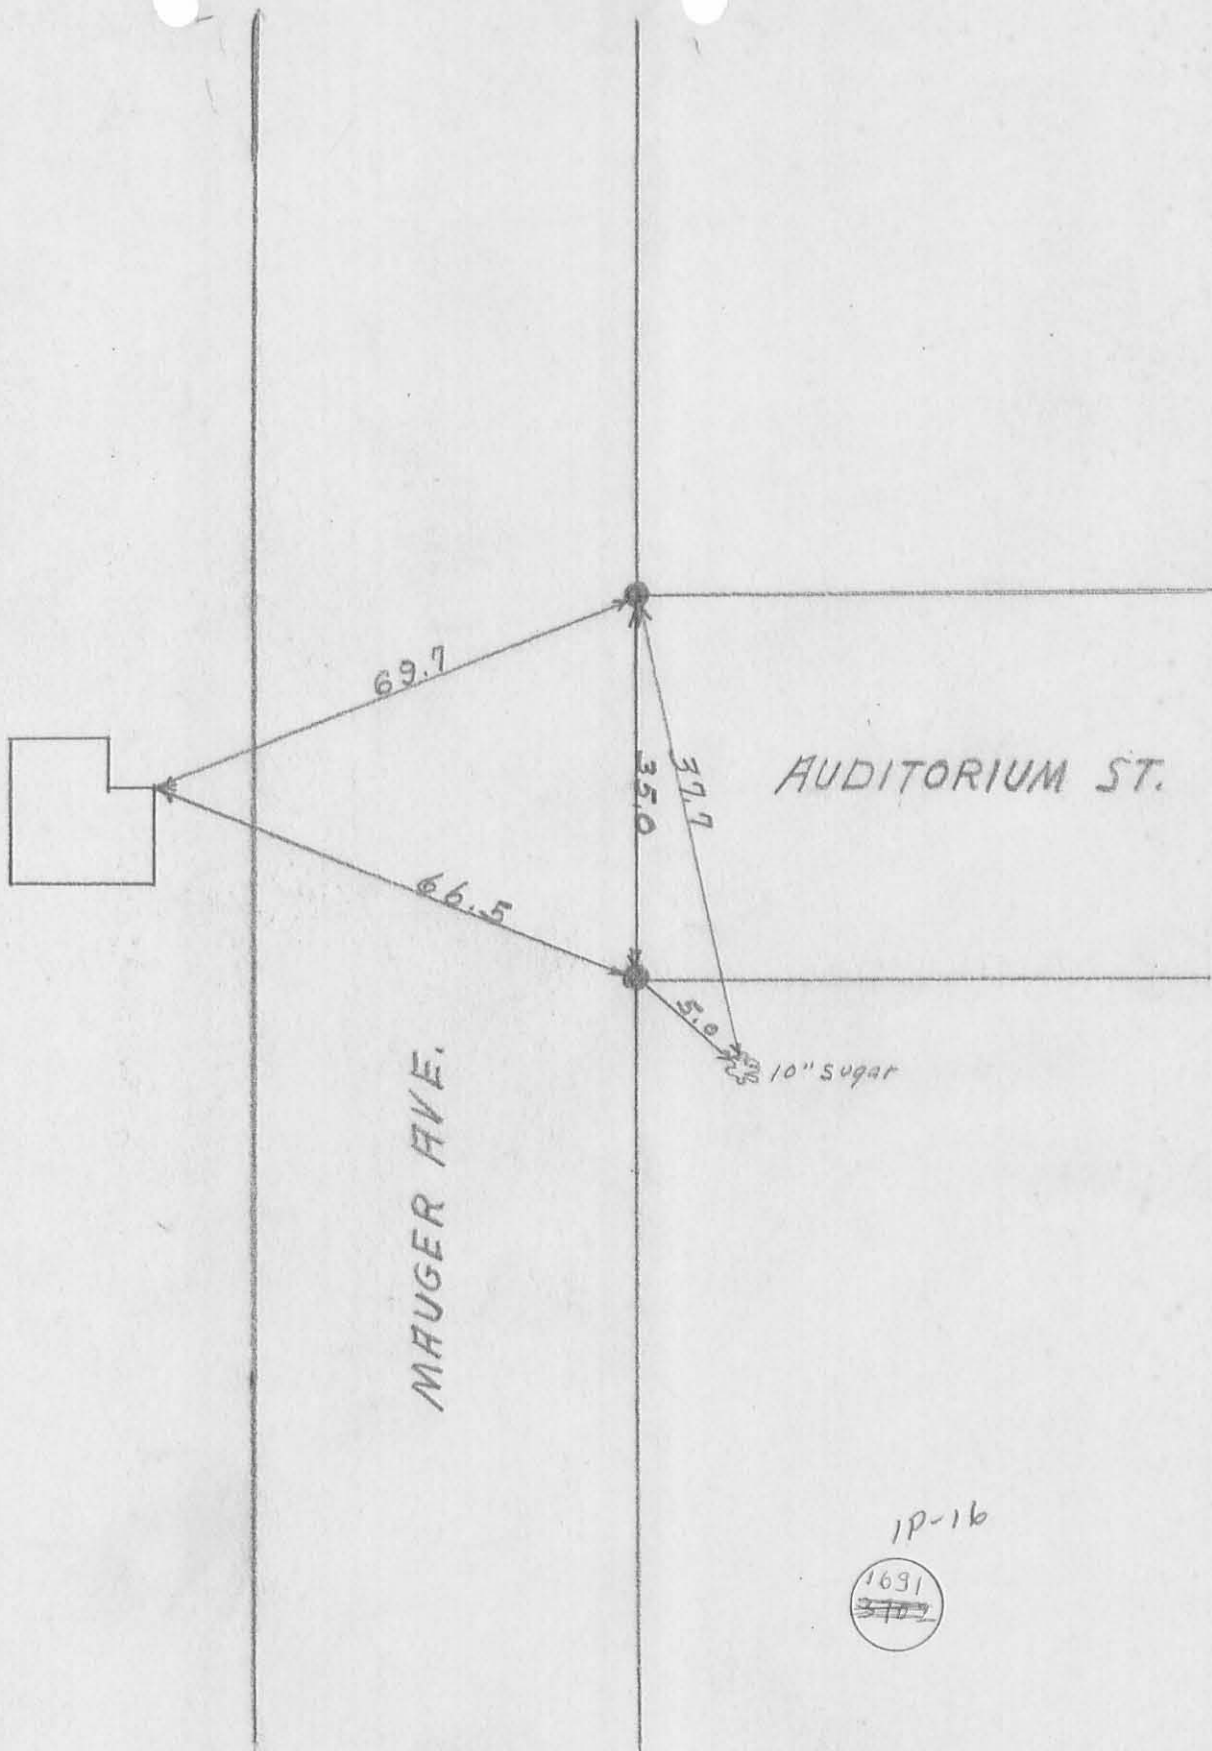

1P-16



MAUGER AVE. Rd AUDITORIUM ST



MAUGER AVE.

Justamere House

Patty Cushman

CRESCENT ST.

1/2" Iron Bar

1/2" Iron Bar

57.85

49.8

26.8

59.5

1691
~~5710~~


1P-17

INDEXED ON MAP

MAUGER AVE. ^{Pub} CRESCENT ST.



WALNUT ST.

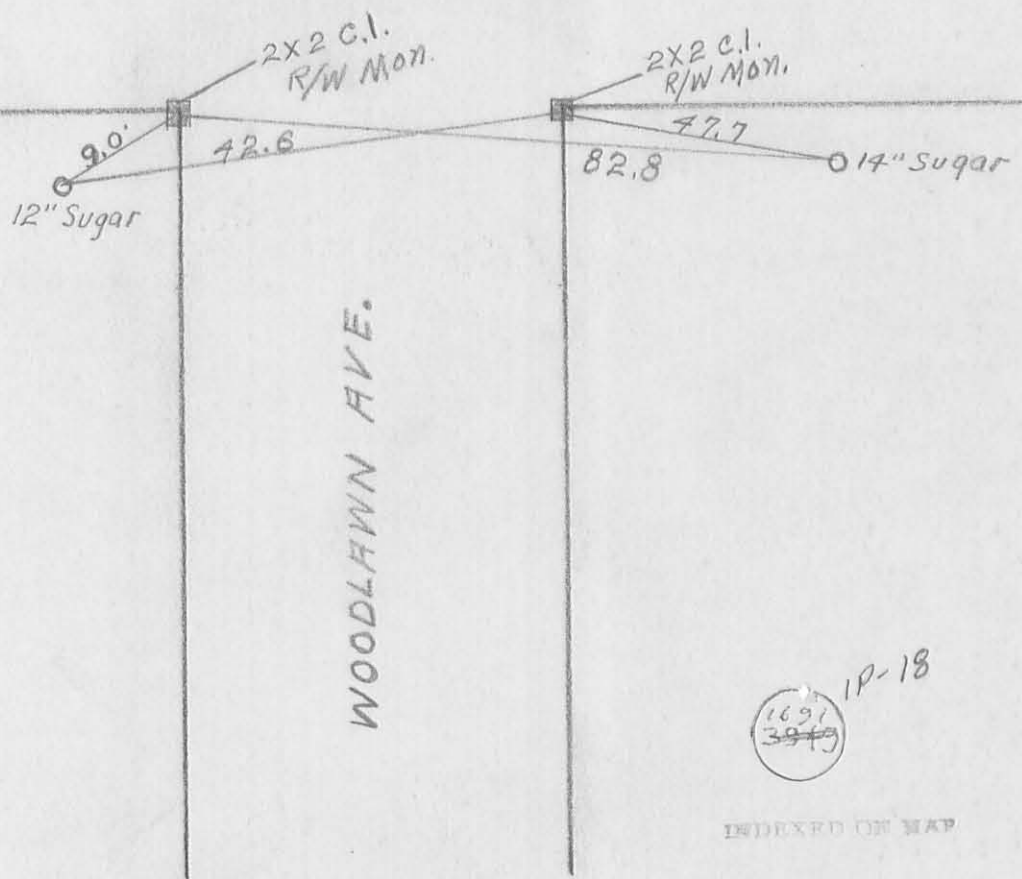


WOODLAWN AVE.

1691
3949
1P-18

INDEXED ON MAP

WOODLAWN AVE. ^{plus} WALNUT ST.

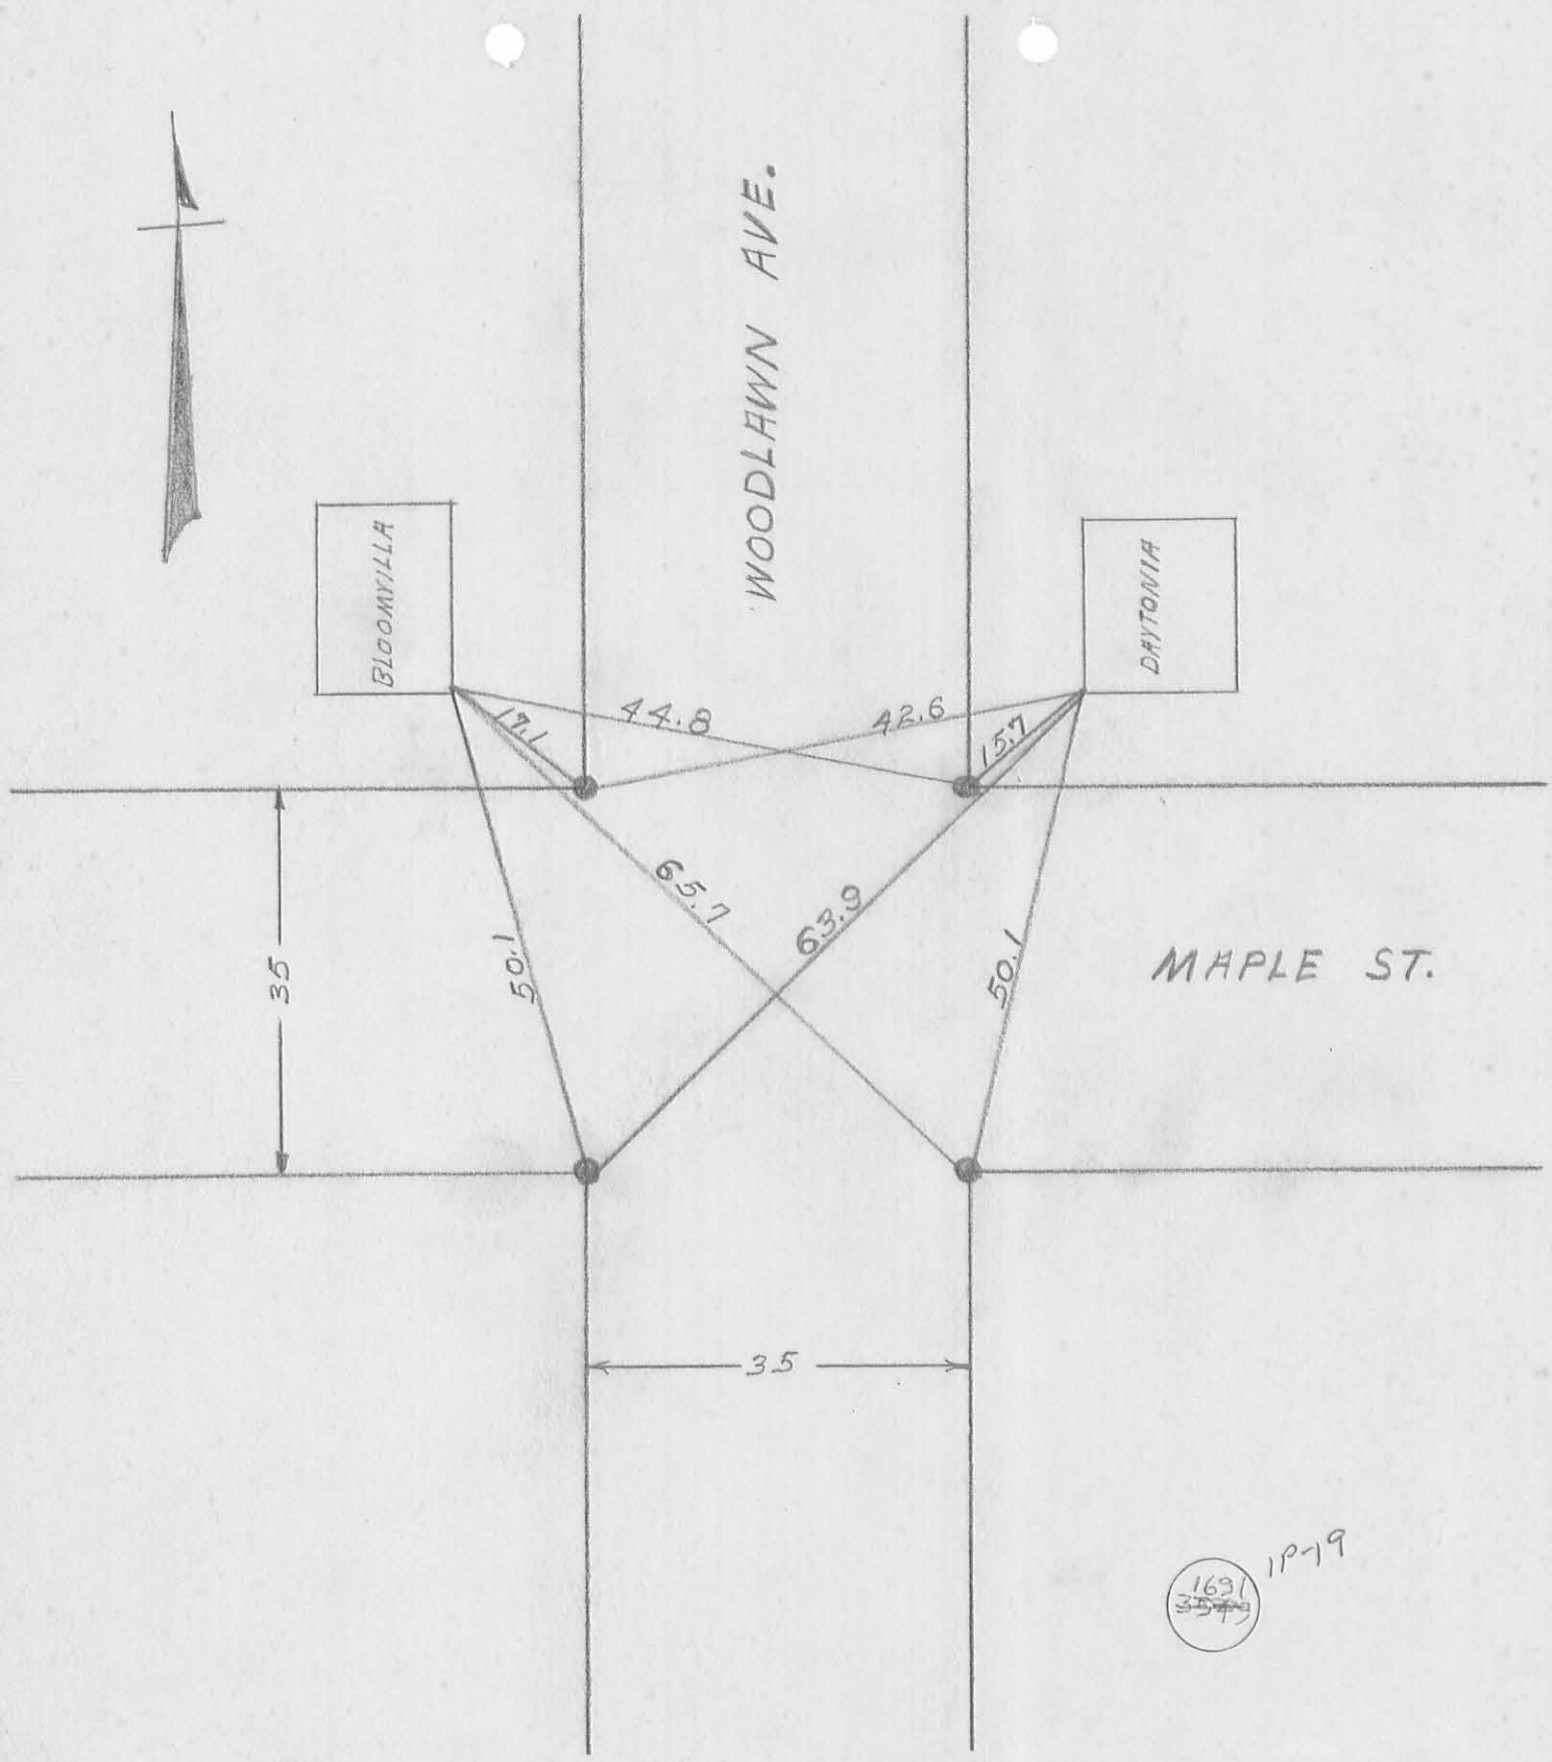

BLOOMVILLA

WOODLAWN AVE.

DAYTONIA

MAPLE ST.

WOODLAWN AVE. ^{At} MAPLE ST.

1631
~~3579~~
1P-79



Venture Inn

LOT NO. 403

LOT NO. 404

LOT NO. 405

LOT NO. 406

80.7'
77.3'

3/4" Iron Bar

86.6'
52.8'

1 1/2" Iron Bar

98.6'

94.8'

100.0'

73.0'

CRESCENT ST.

1" Iron Bar

1" Iron Bar

WOODLAWN AVE.


1691
3949
IP-20

INDEXED ON MAP

WOODLAWN AVE. ²/₂ CRESCENT ST.




WOODLAWN AVE.

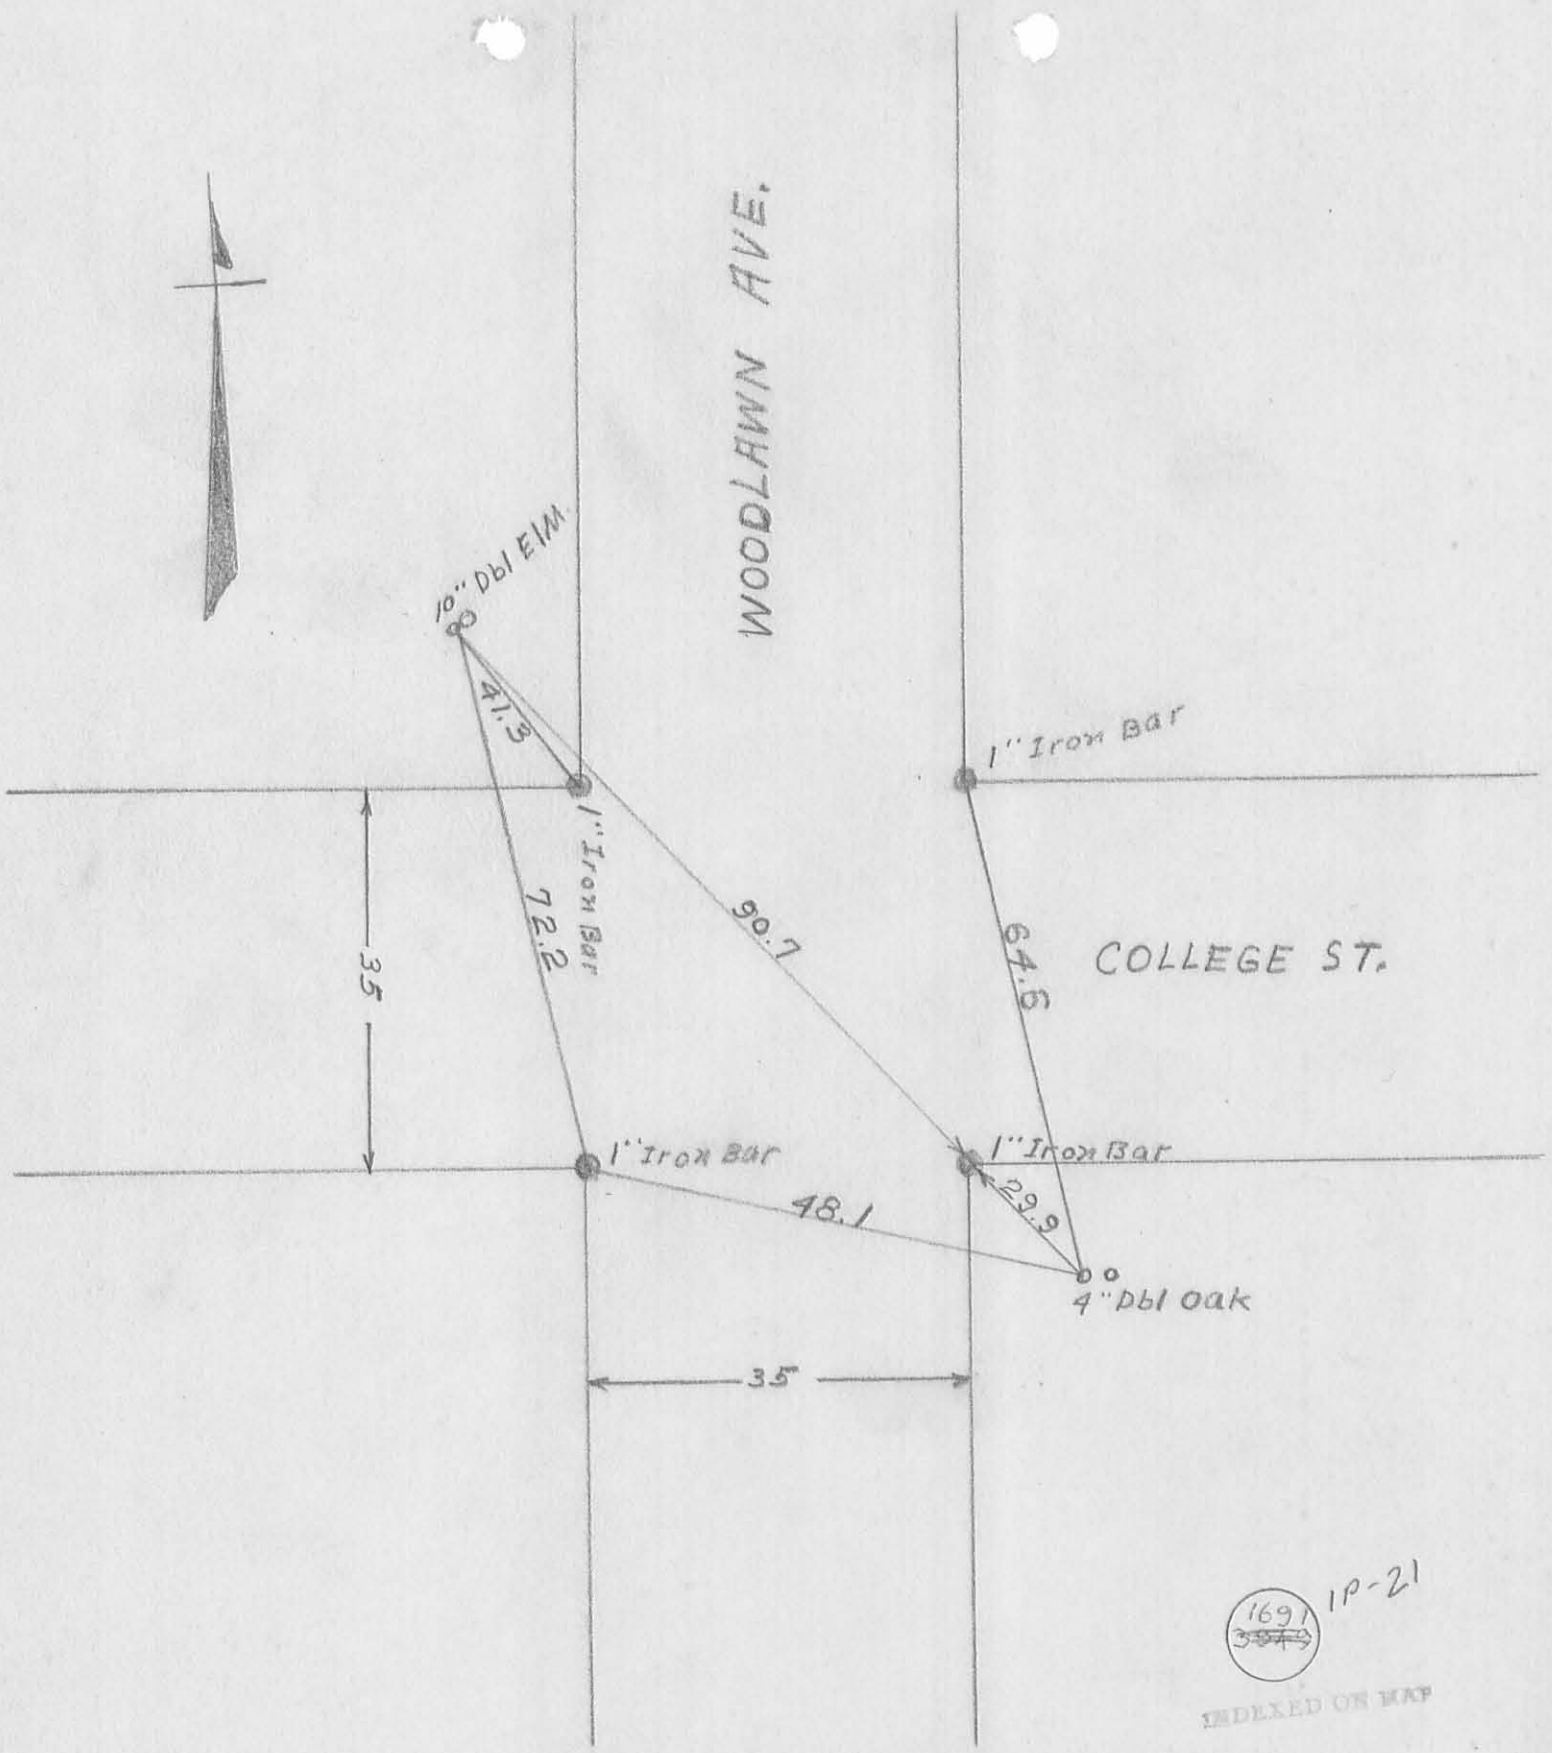

COLLEGE ST.

WOODLAWN AVE. & COLLEGE ST.

1691
~~397~~
1P-21
INDEXED ON MAP

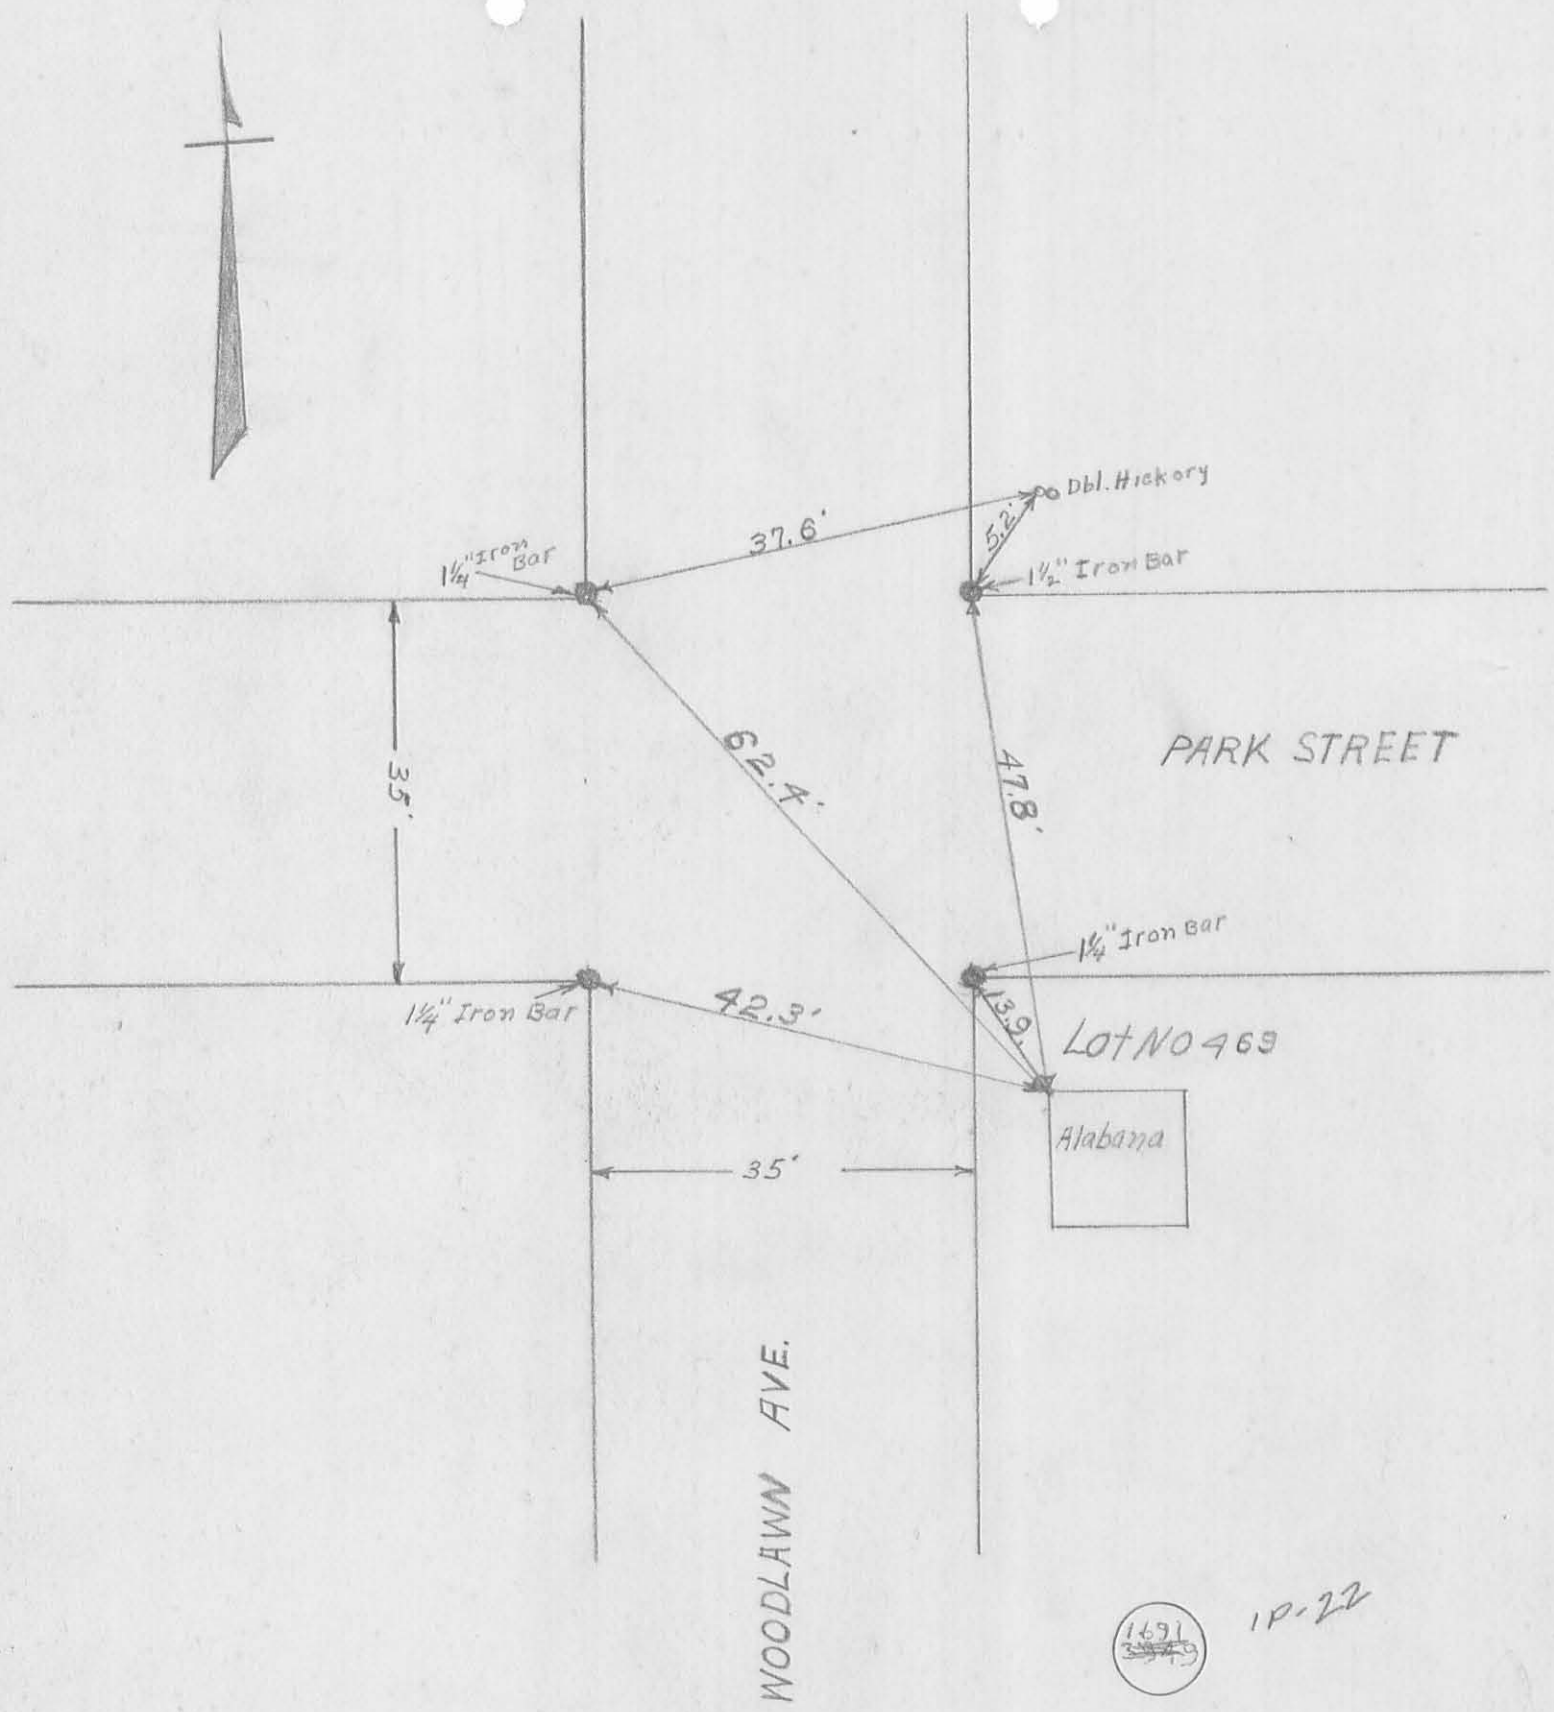

1691
~~349~~


1P-22

INDEXED ON MAP

WOODLAWN AVE. ¹⁶⁹¹ PARK STREET



WOODLAWN AVE.

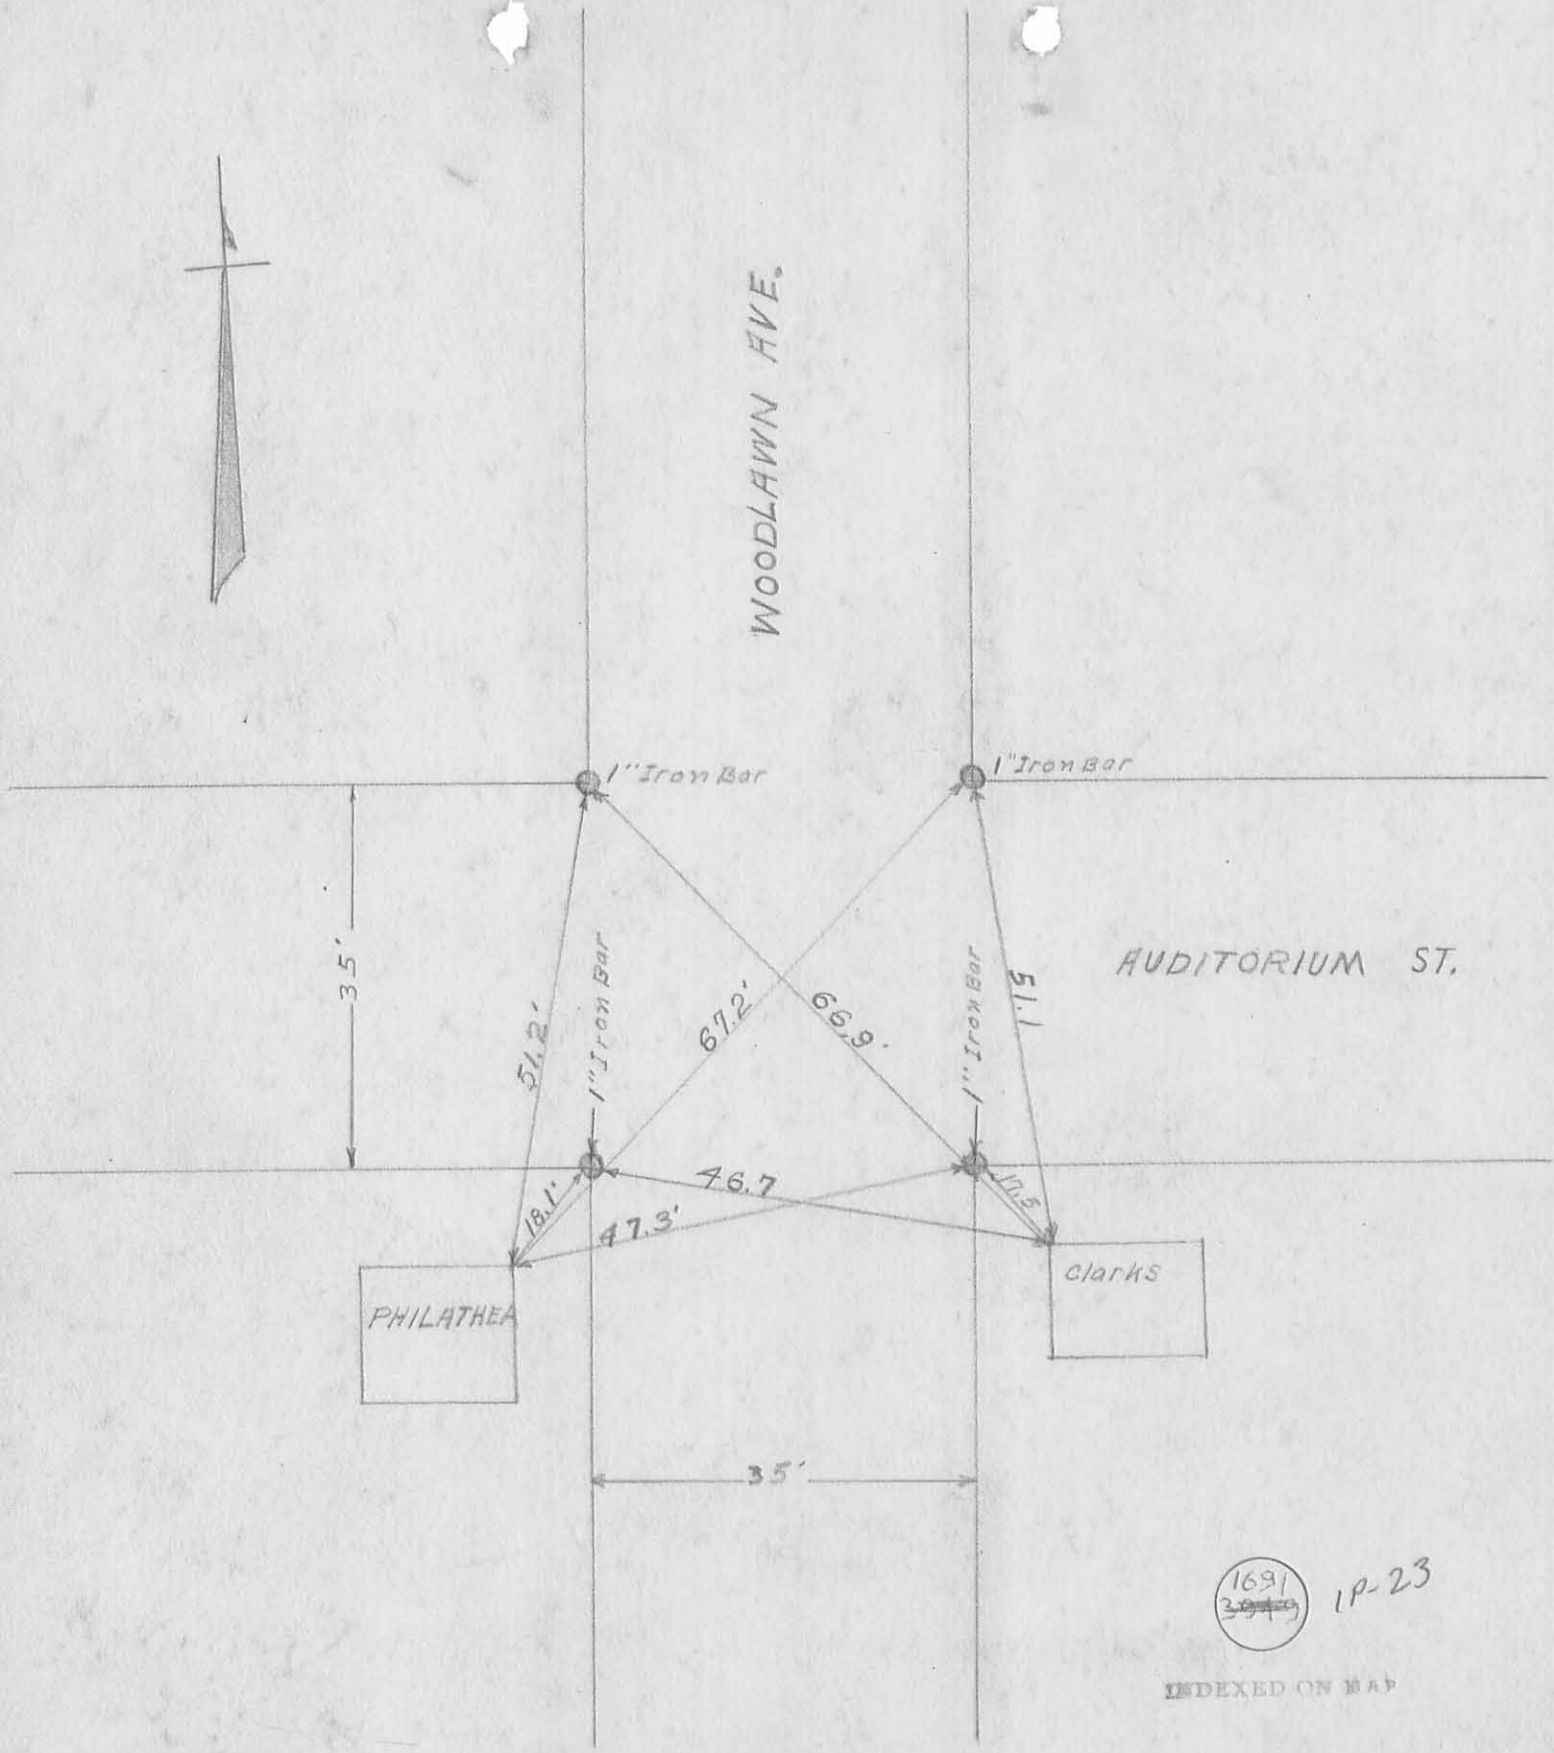

AUDITORIUM ST.

PHILATHEA


clarks


1691
~~3079~~

1P-23

INDEXED ON MAP

WOODLAWN AVE. AND AUDITORIUM ST.

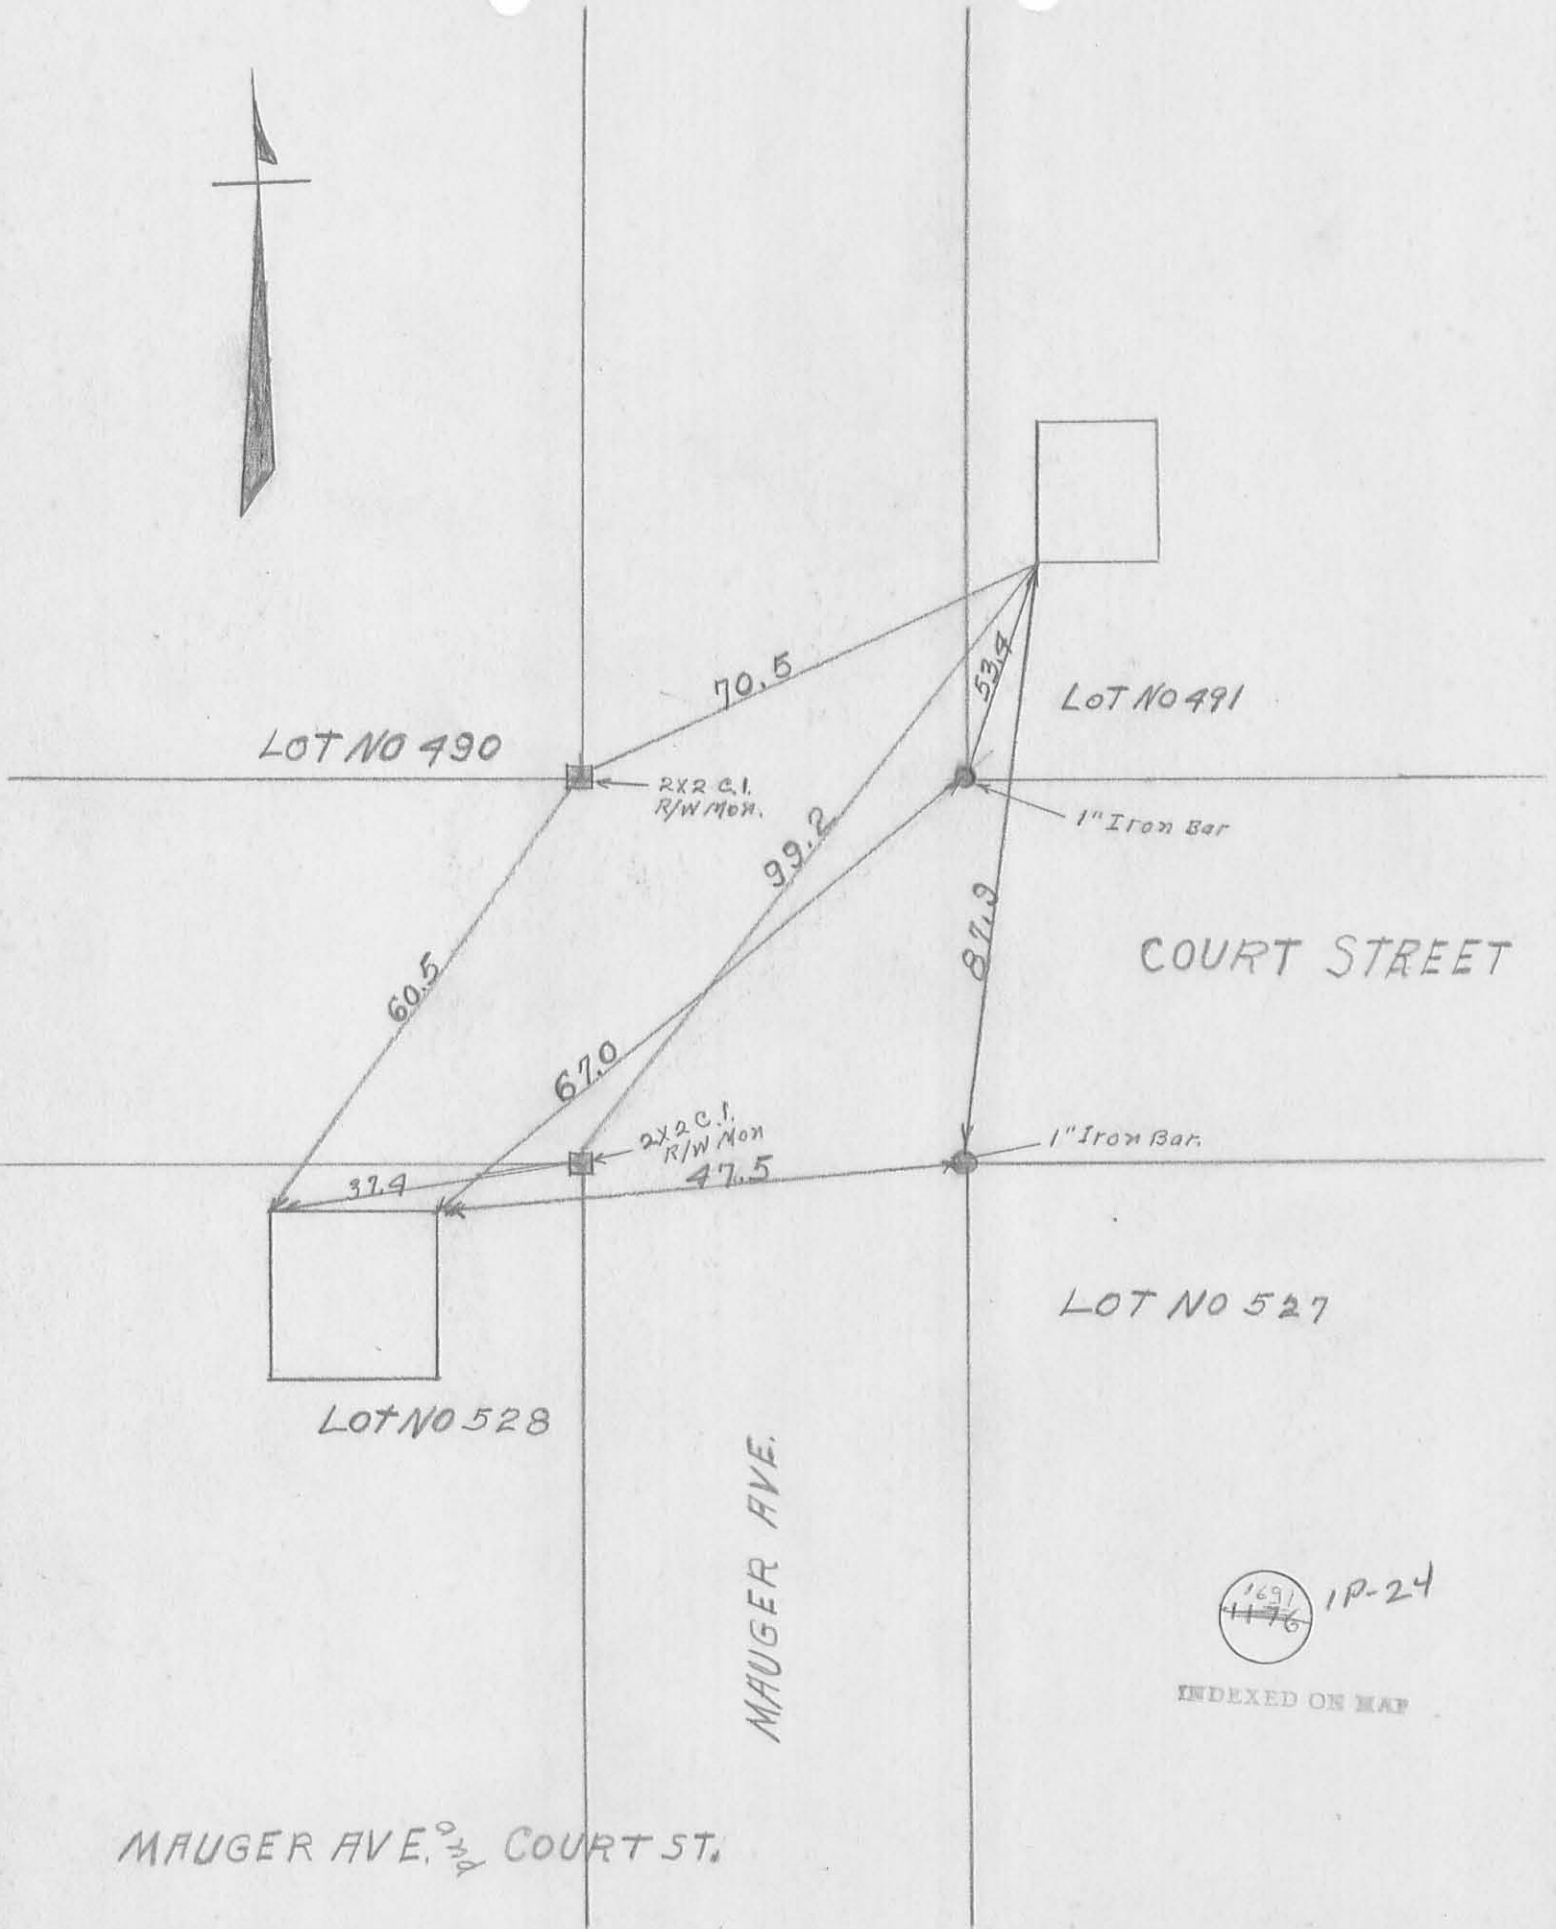

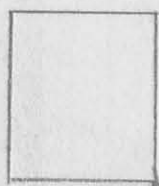

LOT NO 13

62.1

101.5

40.0


45.7

105.0

PARK STREET

LOT NO 482

LOT NO 491

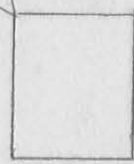

LOT NO 487


MAUGER AVE.

MAUGER AVE. ^{P.W.O.} PARK STREET



1P-25

INDEXED ON MAP

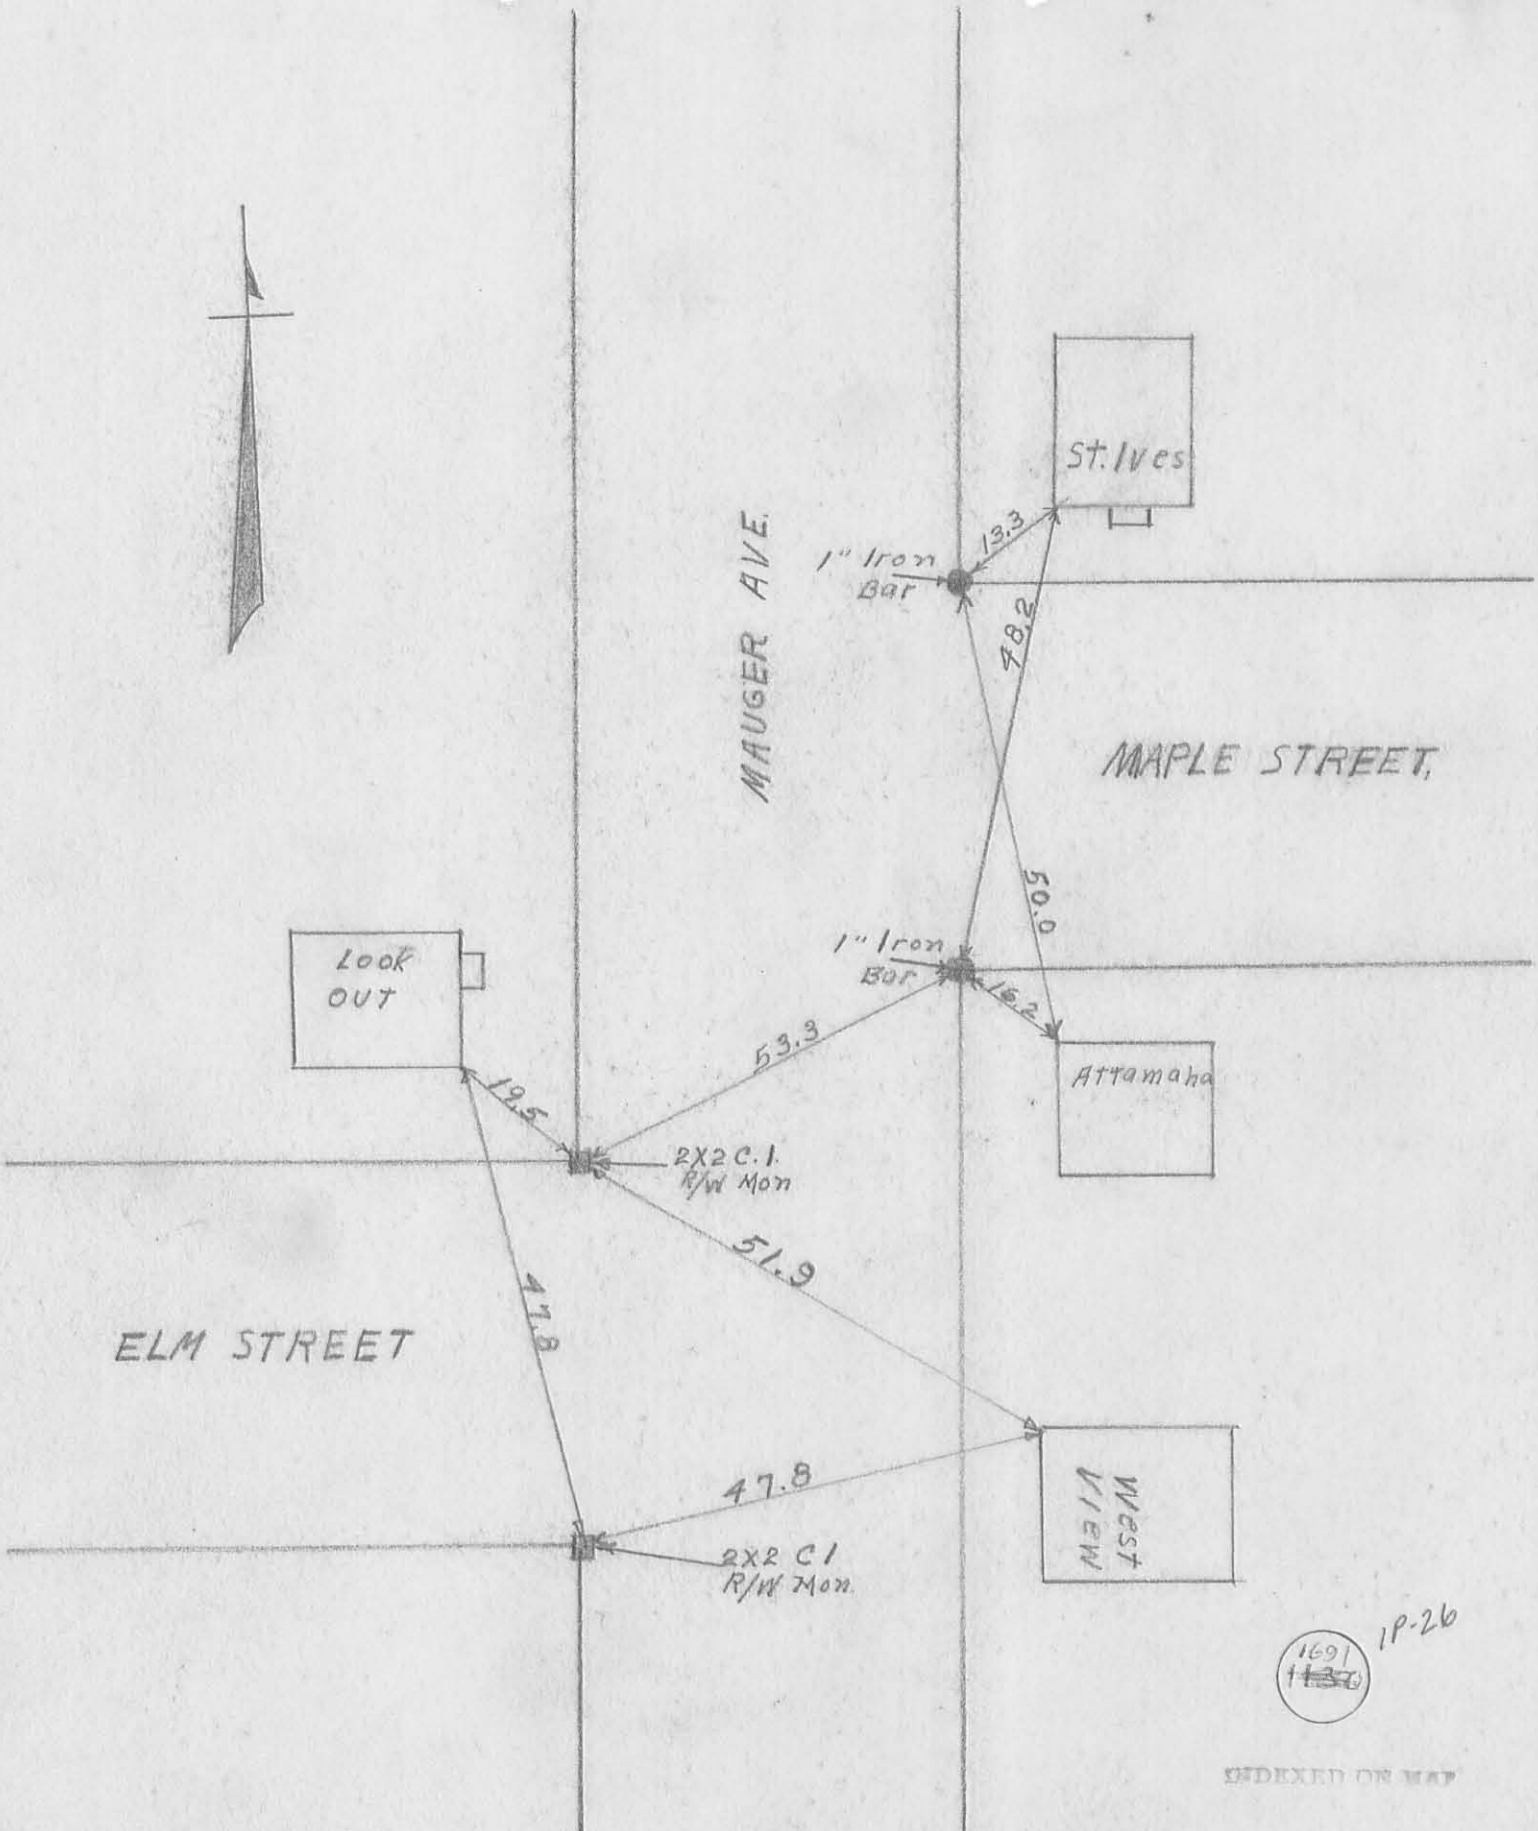


1691
11/30

1P-26

INDEXED ON MAP


MAUGER AV ELM STREET & MAPLE STREET.

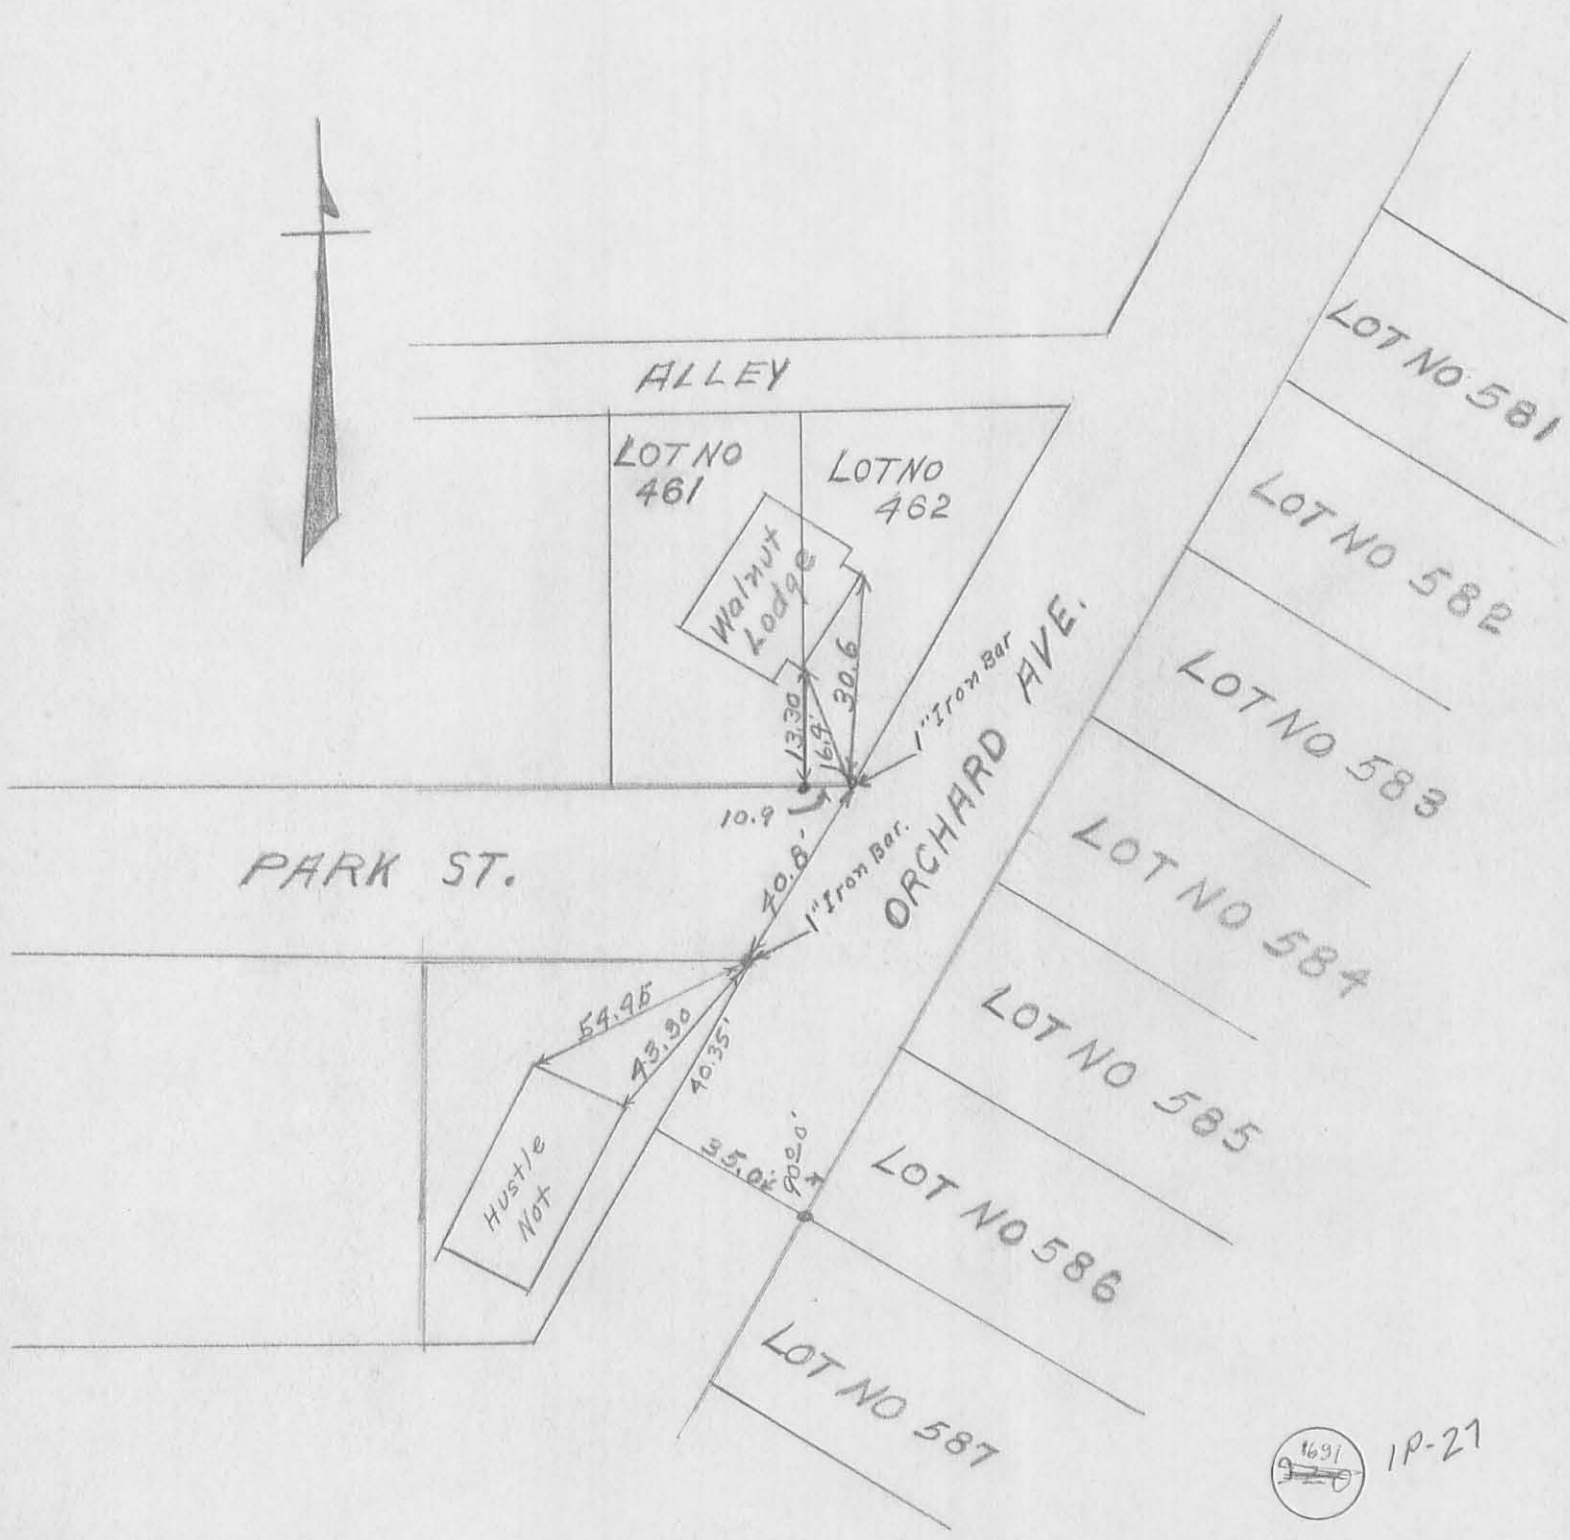

1691
 1P-21

INDEXED ON MAP


ORCHARD AVE. *and* PARK ST.

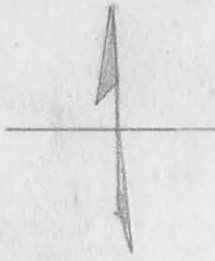

COTTAGE GROVE AVE.

LOT 39



LOT 22

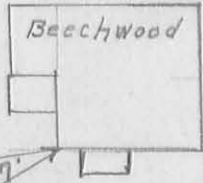

Poplar Street

LOT No 30

LOT No 29

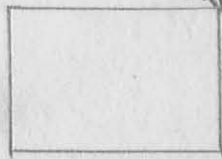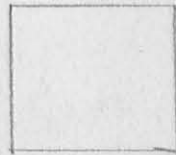

21.2'

52.2'

54.8'

24.7'

2x2 C.I. R/W Mon.

2x2 C.I. R/W Mon.

68.3'

Hub

35.0'


57.7'

1691
1378

1P-28

INDEXED ON MAP

POPLAR STREET and COTTAGE GROVE AVE

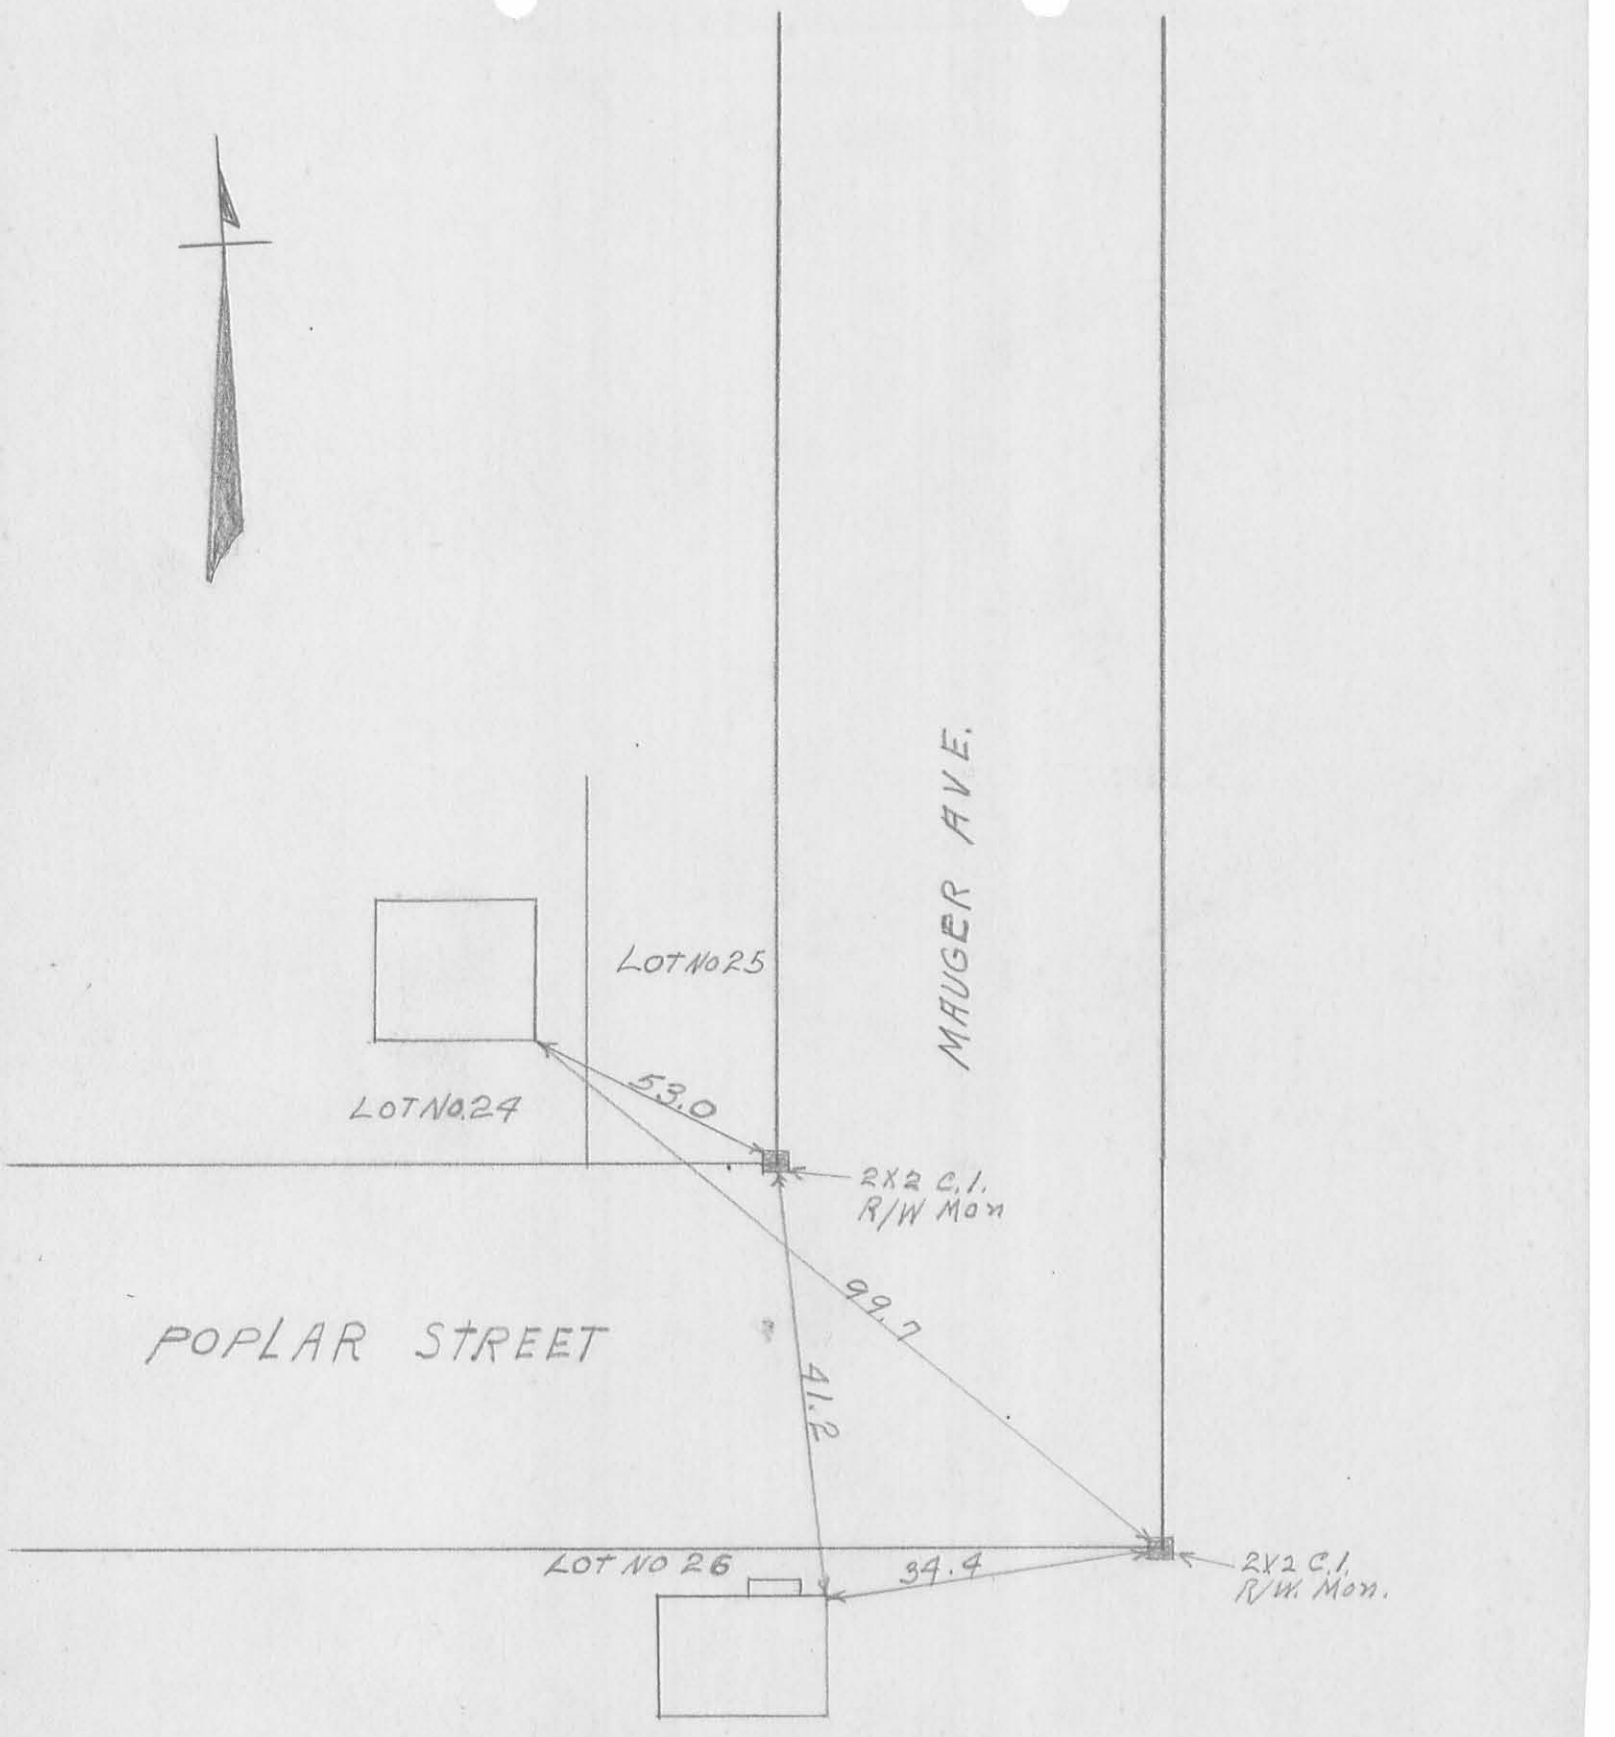

POPLAR ST ^{Plus} MAUGER AVE.


1691
~~2084~~ 1P-29

INDEXED ON MAP



COTTAGE GROVE AVE.

COURT STREET

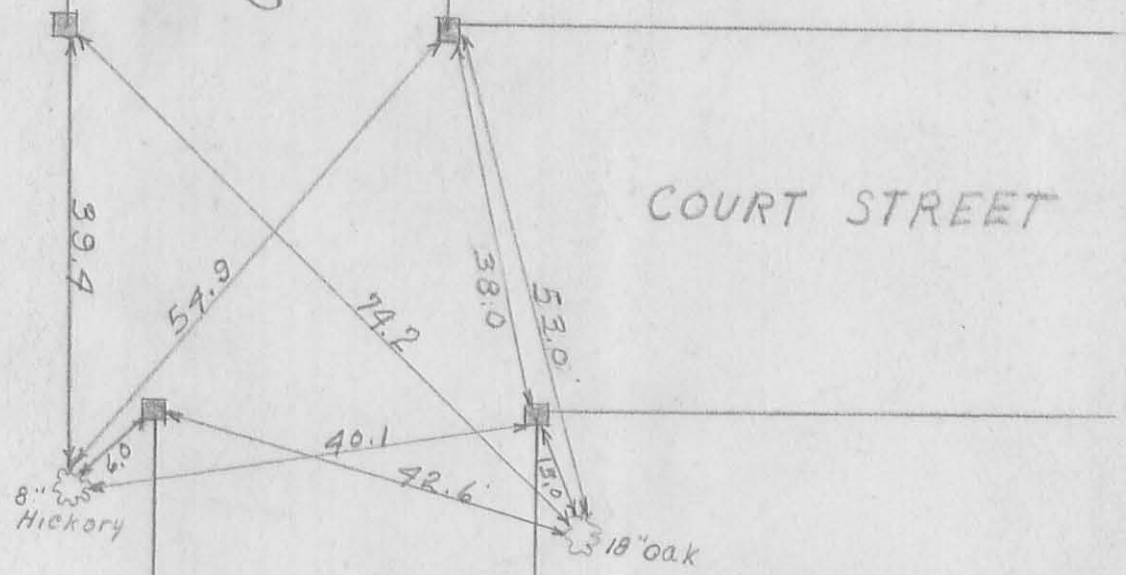


1 P-36

1691
~~1452~~

INDEXED ON MAP

COTTAGE GROVE AVE ^{1/2} COURT STREET

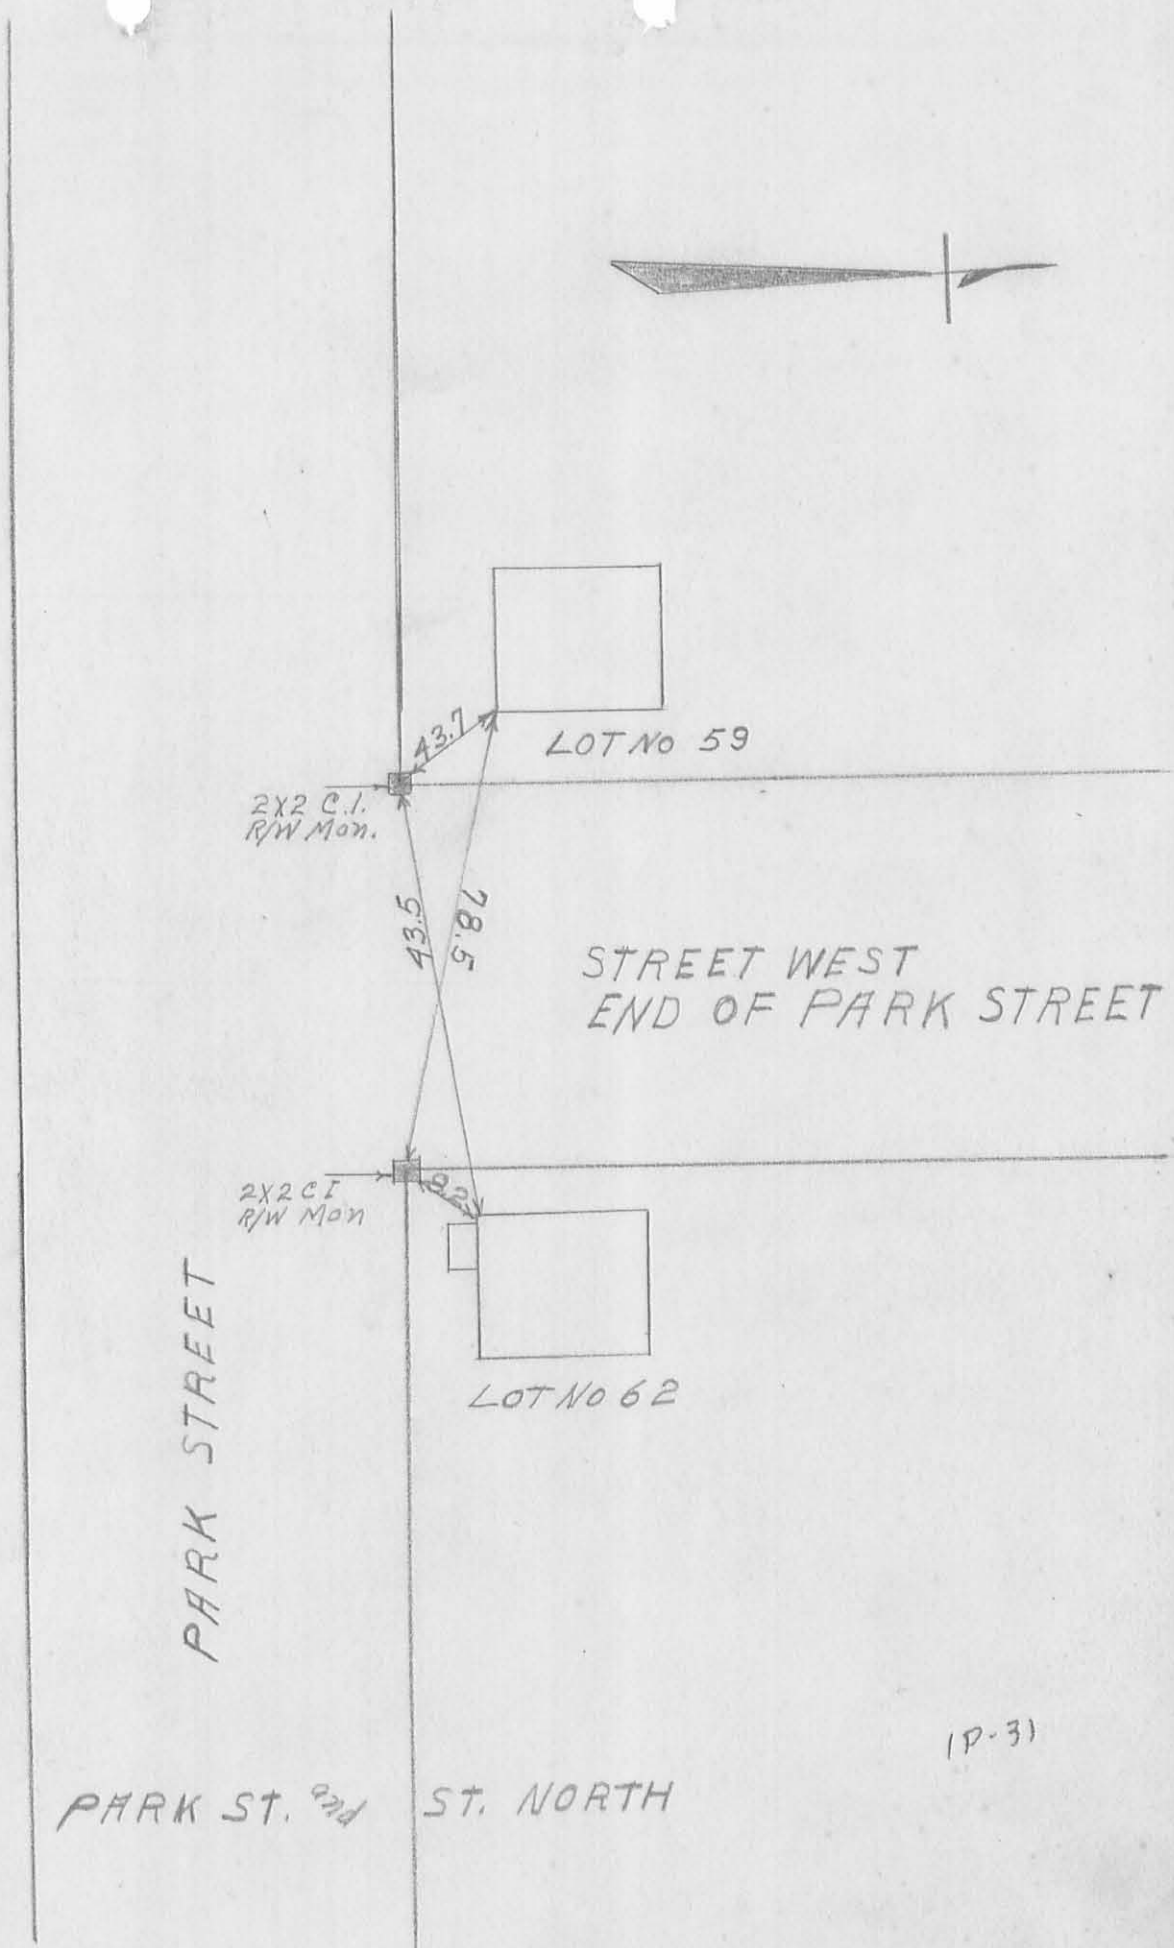

PARK STREET


LOT No 59

2x2 C.I.
R/W Mon.

43.7
43.5
78.5

STREET WEST
END OF PARK STREET

2x2 C.I.
R/W Mon.

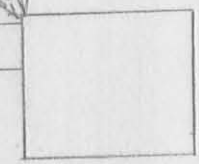

LOT No 62

PARK ST. ST. NORTH

(P-3)