

FB 703

FRANKLINE DRIVE
FIVE PARKS

□ 1" ϕ Re Bar Set on Φ

Geoslin
Dodson &
Ricketts

5/25/65


P. 7

OFFSET LINE

Pk nail Set

4333

INDEXED ON MAP
87599

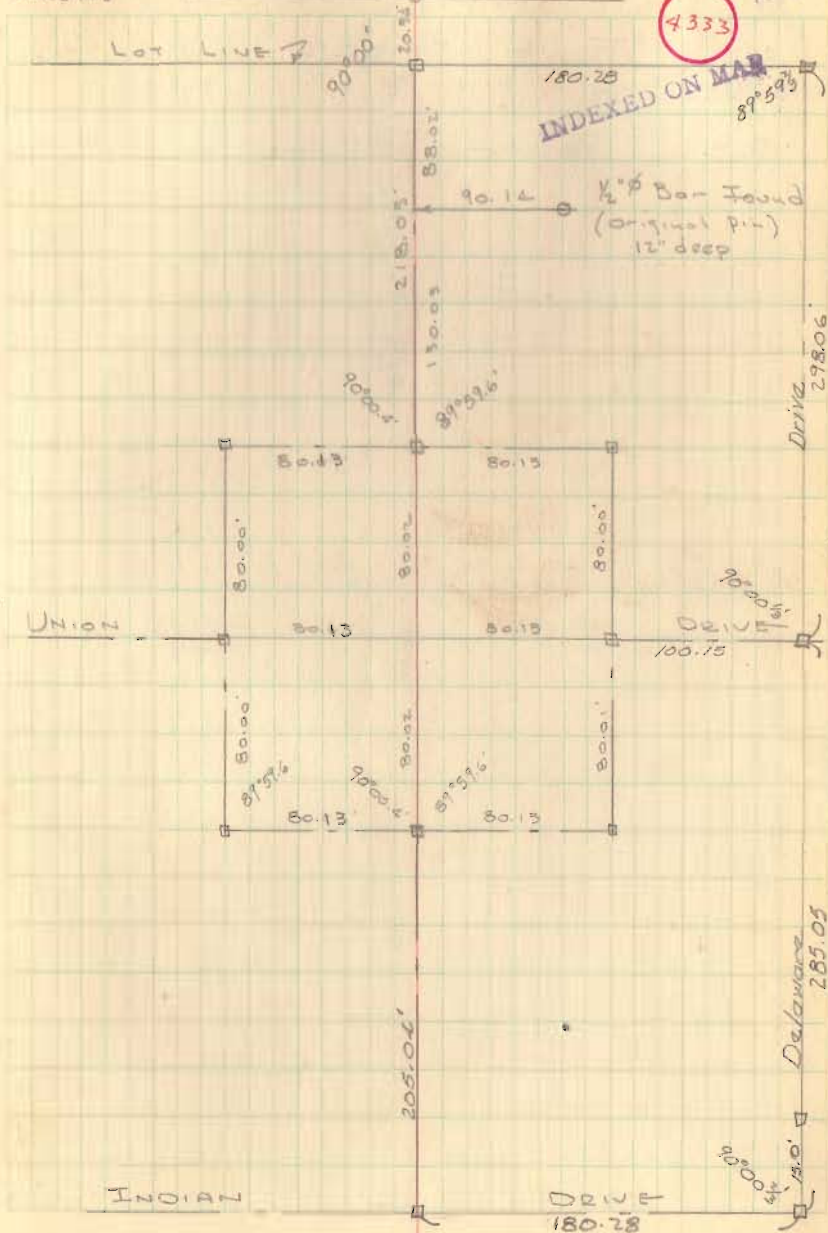

FB 703

7/21/65


Five Parks References

Franklin Dr.


4333

INDEXED ON MAP

North Line Five Parks Allot.

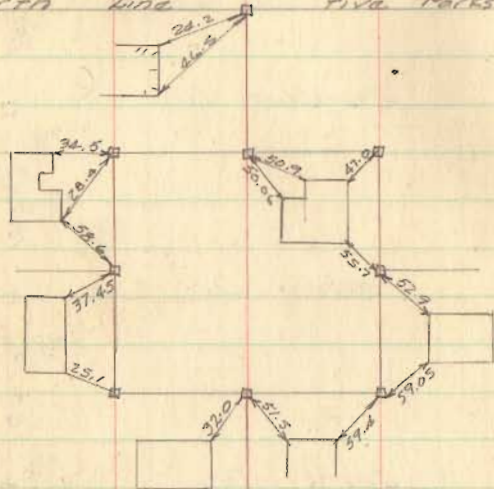

Clark Drive

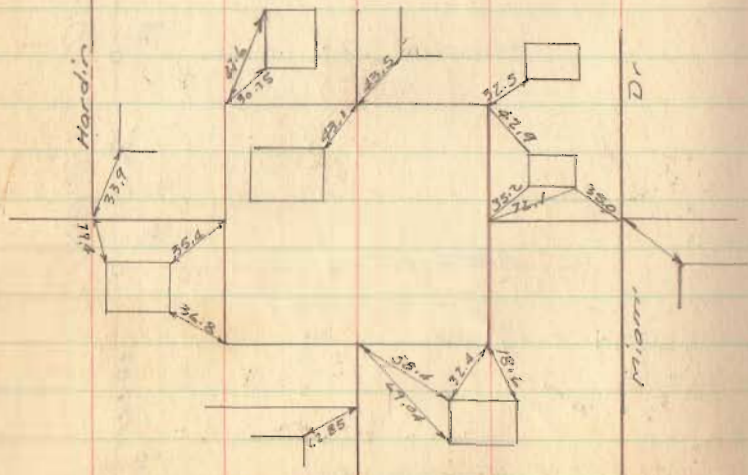

Slater &
Cox
Kauchar

7/21/65

Allen Dr.

4337

INDEXED ON MAP

North Line Five Parks

