


FB 696

Spillway at Indian Lake

Flat part on top of wall - 5' wide

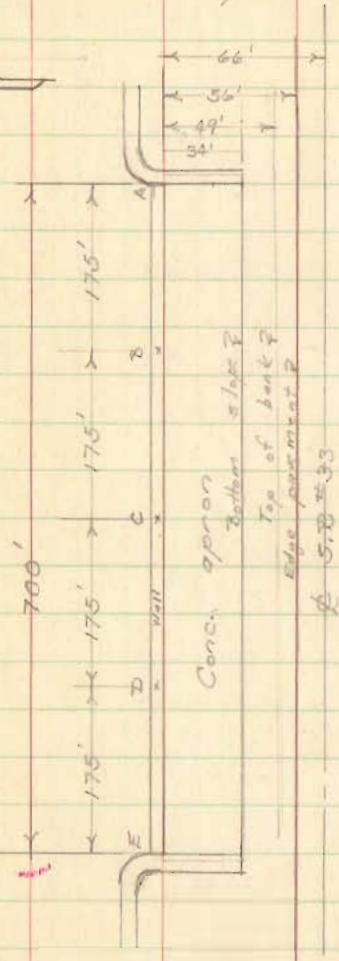

Oct. 22, 1953


C. Keyser

D. Dodson

T. Richardson

20

Reading on
stove gauge - 1.38

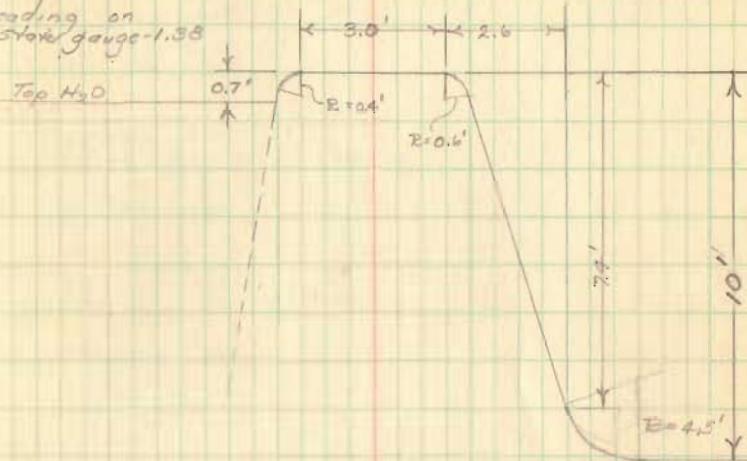

Cross-section Wall
at

INDEXED ON MAP

4381