

Grulick Survey
Tract A - 0.56 Ac.

September 20, 1969

The following described real estate situated in the Township of Washington, County of Logan, State of Ohio and being a part of Virginia Military Survey No. 9925-9946-10121 and being more particularly described as follows;

Beginning at a point in the centerline of S. R. No. 366 at the S. W. corner to Tola Demann's present 0.53 Acre tract,

Thence with the center line of said S. R. No. 366, S. $82^{\circ} 00'$ W. 109.60 feet to a point in said center line;

Thence N. $6^{\circ} 52'$ W. 198.0 feet to an iron bar, in the south line of Kenneth Lee Wood's present 0.80 Acre tract, passing through iron bars at 30.0 feet and 118.0 feet;

Thence with Wood's south line, N. $82^{\circ} 00'$ E. 34.0 feet to an iron bar, southeast corner to Wood's tract;

Thence with Wood's east line, N. $6^{\circ} 52'$ W. 32.0 feet to an iron bar, a corner to Forrest C. Reese's present 4.49 Acre tract;

Thence with the south line of Reese, N. $82^{\circ} 00'$ E. 76.10 feet to an iron bar, northwest to Demann's tract;

Thence with Demann's west line, S. $6^{\circ} 43'$ E. 230.0 feet to the place of beginning, passing through an iron bar at 200.0 feet, containing 0.56 Acres, more or less.

I hereby certify that this is a true and accurate description of a survey made by me on September 20, 1969.

Daniel E. Gilbert
Daniel E. Gilbert, P.S.
Reg. Sur. No. 5402
428 N. Madriver St.
Bellfontaine, Ohio 43311

INDEXED ON MAP

(9604) JDI



Grulick Survey
Tract B - 0.27 Ac.

September 20, 1969

The following described real estate situated in the Township of Washington,
County of Logan, State of Ohio and being a part of Virginia Military Survey No.
9925-9946-10121 and being more particularly described as follows:

Beginning at a point in the centerline of S. R. No. 366 at the S. E.
corner of Dunns Pond Allotment and in the east line of Center St.,

Thence with the east line of Center St., N. $6^{\circ} 52'$ W. 118.0 feet to
an iron bar, passing through an iron bar at 30.0 feet;

Thence N. $82^{\circ} 00'$ E. 100.0 feet to an iron bar;

Thence S. $6^{\circ} 52'$ E. 118.0 feet to a point in the centerline of S. R.
No. 366, passing through an iron bar at 88.0 feet;

Thence with the centerline of S. R. No. 366, S. $82^{\circ} 00'$ W. 100.0 feet
to the place of beginning, containing 0.27 Acres, more or less.

I hereby certify that this is a true and accurate description of a survey
made by me on September 20, 1969.

Daniel E. Gilbert

Daniel E. Gilbert, P.S.
Reg. Sur. No. 5402
428 N. Madriver St.
Bellefontaine, Ohio 43311

INDEXED ON MAP

(4609) 1D-2



Grulick Survey
Tract C - 0.18 Ac.

September 20, 1969

The following described real estate situated in the Township of Washington,
County of Logan, State of Ohio and being a part of Virginia Military Survey No.
9925-9946-10121 and being more particularly described as follows;

Beginning at an iron bar in the east line of Center St. of Dunns Pond
Allement, that is N. $6^{\circ} 52'$ W. 118.0 feet from the centerline of S. R. No. 366
and also being the S. E. corner to Dunns Pond Allement;

Thence continuing with the east line of Center St., N. $6^{\circ} 52'$ W. 80.0
feet to an iron bar, S. W. corner to Kenneth Lee Wood's present 0.80 Acre tract;

Thence with Wood's south line, N. $82^{\circ} 00'$ E. 100.0 feet to an iron bar;

Thence S. $6^{\circ} 52'$ E. 80.0 feet to an iron bar;


Thence S. $82^{\circ} 00'$ W. 100.0 feet to the place of beginning, containing
0.18 Acres, more or less.

I hereby certify that this is a true and accurate description of a
survey made by me on September 20, 1969.

Daniel E. Gilbert
Daniel E. Gilbert, P.S.
Reg. Sur. No. 5402
428 N. Madriver St.
Bellefontaine, Ohio 43311

INDEXED ON MAY

(4604) 1D-3

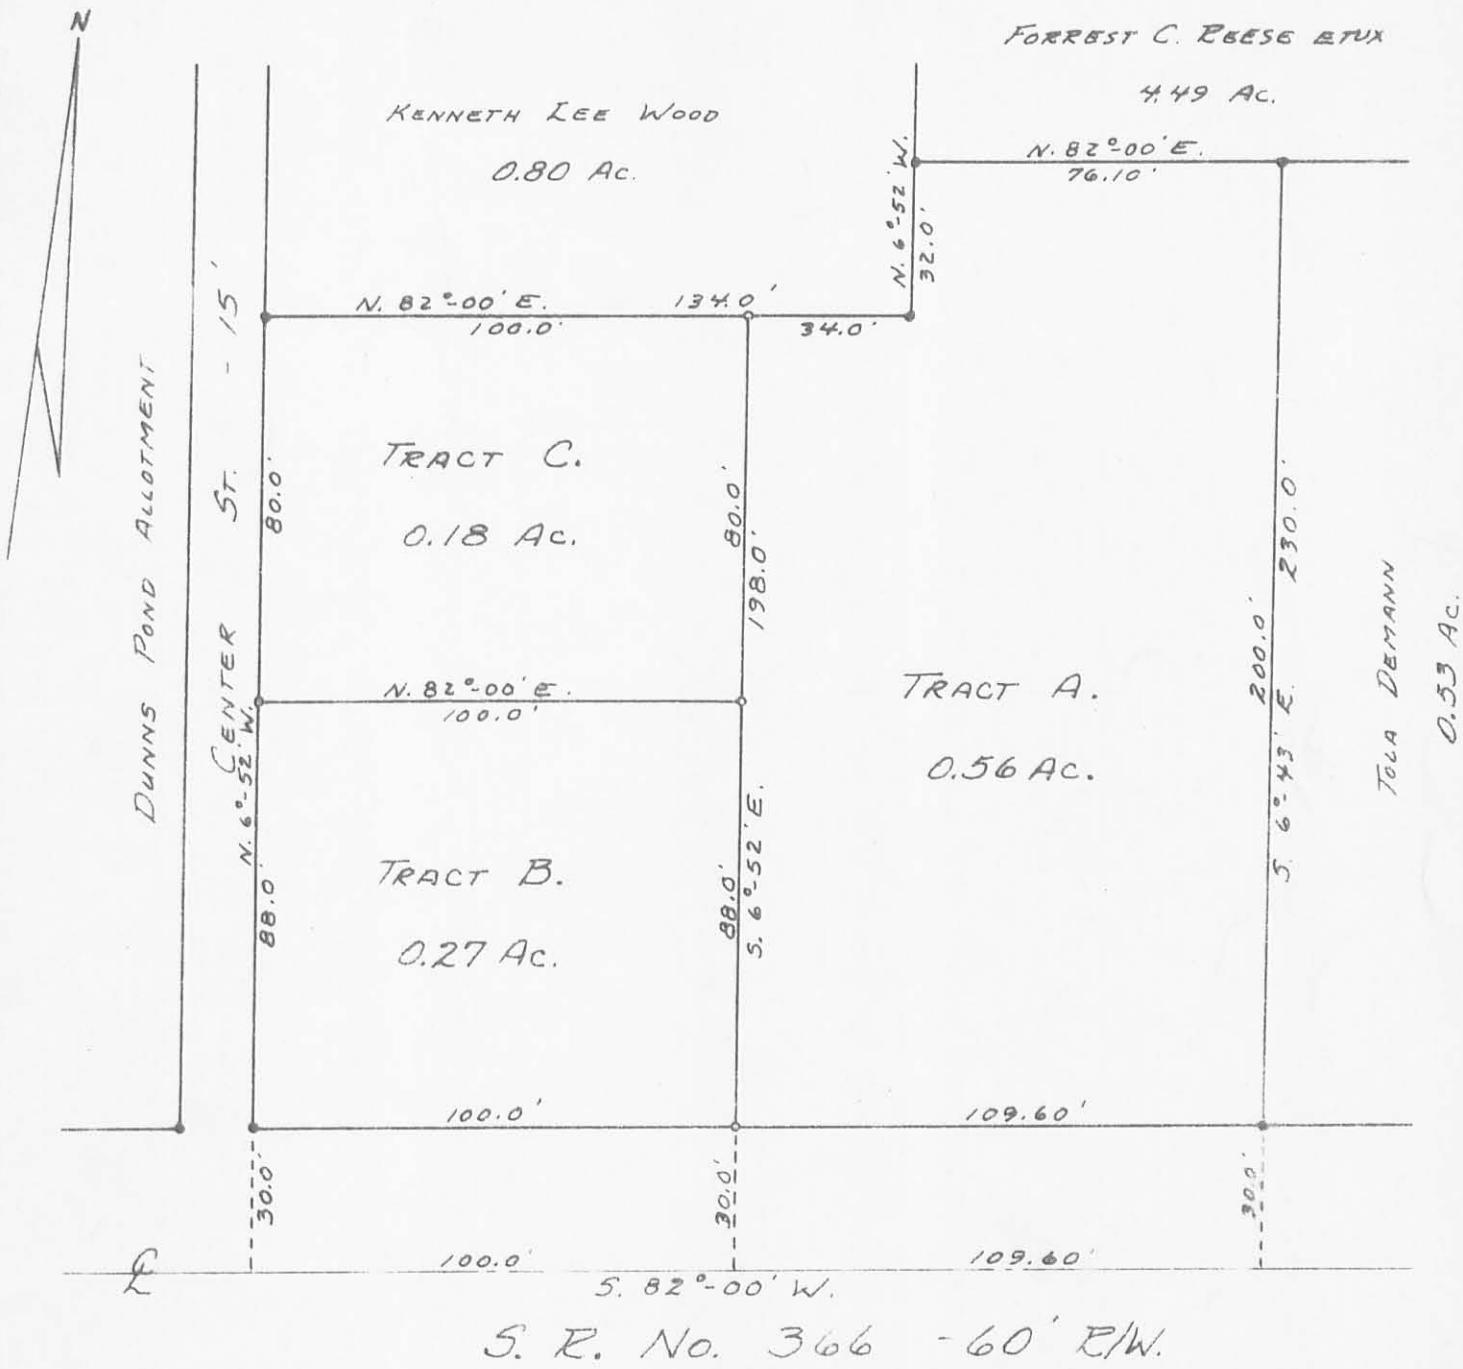

SURVEYED AND PLATTED BY:
 DANIEL E. GILBERT, P.S.
 REG. SUR. NO. 5402
 428 N. MADRIVER ST.
 BELLEFONTAINE, OHIO 43311

GRULICK SURVEY
 V.M.S. 9925-9946-10121
 WASHINGTON TOWNSHIP
 LOGAN COUNTY, OHIO
 SEPTEMBER 20, 1969
 INDEXED ON MAP
 4604 IP SCALE: 1" = 40'