


RECD B-31-04 SURV

15.0' ALLEY

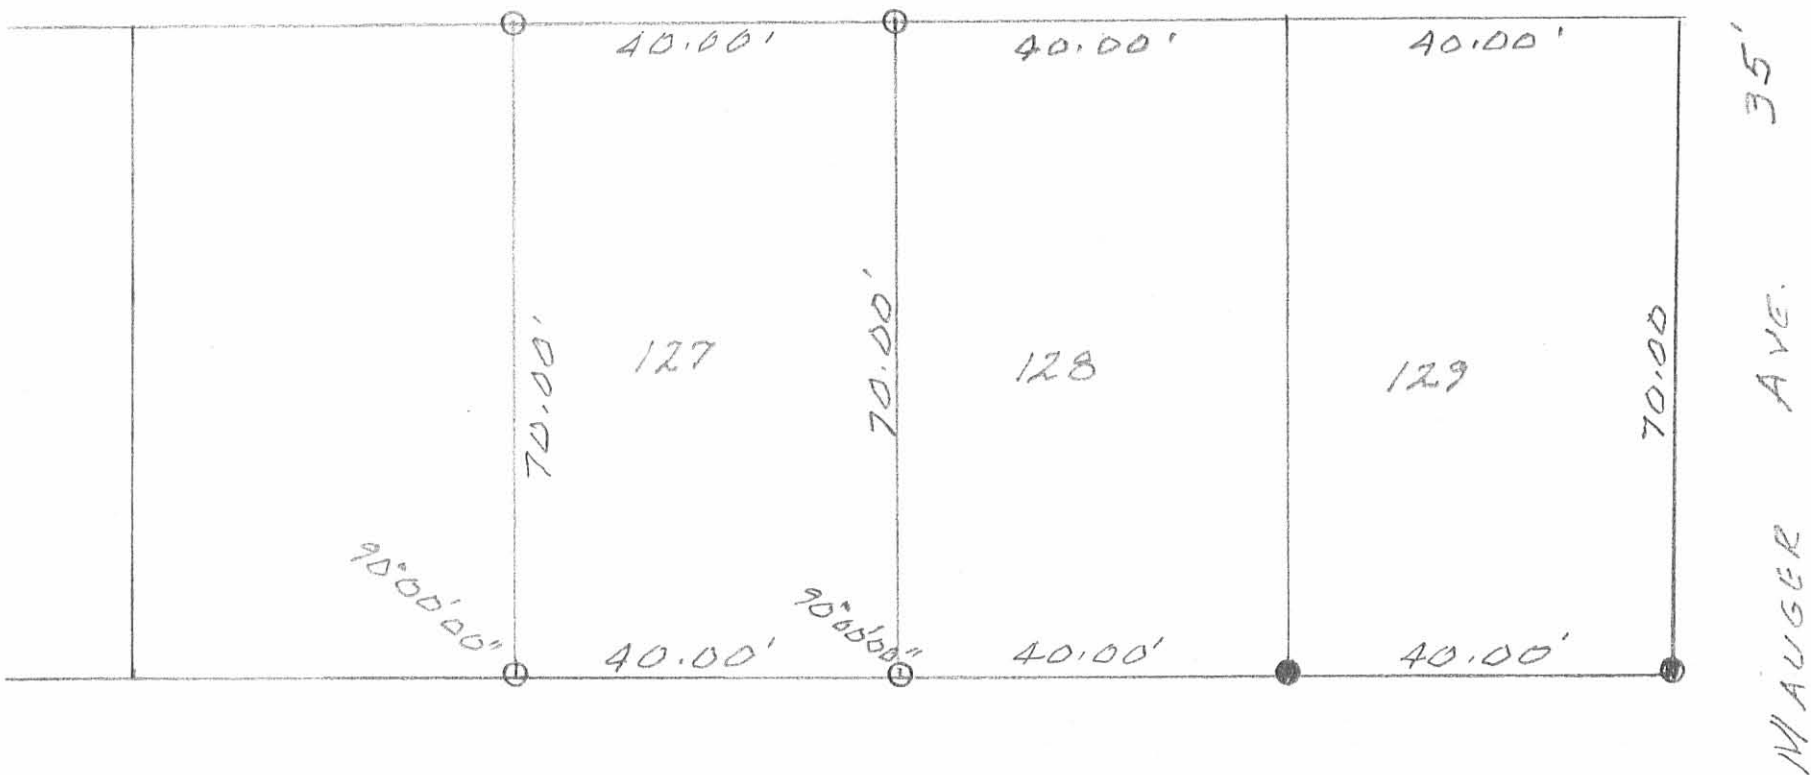

LEGEND:

- = 5/8" IRON BAR FOUND
- = 5/8" IRON BAR SET

SYCAMORE ST. (30')

SURVEY OF LOT 127 OF ORCHARD ISLAND WASHINGTON TWP., LOGAN COUNTY, OHIO FOR GARY BRINK.

AUGUST 30, 2006


SCALE: 1" = 20'



Leslie H. Geeslin

LESLIE H. GEESLIN
RUSHCREEK, OHIO
PH 957-468-7265

INDEXED ON MAP
4998 IP

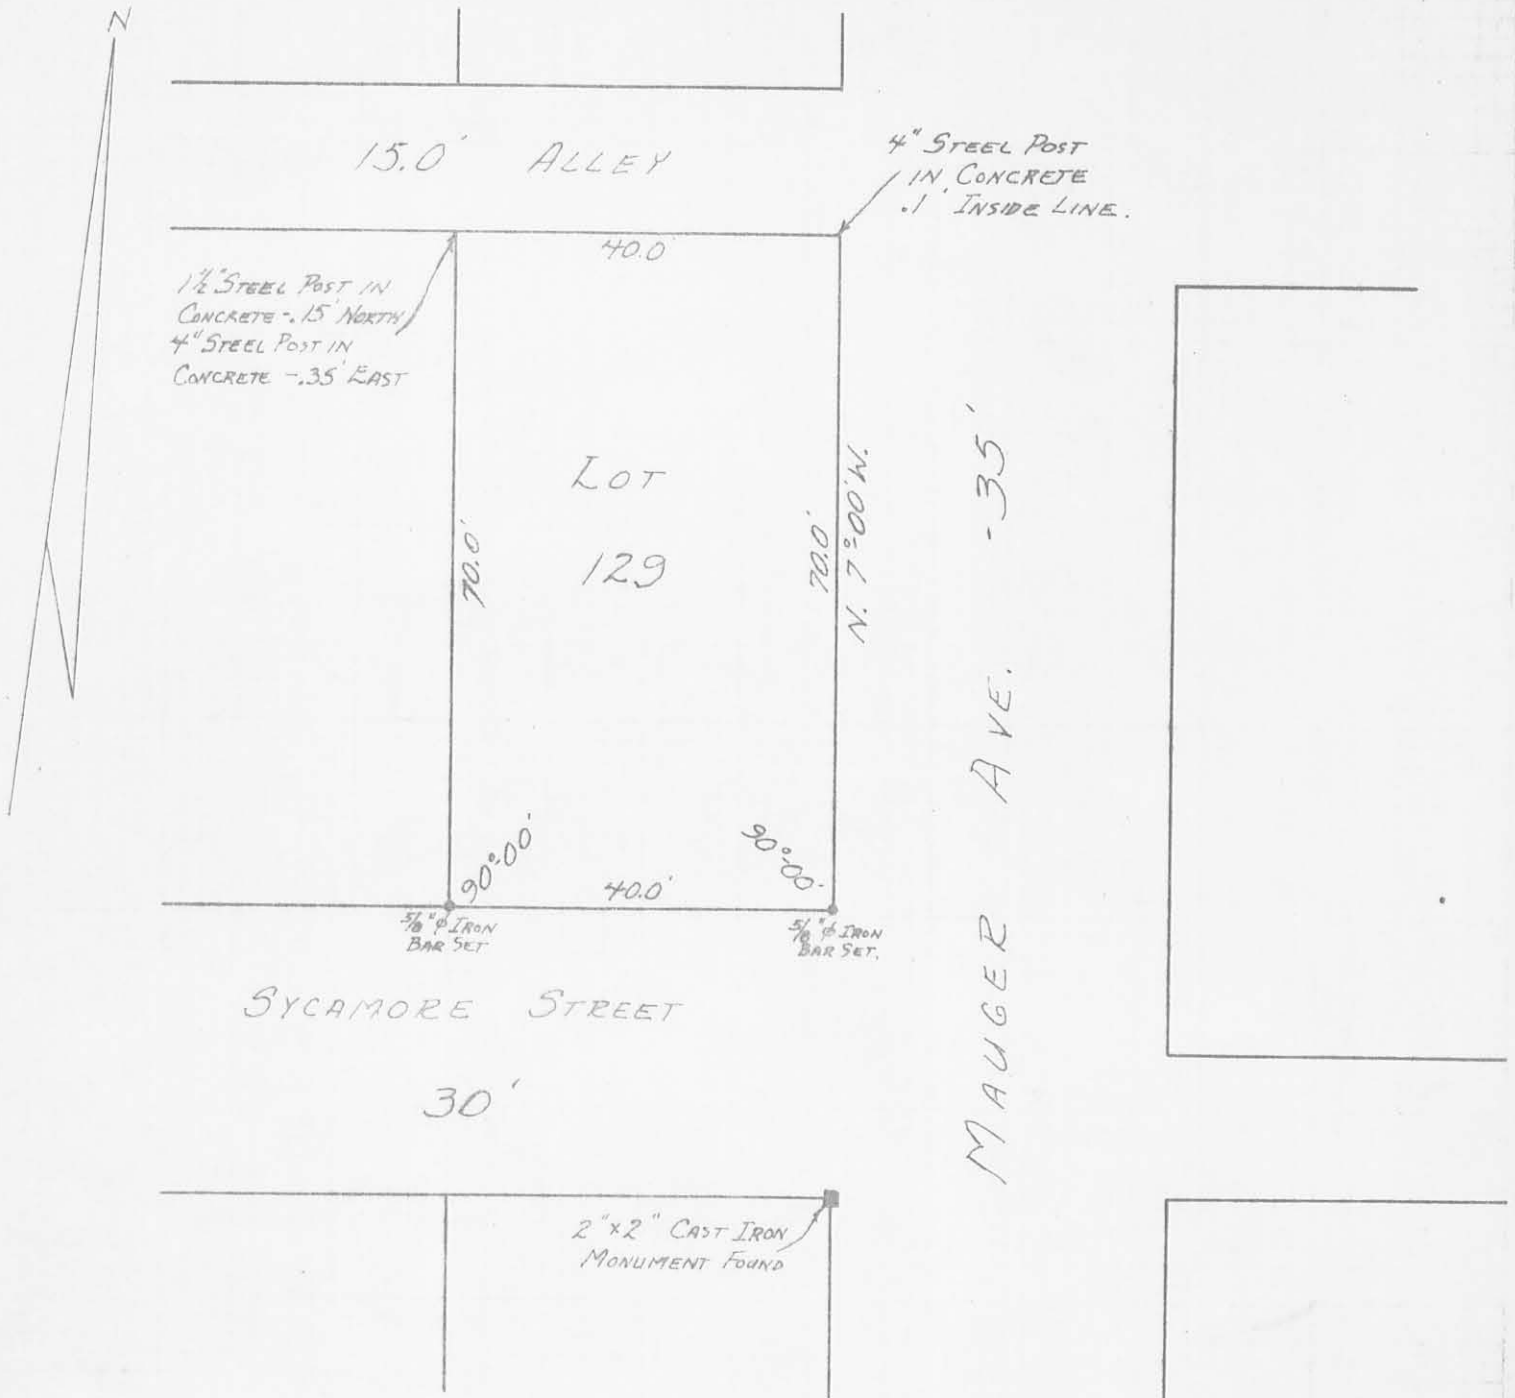

REFERENCE:

ORCHARD ISLAND PLAT.
 PLAT BOOK B VOL. 2 PAGE 121.

SURVEYED AND PLATTED BY:
 DANIEL E. GILBERT, P.S.
 REG. SUR. No. 5402
 428 N. MADRIVER ST.
 BELLEFONTAINE, OHIO 43311

TRUSHEL SURVEY
 LOT No. 129
 ORCHARD ISLAND
 WASHINGTON TOWNSHIP
 LOGAN COUNTY, OHIO
 NOVEMBER 21, 1970
 SCALE: 1"=20'

4798
 2P