

REC'D 9-7-05 SMJ OK

LEGEND:

- ⊙ 3/4 INCH IRON PIPE FOUND
- ⊠ 3/4 INCH IRON BAR FOUND
- 5/8 INCH IRON ROD FOUND
- ⊗ RAILROAD SPIKE FOUND

DARLENE P. STEVENS
0.09 ACRE
O.R. 641, PG. 270
TRACT I

LOT 10

N 83°37'26" E
147.44'

LOT 11

PARCEL I

RICHARD D. BURDEN AND
ARMILLA M. BURDEN
0.22 ACRE
O.R. 465, PG. 530

PARCEL III

LOT 12

FIVE PARKS ALLOTMENT
PLAT CABINET A, SLIDES 219-221

PARCEL II

LOT 13

PAUL V. BONETZKY
4.406 ACRES
O.R. 556, PG. 77

N 06°00'00" W
200.10'

LOT 14

RICHARD D. BURDEN AND
ARMILLA M. BURDEN
0.15 ACRE
O.R. 282, PG. 847

TRACT II

TRACT I

LOT 15

WOOD-FRAME
GARAGE ON
CONCRETE SLAB


29.8'
16.4'
156.35'
0.1'

GARAGE
ENCROACHES

ELIZABETH GRUBE
0.20 ACRE
O.R. 377, PG. 718
TRACT II

LOT 16

2 WORKING DAYS
BEFORE YOU DIG
CALL TOLL FREE **800-362-2764**
OHIO UTILITIES PROTECTION SERVICE.

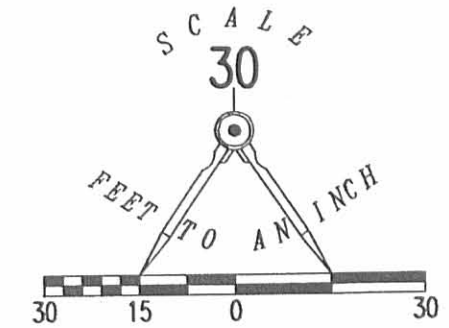

PARTIAL RETRACEMENT SURVEY OF THE
RICHARD D. BURDEN AND
ARMILLA M. BURDEN
LOTS 11 THROUGH 15
FIVE PARKS ALLOTMENT
PLAT CABINET A, SLIDES 219-221
0.15 ACRE TRACT AND 0.22 ACRE TRACT
OFFICIAL RECORD 282, PAGE 847
TRACTS I AND II
OFFICIAL RECORD 465, PAGE 530
PARCELS I, II AND III
VIRGINIA MILITARY SURVEYS 9925,
9946 AND 10121
WASHINGTON TOWNSHIP
LOGAN COUNTY, OHIO

SURVEYED BY:




Jeffrey I. Lee
JEFFREY I. LEE
PROFESSIONAL SURVEYOR 6359
SEPTEMBER 2, 2005

COPYRIGHT 2005 BY:
LEE SURVEYING & MAPPING CO., INC.
117 North Madriver Street
BELLEFONTAINE, OHIO 43311
(937) 593-7335
KSR D0905 4107085 L-4107-3

ORIGINAL STAMP IN GREEN

INDEXED ON MAP
5701 IP

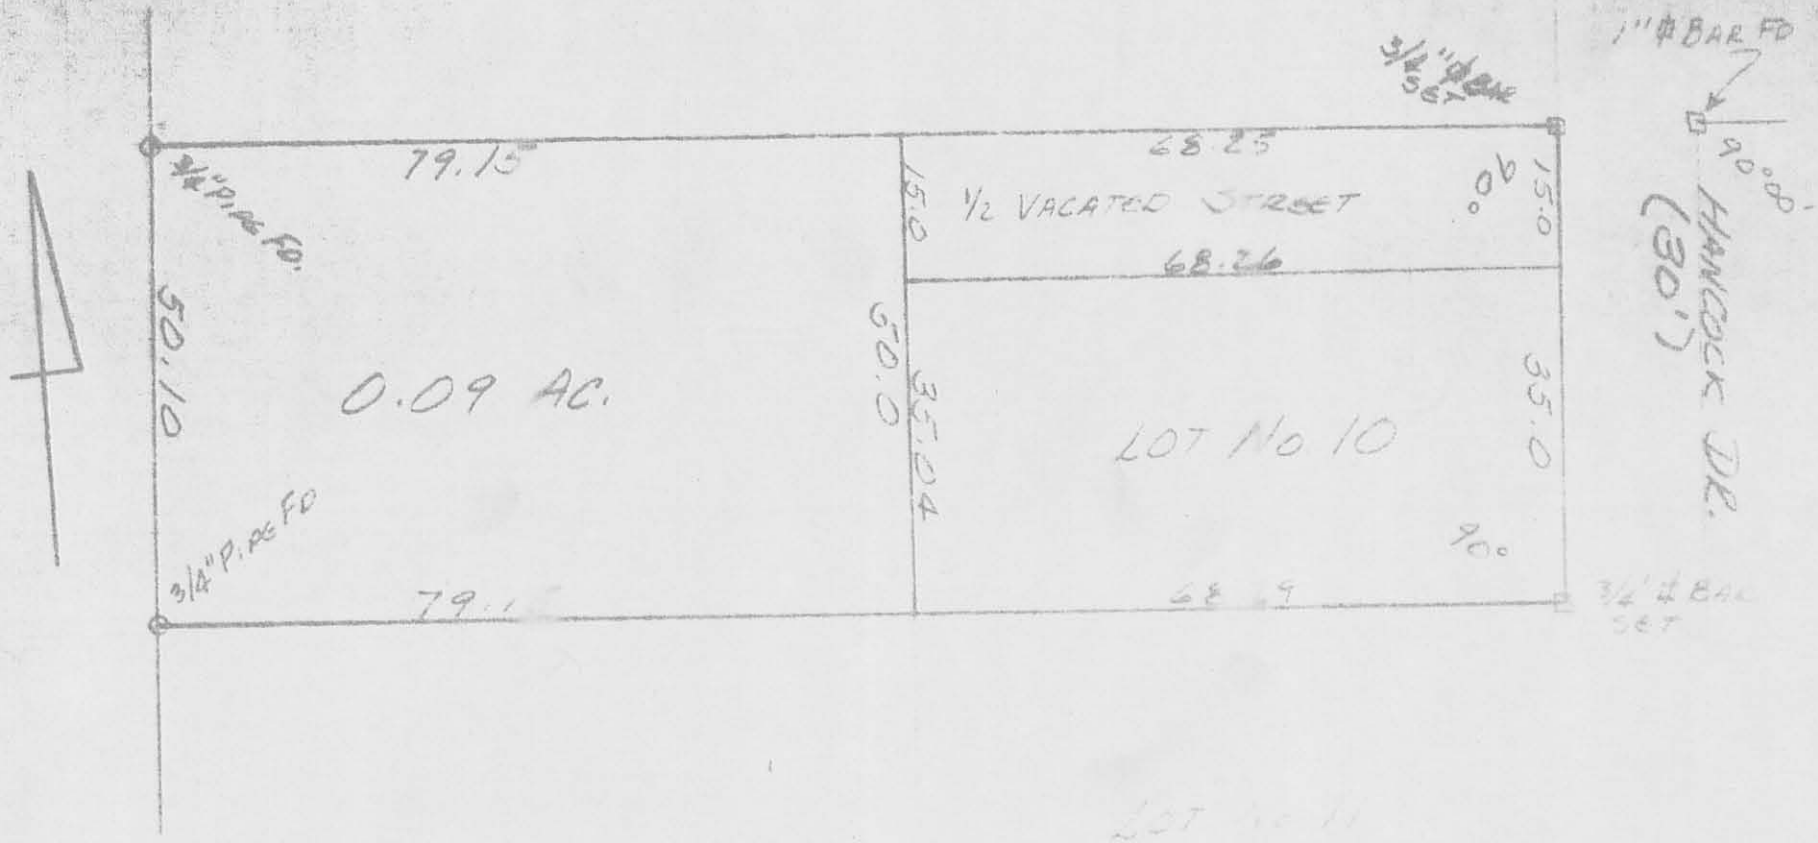

HANKO SURVEY
 AUGUST, 1974
 5 PARKS ALLOTMENT
 INDIAN LAKE
 WASHINGTON TOWNSHIP
 LOGAN COUNTY, OHIO
 SCALE 1" = 20'

5701 2P

INDEXED ON MAP

LESLIE T. GEEGLIN
 REG. SURVEYOR 5248
 RUSHSVLVANIA, OHIO


LOT 10
 FIVE PARKS
 WASHINGTON TWP.


INDEXED ON MAP
 5701

Dodson
 Geolin

9/24/60

74

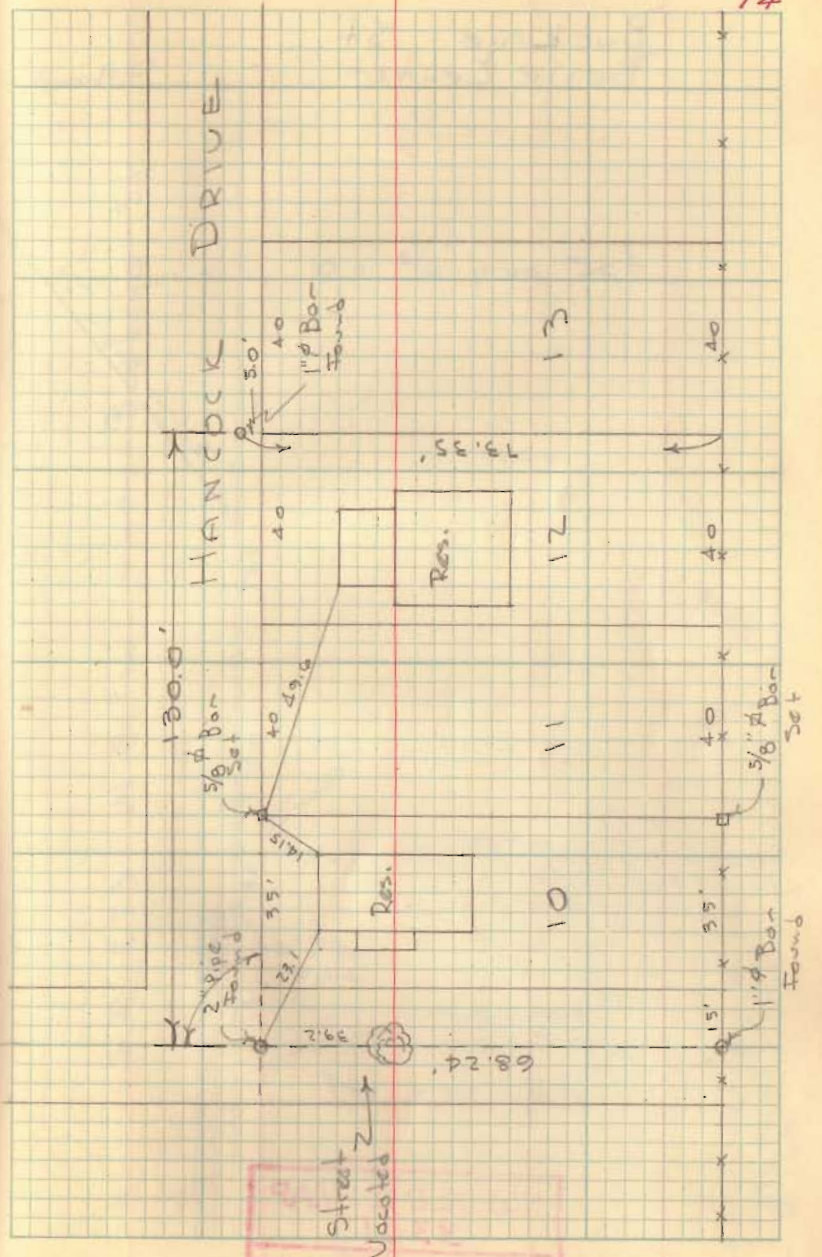

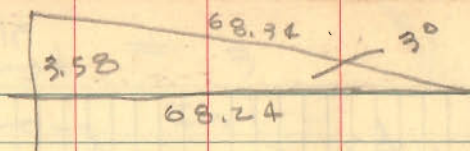

68.24
 $.0522$

 27296
 13648
 34120

 3575776

03492
 682

 26984
 27936

 20952
 68.2

3381544

1.00137
 68.24

 200548
 200274
 801096
 600822

 68.3

01740
 130

 052380
 01746

 226980

00384
 130

0.50000
 390

 1100
 1040

 600

91-60
13

90-47



INDEXED ON MAP
57.01

Lot 10 9/24/60
Five Parks 7

Blk 3/74

