
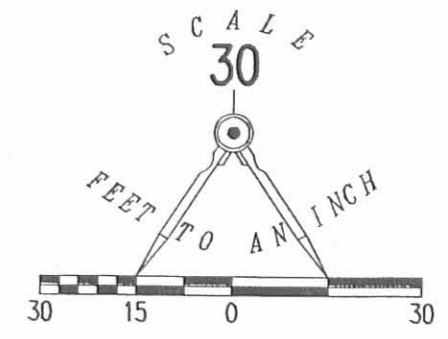


-REC'D 8-9-08 SMM/DK

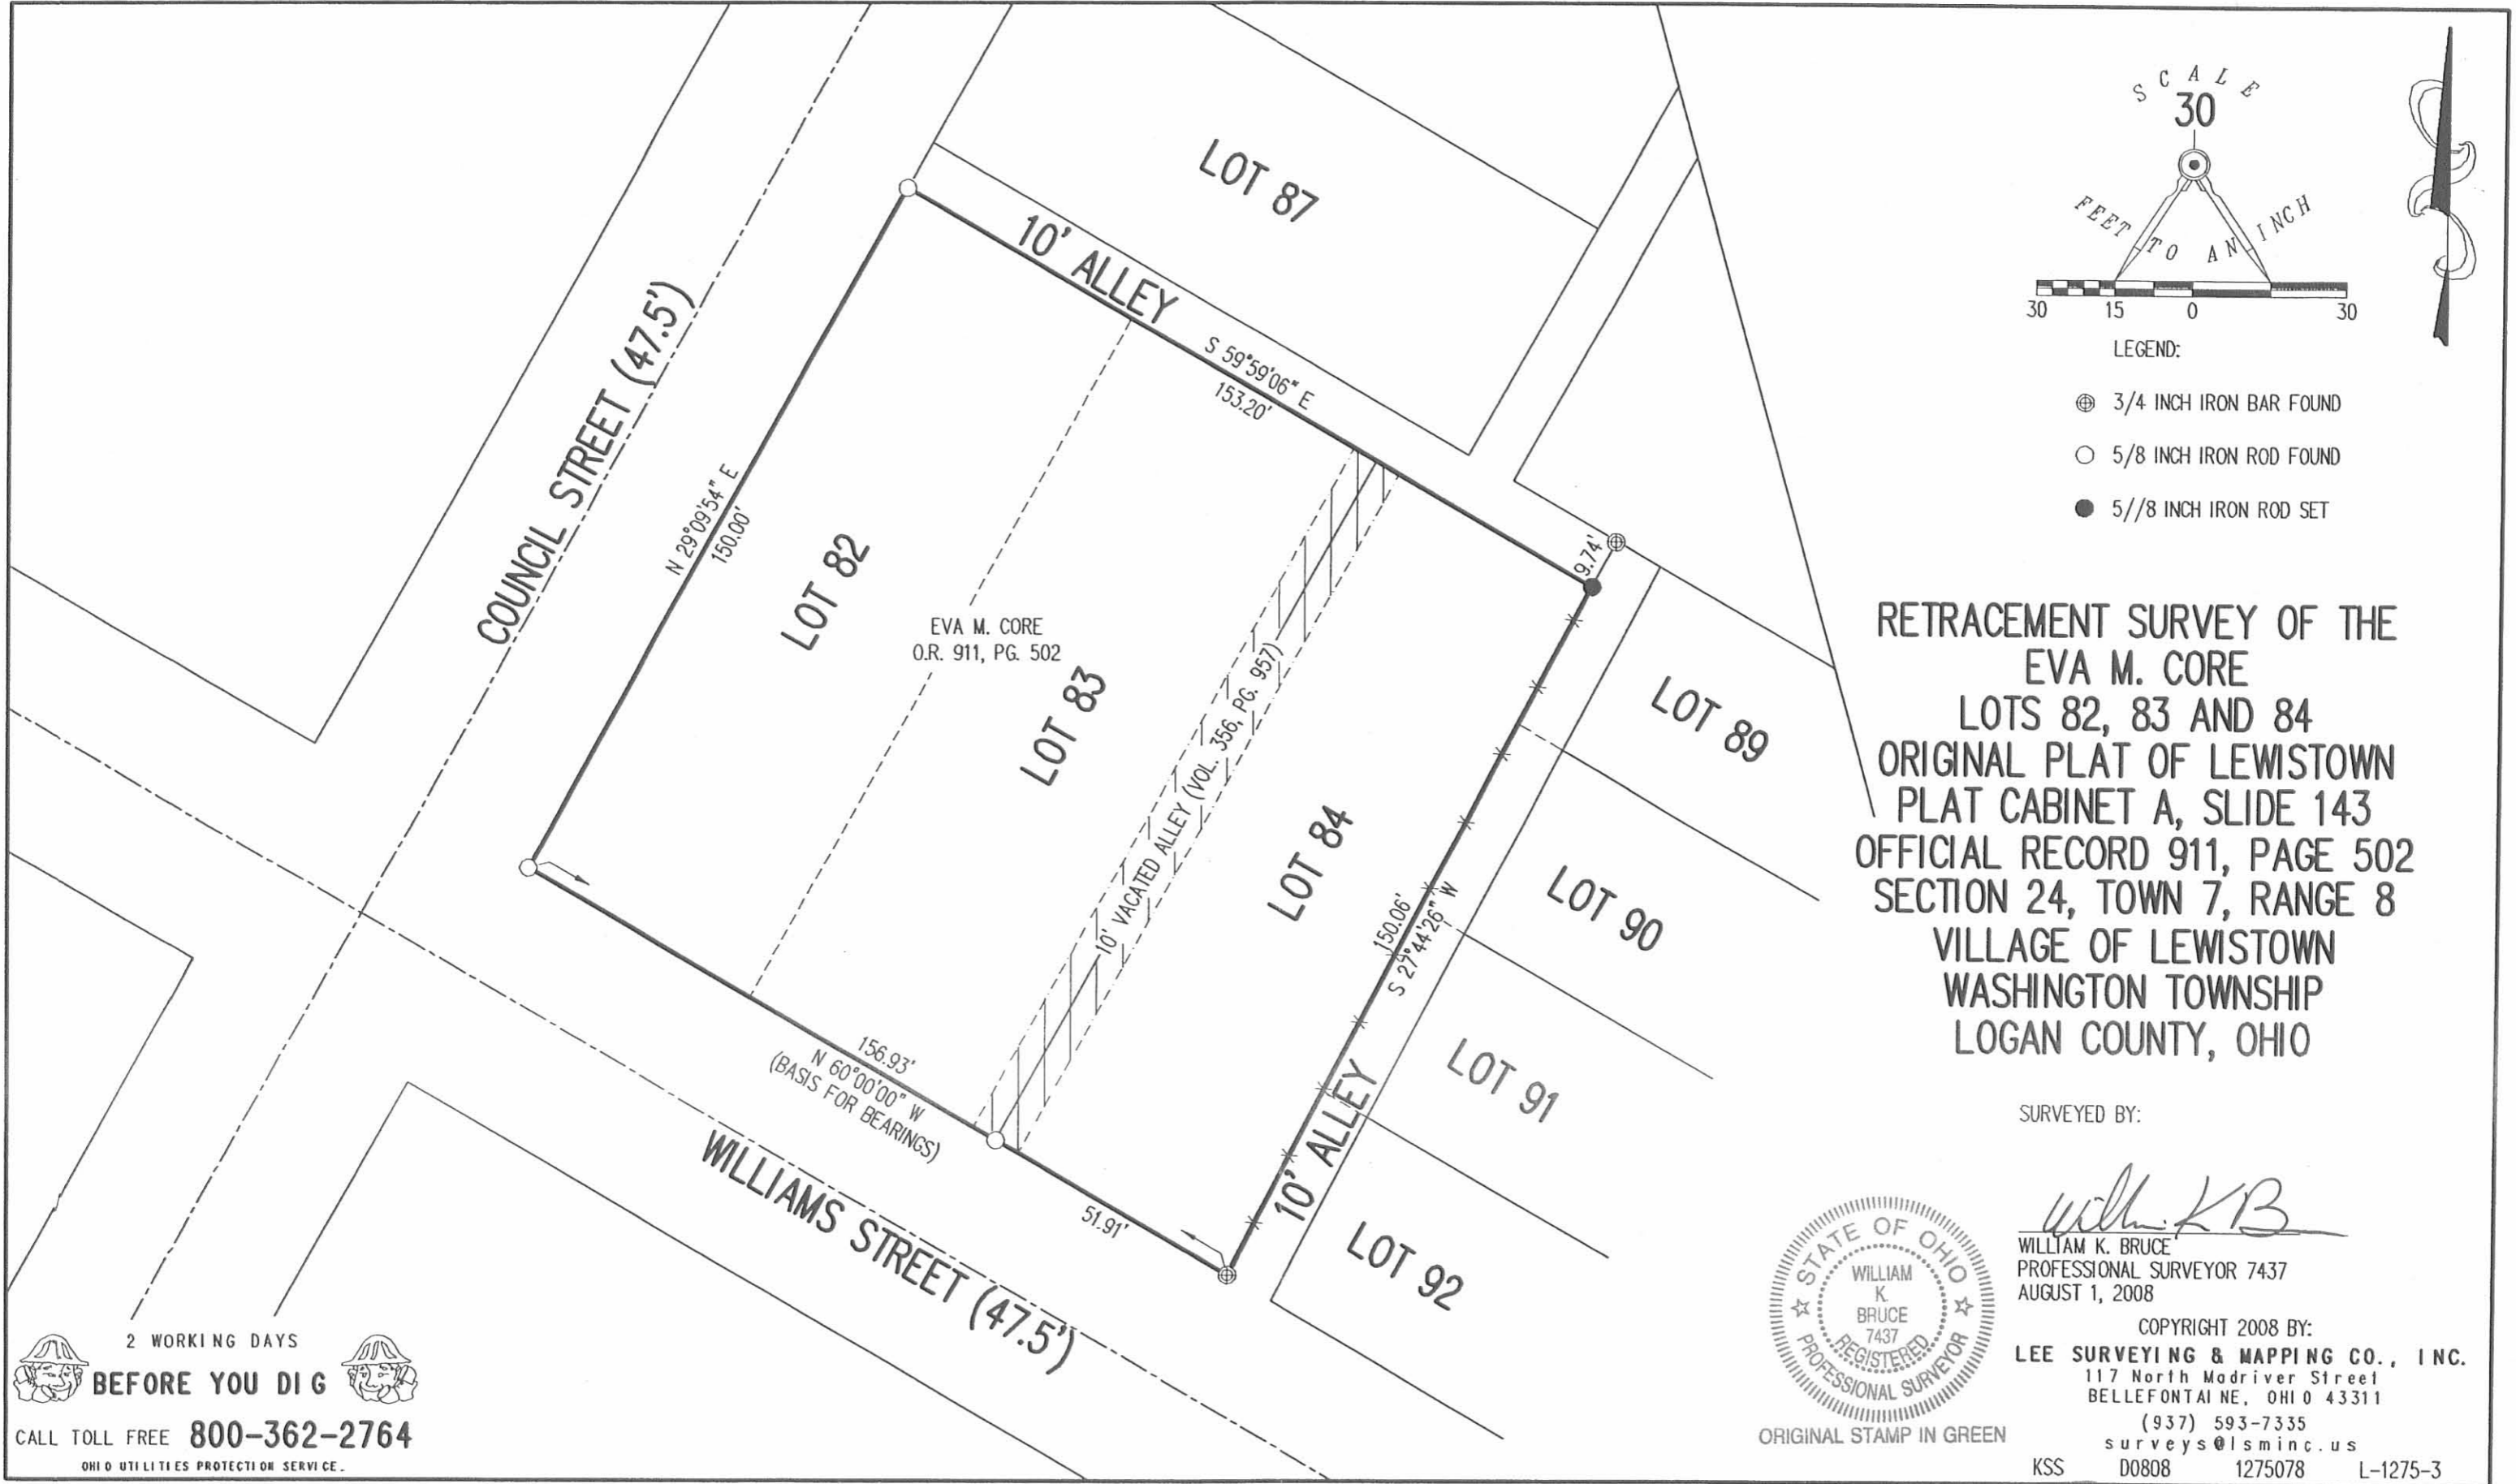

- LEGEND:
- ⊕ 3/4 INCH IRON BAR FOUND
 - 5/8 INCH IRON ROD FOUND
 - 5/8 INCH IRON ROD SET

RETRACEMENT SURVEY OF THE
EVA M. CORE
LOTS 82, 83 AND 84
ORIGINAL PLAT OF LEWISTOWN
PLAT CABINET A, SLIDE 143
OFFICIAL RECORD 911, PAGE 502
SECTION 24, TOWN 7, RANGE 8
VILLAGE OF LEWISTOWN
WASHINGTON TOWNSHIP
LOGAN COUNTY, OHIO

SURVEYED BY:

William K. Bruce

WILLIAM K. BRUCE
PROFESSIONAL SURVEYOR 7437
AUGUST 1, 2008



ORIGINAL STAMP IN GREEN

COPYRIGHT 2008 BY:
LEE SURVEYING & MAPPING CO., INC.
117 North Madriver Street
BELLEFONTAINE, OHIO 43311
(937) 593-7335
surveys@lsminc.us
KSS D0808 1275078 L-1275-3

2 WORKING DAYS
BEFORE YOU DIG
CALL TOLL FREE **800-362-2764**
OHIO UTILITIES PROTECTION SERVICE.

INDEXED ON MAP
5910 IP