


LESLIE H. GEESLIN
P. O. Box 274
RUSHSVLVANIA, OHIO 43347
(513) 468-2793

JOB Artist Island (SURVEY POINT RE.)
Washington Twp. (PLAT PAGE 44)
SHEET NO. Sec. 1, T. 7, R. 8 OF _____
Sec. 36, T. 6, R. 8
CALCULATED BY Zoggen Co. DATE _____
CHECKED BY _____ DATE 1-24-86
SCALE _____ DRAWN BY: D.L.G.

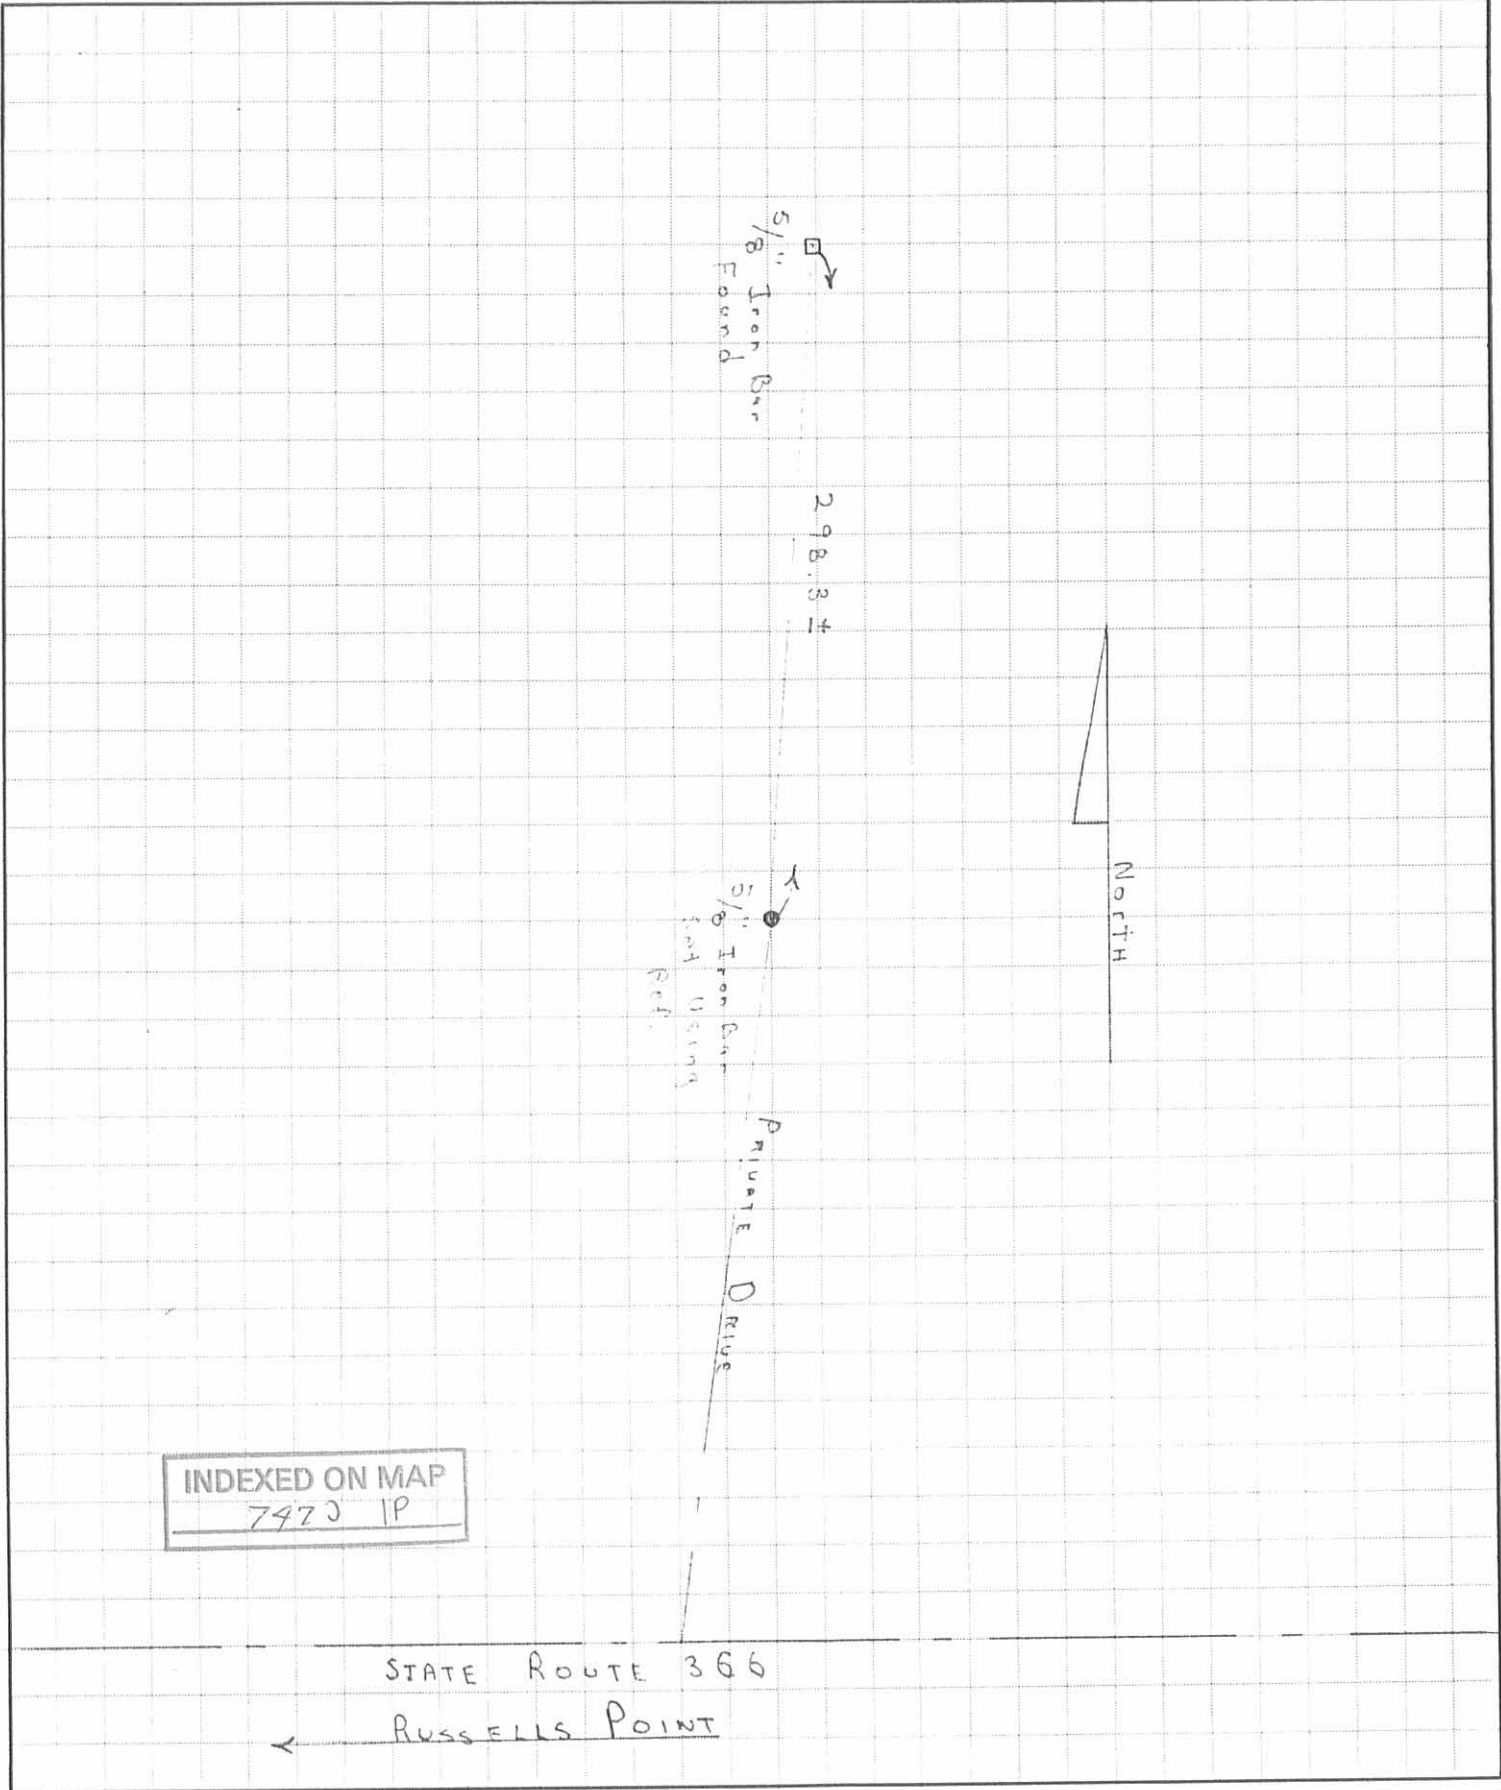

INDEXED ON MAP
7473 IP