


LESLIE H. GEESLIN
P. O. Box 274
RUSHSVLVANIA, OHIO 43347
(513) 468-2793


JOB SURVEY POINT REPLACEMENT
SHEET NO. FIVE PARKS ALLOTMENT
WASHINGTON TWP OF (PLAT PAGE 31)
LOGAN CO.
CALCULATED BY _____ DATE _____
CHECKED BY Survey Index DATE 11-30
SCALE _____ Drawn By: O.L.G. (1-23-86)

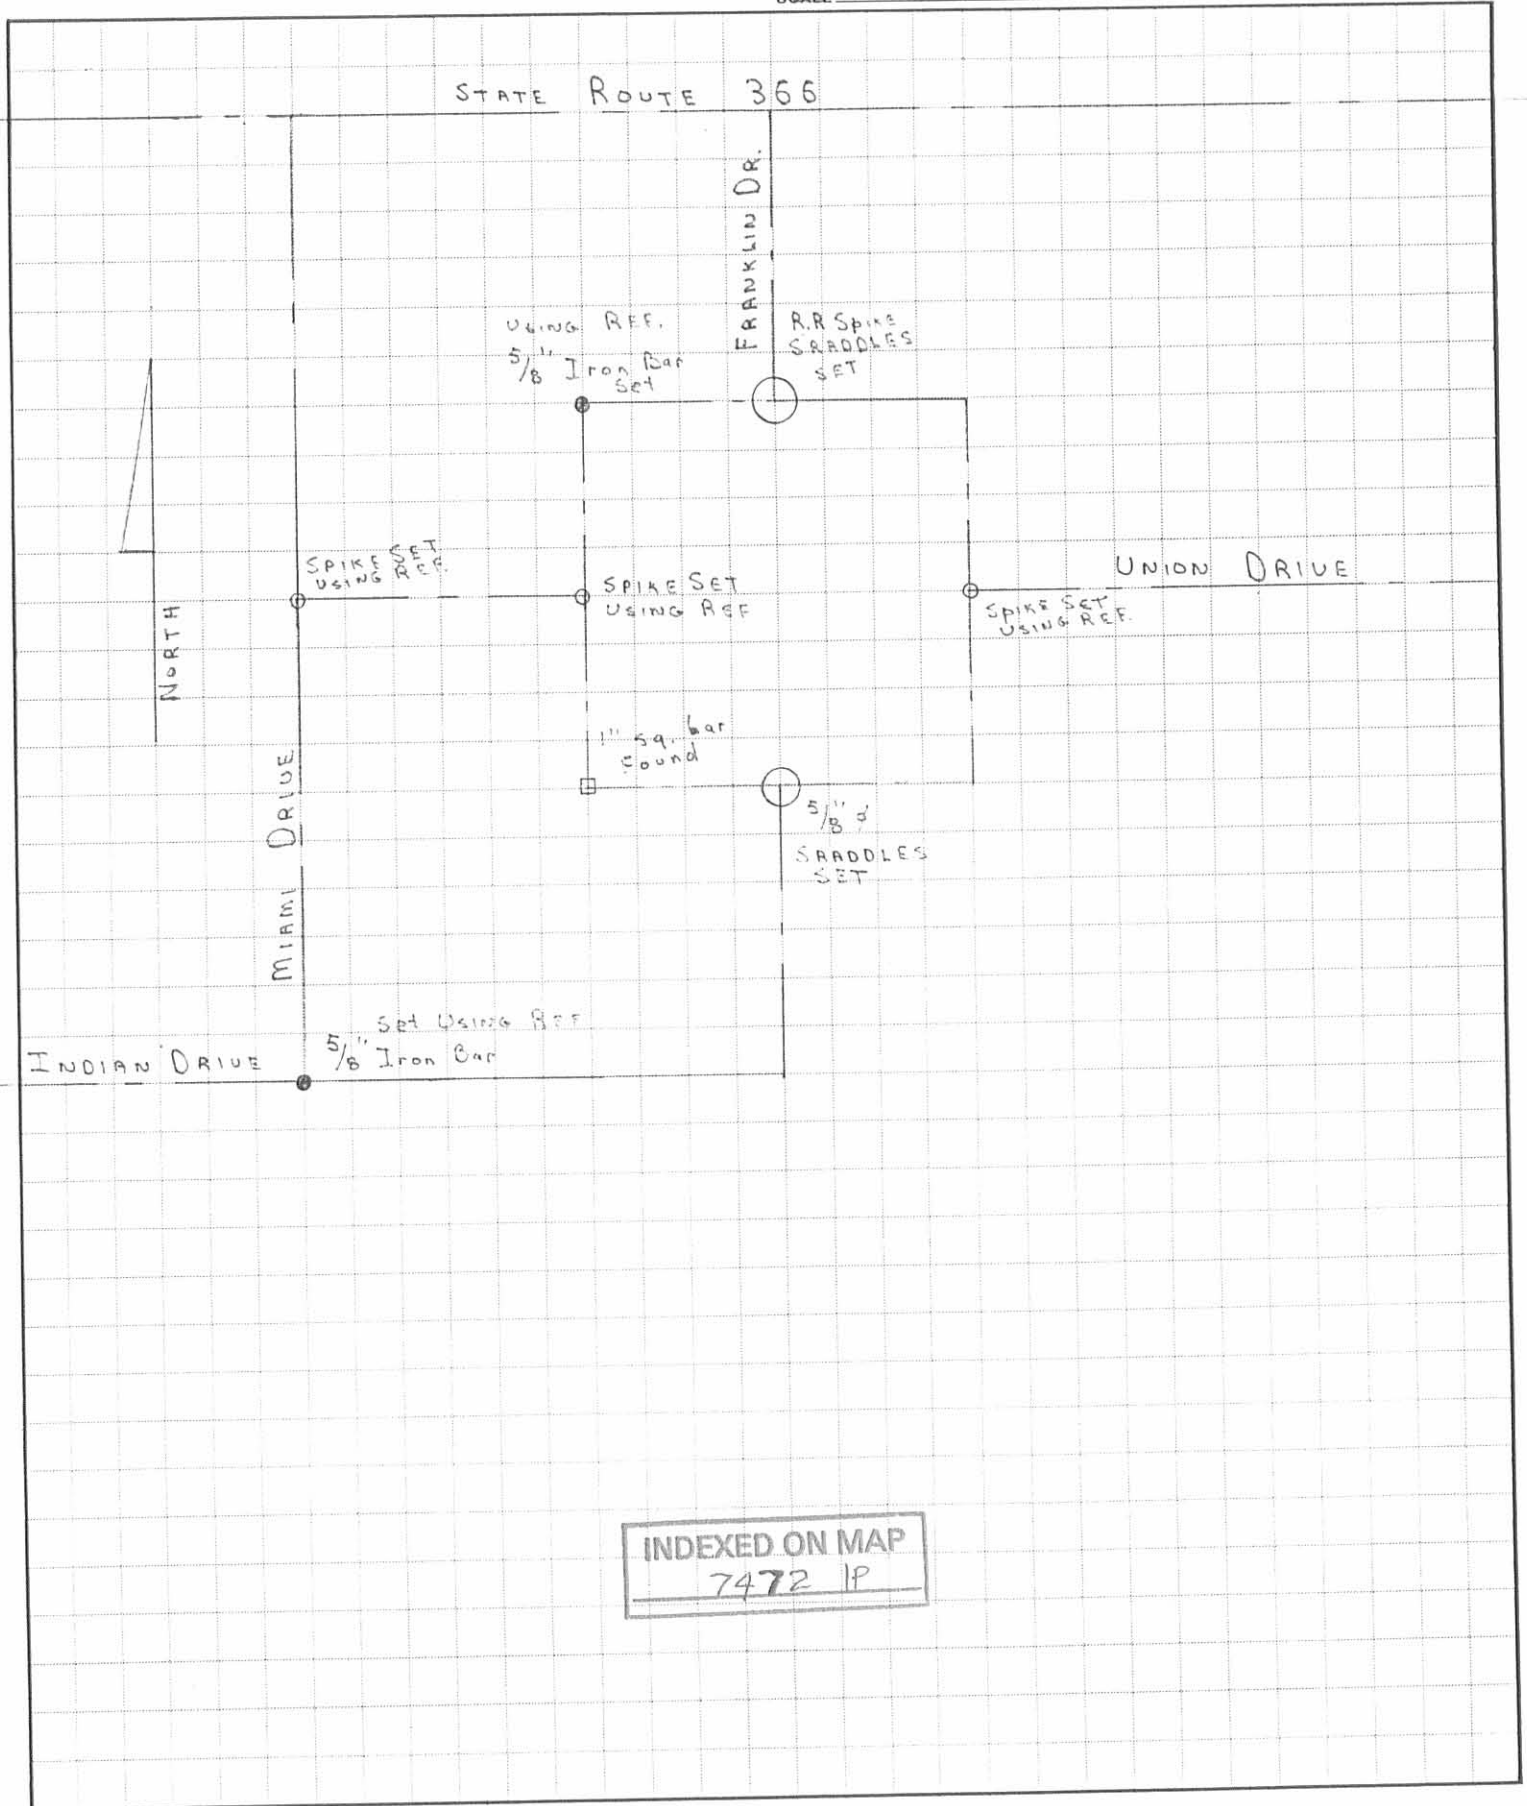

INDEXED ON MAP
7472 IP

LESLIE H. GEESLIN
 P. O. Box 274
 RUSHSVLVANIA, OHIO 43347
 (513) 468-2793

JOB FIVE PARKS ALLOTMENT (SURVEY POINT A)
 STREET Intersections
 SHEET NO. WASHINGTON Twp OF (PLAT PAGE 31)
LOGAN CO.
 CALCULATED BY _____ DATE _____
 CHECKED BY Survey Index P. 30 DATE 1-23-86
 SCALE None Drawn By: D. L. G.

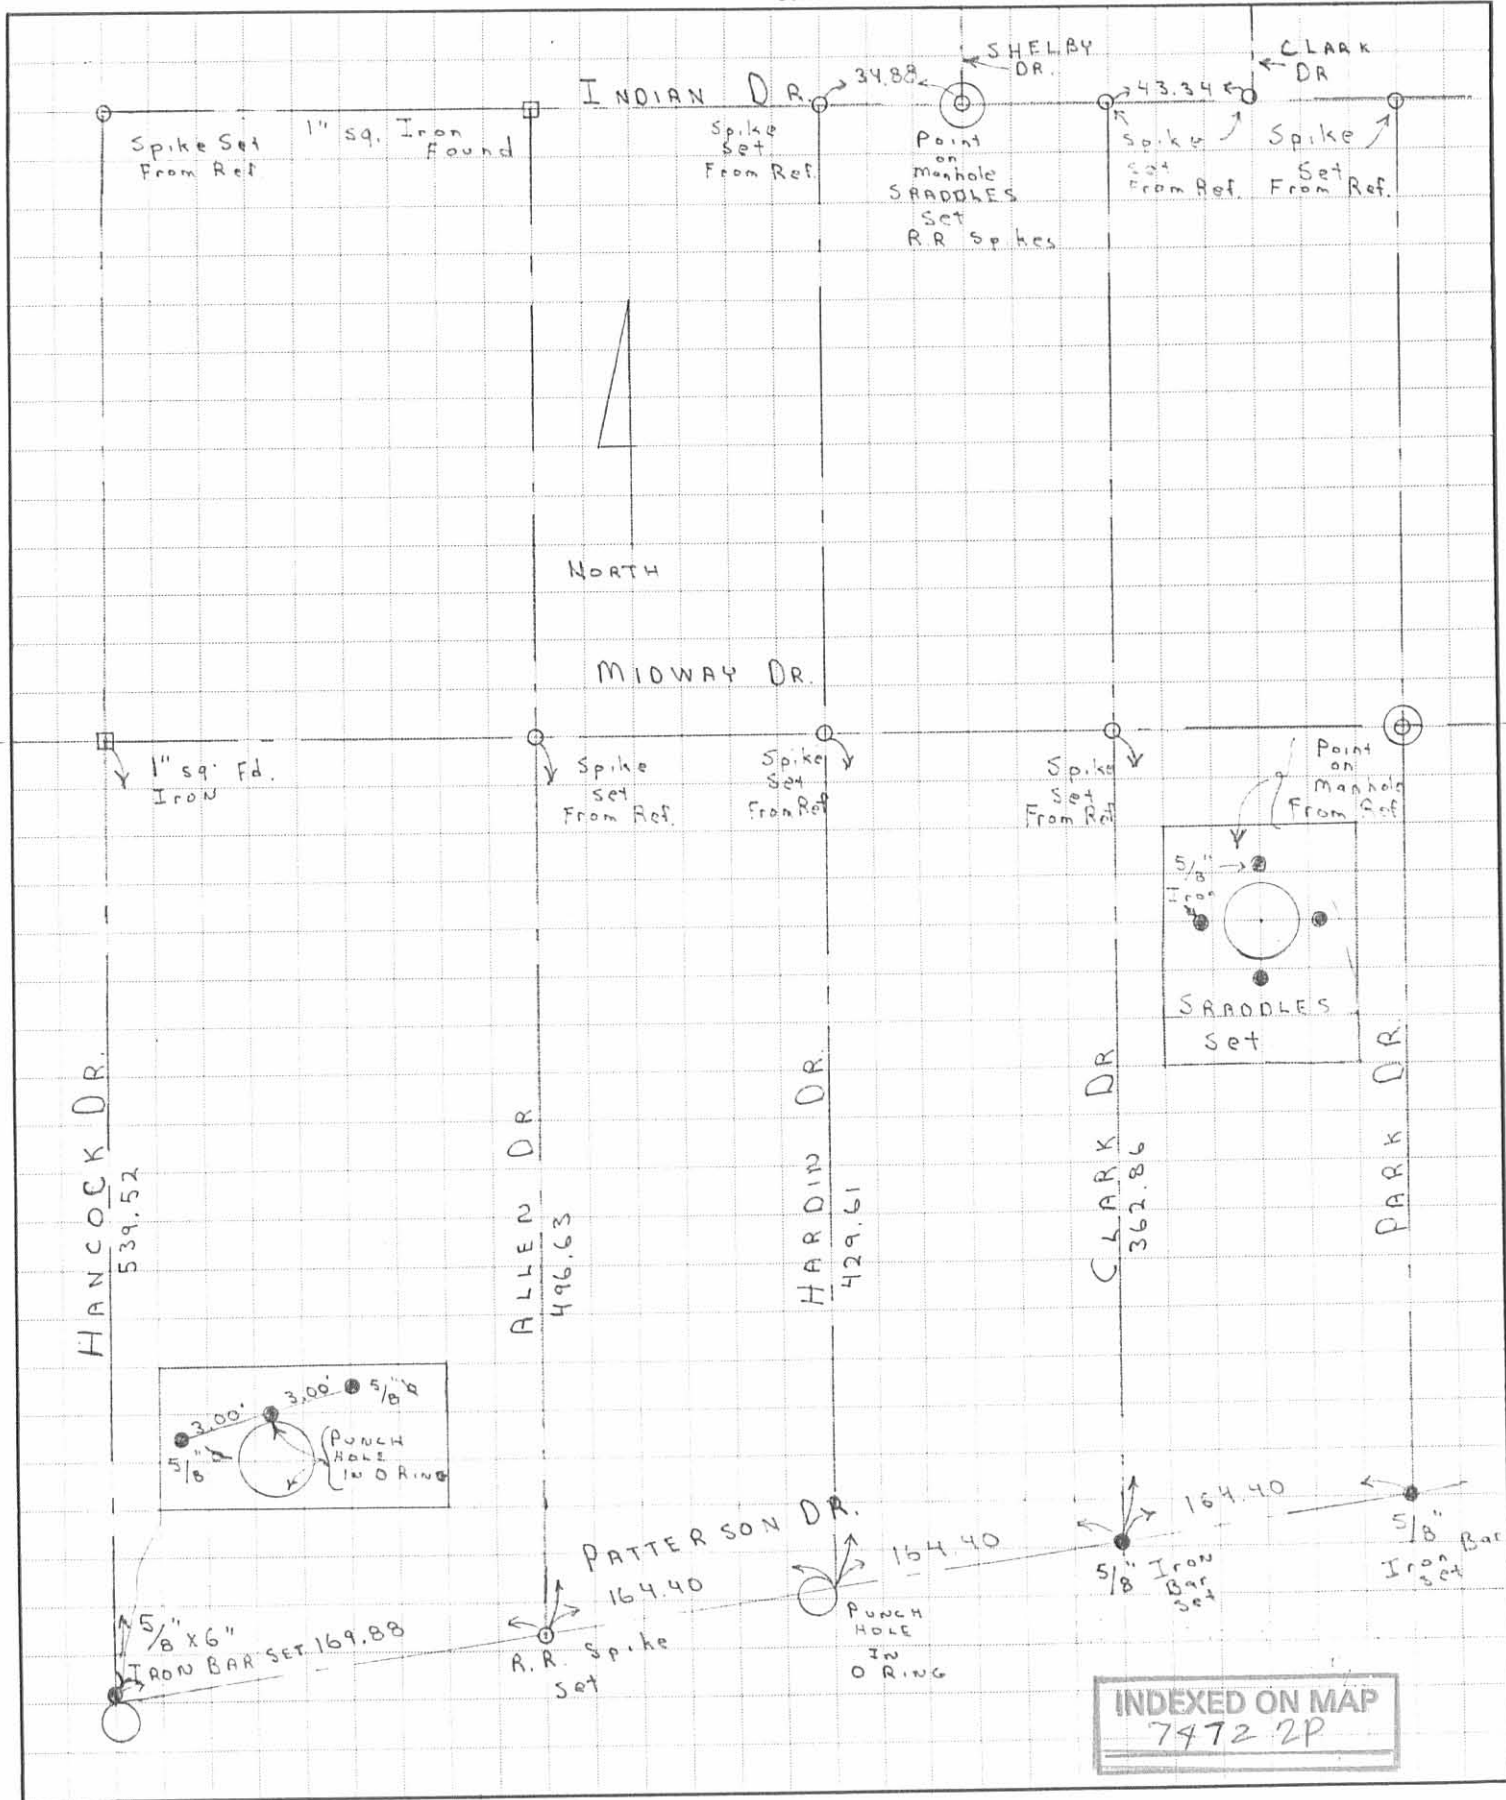

LESLIE H. GEESLIN
P. O. Box 274
RUSHSVLVANIA, OHIO 43347
(513) 468-2793

JOB SURVEY POINT REPLACEMENT
SHEET NO. FIVE PARKS ALLOTMENT (PLAT PAGE 21)
WASHINGTON TWP. OF
LOGAN CO.
CALCULATED BY: _____ DATE: _____
CHECKED BY Survey Index DATE 8-30
SCALE DRAWN BY: D.L.G (1-23-86)

