


265

N<sup>o</sup> 367

M.D.B

The annexed plot represents the sub-division of Military Survey N<sup>o</sup> 9895. The sub-division line runs at right angles with 1100 parallel to the boundary line of the Origin of Survey made Feb 25. 1837

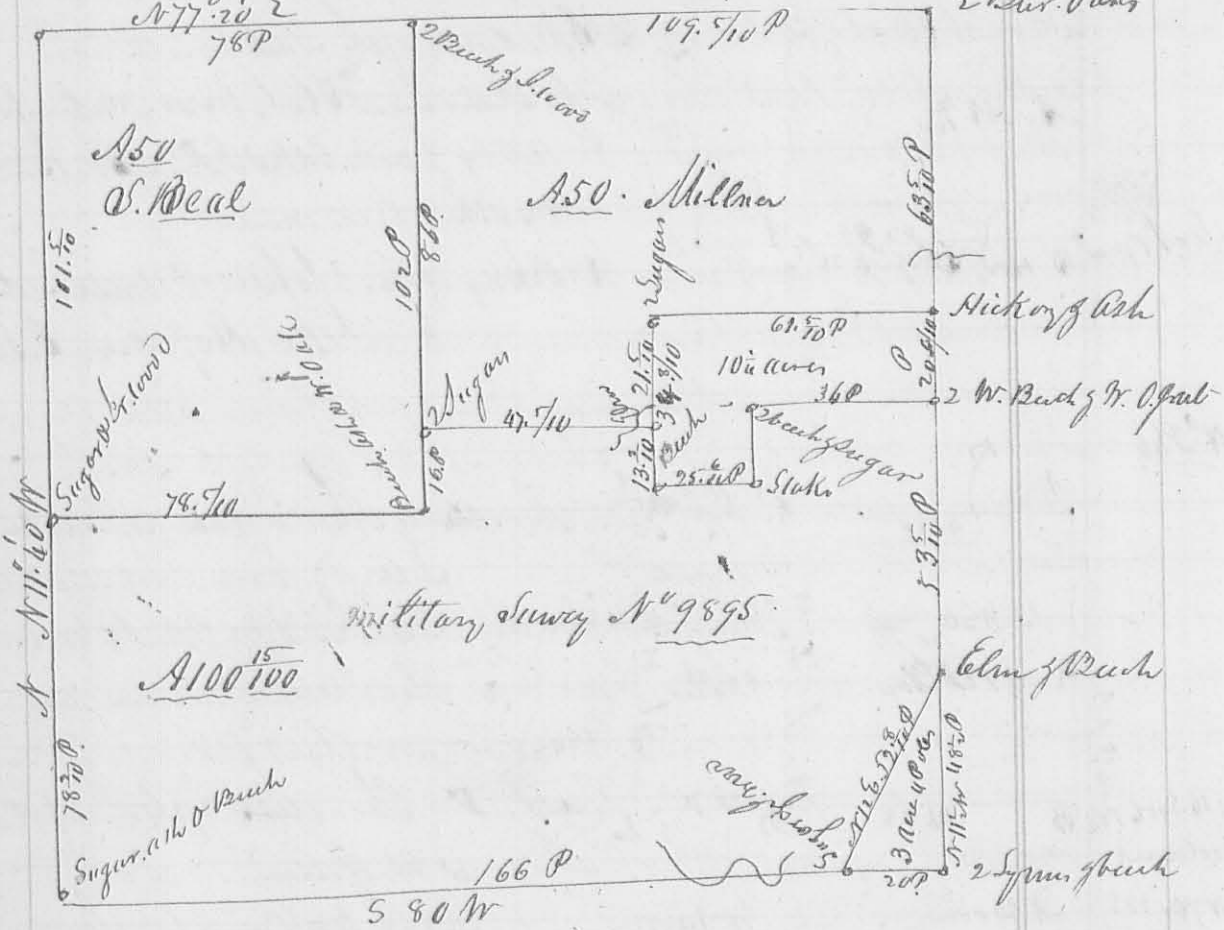


Samuel W. Truman  
Abraham Beavlin 3 Ch. Car?

Land of Kin Co. Sur. S. C. O.

69. S. 11. R. 14. M. Co. Sub-division March 10. 1837. See the plot

N<sup>o</sup> 368

8405

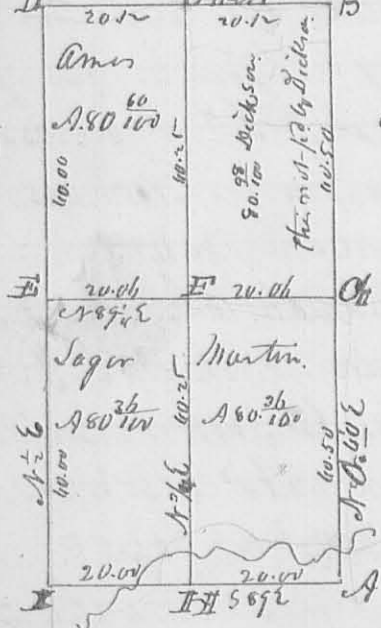

Description of C corners.  
 at A. White Oak 20 LD 563 W. 13 S. Cherry. down  
 B. Bearing tree down. Wh. O. 34 LD 544 W. 21 S. N 29 W. 21 S.  
 W. Oak 10. LD. 531 W. 67 Sinks.  
 C. Elm & LD 562 W. 9 Sinks. Same 4 LD. N 76 W. 21 S.  
 D. Original gr. corner with Oak 22 LD. N 80 W. 66 S.  
 - Wh. Oak & LD 568 W. 34 Sinks  
 E. W. Oak 34 LD. 568 W. 7 S. 20. 8 LD. 585 W. 53 S. Sinks  
 F. Bur. O. 30 LD. 559 W. 42 S. Bur. O. N 59 E. 11 W. Sinks.  
 G. Hickory 20. N. 146 69. R. Oak 7 LD. South 58 Sinks.  
 H. W. Oak 22 LD. N 55 W. 9 S. Same 12 LD. 588 W. 36 Sinks

I Walnut 10 LD. North 47 S. Hickory bush 586 Sinks.

Land of Kin Co. Sur. S. C. O.