

MINGO WAY - 30'

T.R. No. 269 Road - 30'
Waterbury

Patti A. Nichols
O.R. No. 8 P. 496 (9-21-1985)
51-032-12-22-035.000
0.206 Acres

N. 6°-01'-33" W.
80.00'

Basis of Bearing
N. 81°-58'-00" E. 160.13'

Cottonwood Enterprises, Inc.
Vol. No. 346 P. 695 (4-30-1973)
Tract VII
51-032-12-22-036.000

0.290 Acres

S. 6°-01'-35" E.
80.00'

Daniel F. Reames et ux
Vol. No. 366 P. 429 (9-3-1976)
51-032-12-22-037.000

0.130 Acres

S. 81°-58'-00" W. 160.17'

Cottonwood Enterprises, Inc.
Vol. No. 346 P. 695 (4-30-1973)
51-032-12-22-038.000

3.290 Acres

83.00'

Concrete Post Fd.

○ - 3/4" Iron Pipes Fd.

N

INDEXED ON MAP
8773 1P

Daniel E. Gilbert

DANIEL E. GILBERT, P.S.
REG. SUR. NO. 5402
400 N. PARK ST.
BELLEFONTAINE, OHIO 43311
TELEPHONE: 1 (513) 593-1428



Cottonwood Enterprises, Inc. Survey
Resurvey of 0.290 Acres
V.M.S. No. 9925-9946-10121
Washington Township
Logan County, Ohio
December 17, 1992




Scale: 1" = 30'

092-056

Lot # 24 & 25
Waterburys' Unrecorded Plot

Washington Twp.

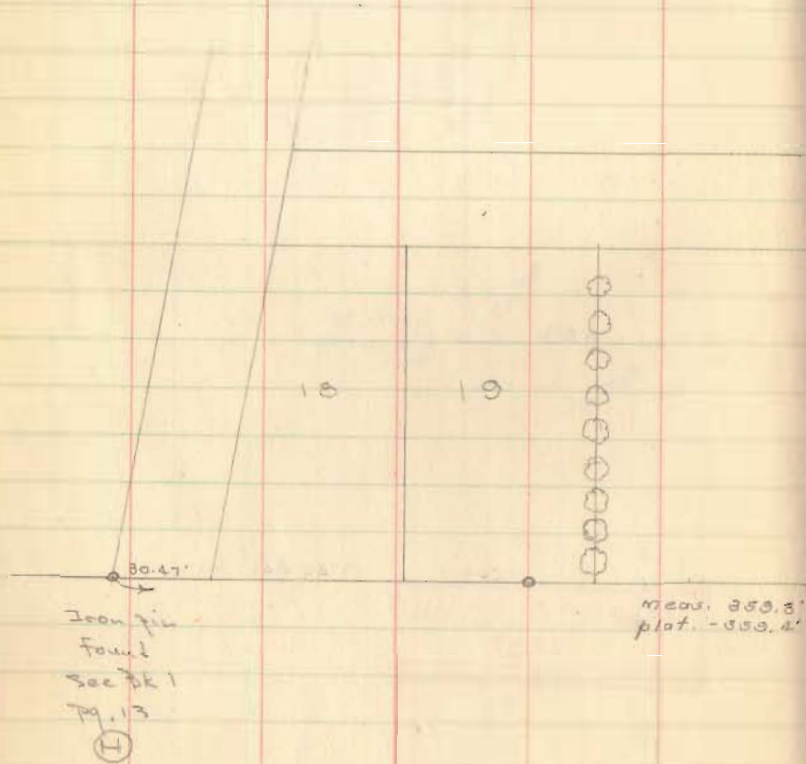


INDEXED ON MAP
8773

Dodson
Richardson

Feb. 19, 1955

50°
cloudy & rain 24

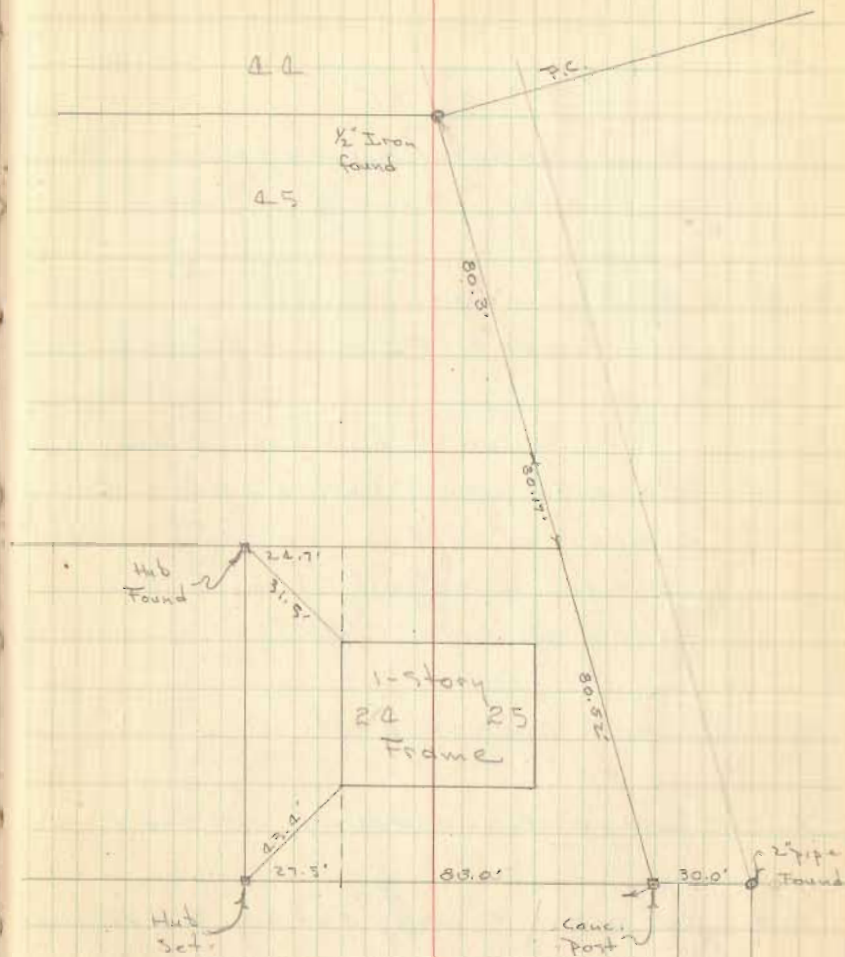

INDEXED ON MAP
8773