

- LEGEND:**
- 5/8" IRON ROD SET
 - 1 1/2" IRON PIPE FOUND
 - 1" IRON PIPE FOUND

REFERENCE:

1. LOGAN COUNTY ENGINEER'S SURVEY RECORDS, DRAWER "R", FILE NO. 4044.

RETRACEMENT SURVEY OF THE
 MARIE JEAN BRADFORD LOTS 7 AND 8
 DEED VOLUME 407, PAGE 114
 SMITH ALLOTMENT NUMBER 2
 VIRGINIA MILITARY SURVEY 9925-9946-10121
 WASHINGTON TOWNSHIP
 LOGAN COUNTY, OHIO

INDEXED ON MAP
8997 1P

2 WORKING DAYS
BEFORE YOU DIG

CALL TOLL FREE **800-362-2764**
 OHIO UTILITIES PROTECTION SERVICE




SURVEYED BY:
Jeffrey I. Lee
 JEFFREY I. LEE
 PROFESSIONAL SURVEYOR 6359
 JULY 19, 1993

LEE SURVEYING & MAPPING CO.
 143 East Columbus Avenue
 BELLEFONTAINE, OHIO 43311
 (513) 593-7335


ORIGINAL STAMP IN GREEN

D 221 MARYHALL L-1224-4

REC'D 3-27-95 Sully

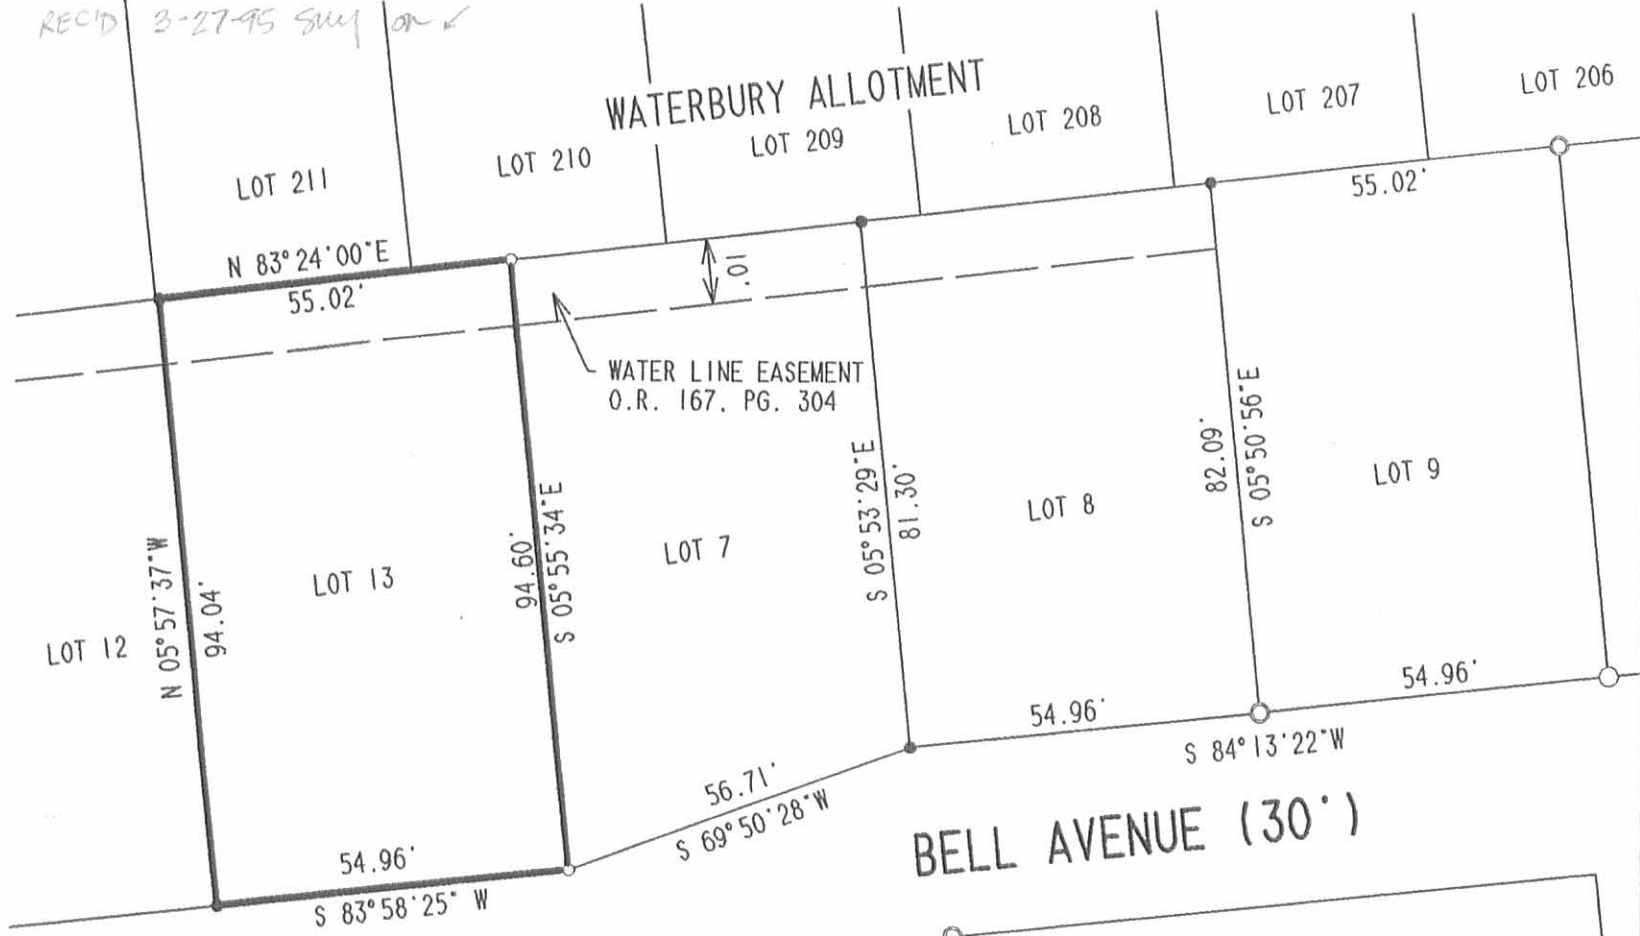

SMITH STREET (30')

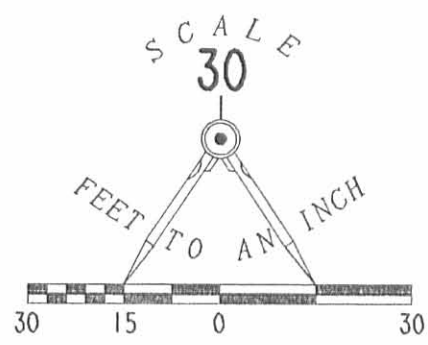

LEGEND:

- 5/8" IRON ROD SET
- 1 1/2" IRON PIPE FOUND
- 1" IRON PIPE FOUND
- 5/8" I. ROD FOUND

REFERENCE:

1. LOGAN COUNTY ENGINEER'S SURVEY RECORDS, DRAWER "R", FILE NO. 4044.

RETRACEMENT SURVEY OF LOT 13
 SMITH ALLOTMENT NUMBER 2
 VIRGINIA MILITARY SURVEY 9925-9946-10121
 WASHINGTON TOWNSHIP
 LOGAN COUNTY, OHIO

INDEXED ON MAP
 8997 2P



CALL TOLL FREE **800-362-2764**
 OHIO UTILITIES PROTECTION SERVICE.



ORIGINAL STAMP IN GREEN

SURVEYED BY:

JEFFREY I. LEE
 PROFESSIONAL SURVEYOR 6359
 MARCH 21, 1995

COPYRIGHT 1995 BY:
LEE SURVEYING & MAPPING CO.
 143 East Columbus Avenue
 BELLEFONTAINE, OHIO 43311
 (513) 593-7335

D 255 JHURLEY L-1224-4