

EDWARDS SURVEYING 110 SOUTH MAIN STREET URBANA, OHIO 43078

(937) 653-6508

LEGAL DESCRIPTION - 0.009 ACRE TRACT - TRACT 1 STATE OF OHIO INDIAN LAKE EXCESS LANDS

Being situate in the State of Ohio, County of Logan, Township of Washington and being a part of Section 36, Town 6, Range 8 and being more particularly described as follows;

Beginning for reference at an iron bar set at the Northwest comer of Lot 46-182 of the Indian Lake Reservoir Lands, as recorded in Plat Cabinet "A", Slide 447 of the Logan County Plat Records, said Lot also being known as Crystal Beach;

thence with a West line of said Lot 46-182, S-22°45'00"-W, 115.78' (feet) to a point, passing for reference an iron bar set at 6.60' (feet);

thence with a Southwesterly line of said Lot 46-182, S-39°34'00"-E, 10.00' (feet) to a point at the PRINCIPLE PLACE OF BEGINNING for the tract hereinafter described:

thence continuing with the bounds of Lot 46-182 the following three (3) courses:

- S-39°34'00"-E, 19.09' (feet) to an iron bar set, passing for reference an iron bar set at 6.44' (feet);
- 2. S-20°07'00"-E, 17.53' (feet) to an iron bar set;
- 3. S-51°55'00"-E, 22.21' (feet) to a point on the existing shore line of Indian Lake from which an iron bar set for reference bears N-38°05'00"-E, 10.00' (feet);

thence with the existing shore line of Indian Lake the following three (3) courses:

- 1. N-67°11'41"-W, 20.10' (feet) to a point;
- 2. N-49°58'52"-W, 25.70' (feet) to a point:
- 3. N-7°03'-09"-E, 20.71' (feet) to the place of beginning.

Containing 0.009 acre, but being subject to the rights of all legal highways and all easements of record.

Being a part of the State of Ohio, Indian Lake Excess Lands.


The herein described tract is to be attached to the mentioned and adjoining Lot 46-182 and is not to be used as a separate and independent parcel.

The foregoing description prepared by and in accordance with a Survey by William D. Edwards, Professional Surveyor No. 7574, November 14, 2001. All iron bars set are 5/8"x30" iron re-bar with a yellow plastic cap stamped "EDWARDS PS 4792 PS 7574". The basis of bearings for the herein described tract is the North line of Lot 46-182 per Plat Number 21 of the Indian Lake Reservoir Lands (N-85°00'00"-E).

WILLIAM D. TOTAL CONTROLL OF THE OF OATON TO THE OF OATON TO THE OATON

William D. Edwards

Professional Surveyor No. 7574

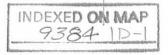





EDWARDS SURVEYING 110 SOUTH MAIN STREET URBANA, OHIO 43078 (937) 653-6508



LEGAL DESCRIPTION - 0.051 ACRE TRACT - TRACT 2 STATE OF OHIO INDIAN LAKE EXCESS LANDS

Being situate in the State of Ohio, County of Logan, Township of Washington and being a part of Section 36, Town 6, Range 8 and being more particularly described as follows;

Beginning at an iron bar set at the Northwest corner of Lot 46-182 of the Indian Lake Reservoir Lands, as recorded in Plat Cabinet "A", Slide 447 of the Logan County Plat Records, also known as Crystal Beach;

thence with a West line of said Lot 46-182, S-22°45'00"-W, 6.60' (feet) to an iron bar set;

thence with the existing shore line of Indian Lake the following five (5) courses:

- 1. N-59°06'16"-W, 27.11' (feet) to an iron bar set;
- 2. N-10°56'46"-W, 6.72' (feet) to an iron bar set:
- 3. N-87°04'41"-E, 96.50' (feet) to an iron bar set
- 4. S-82°48'03"-E, 65.32' (feet) to an iron bar set;
- 5. S-63°44'05"-E, 51.63' (feet) to an iron bar set at a North corner of aforementioned Lot 46-182;

thence N-75°27'00"-W, 81.76' (feet) to an iron bar set at another North corner of Lot 46-182;

thence with a North line of Lot 46-182, S-85°00'00"-W, 101.63' (feet) to the place of beginning.

Containing 0.051 acre, but being subject to the rights of all legal highways and all easements of record.

Being a part of the State of Ohio, Indian Lake Excess Lands.


The herein described tract is to be attached to the mentioned and adjoining Lot 46-182 and is not to be used as a separate and independent parcel.


The foregoing description prepared by and in accordance with a Survey by William D. Edwards, Professional Surveyor No. 7574, November 14, 2001. All iron bars set are 5/8"x30" iron re-bar with a yellow plastic cap stamped "EDWARDS PS 4792 PS 7574". The basis of bearings for the herein described tract is the North line of Lot 46-182 per Plat Number 21 of the Indian Lake Reservoir Lands (N-85°00'00"-E).

WILLIAM D. SUNCE OF ON THE OF ON THE

William D. Edwards

Professional Surveyor No. 7574

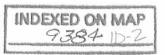

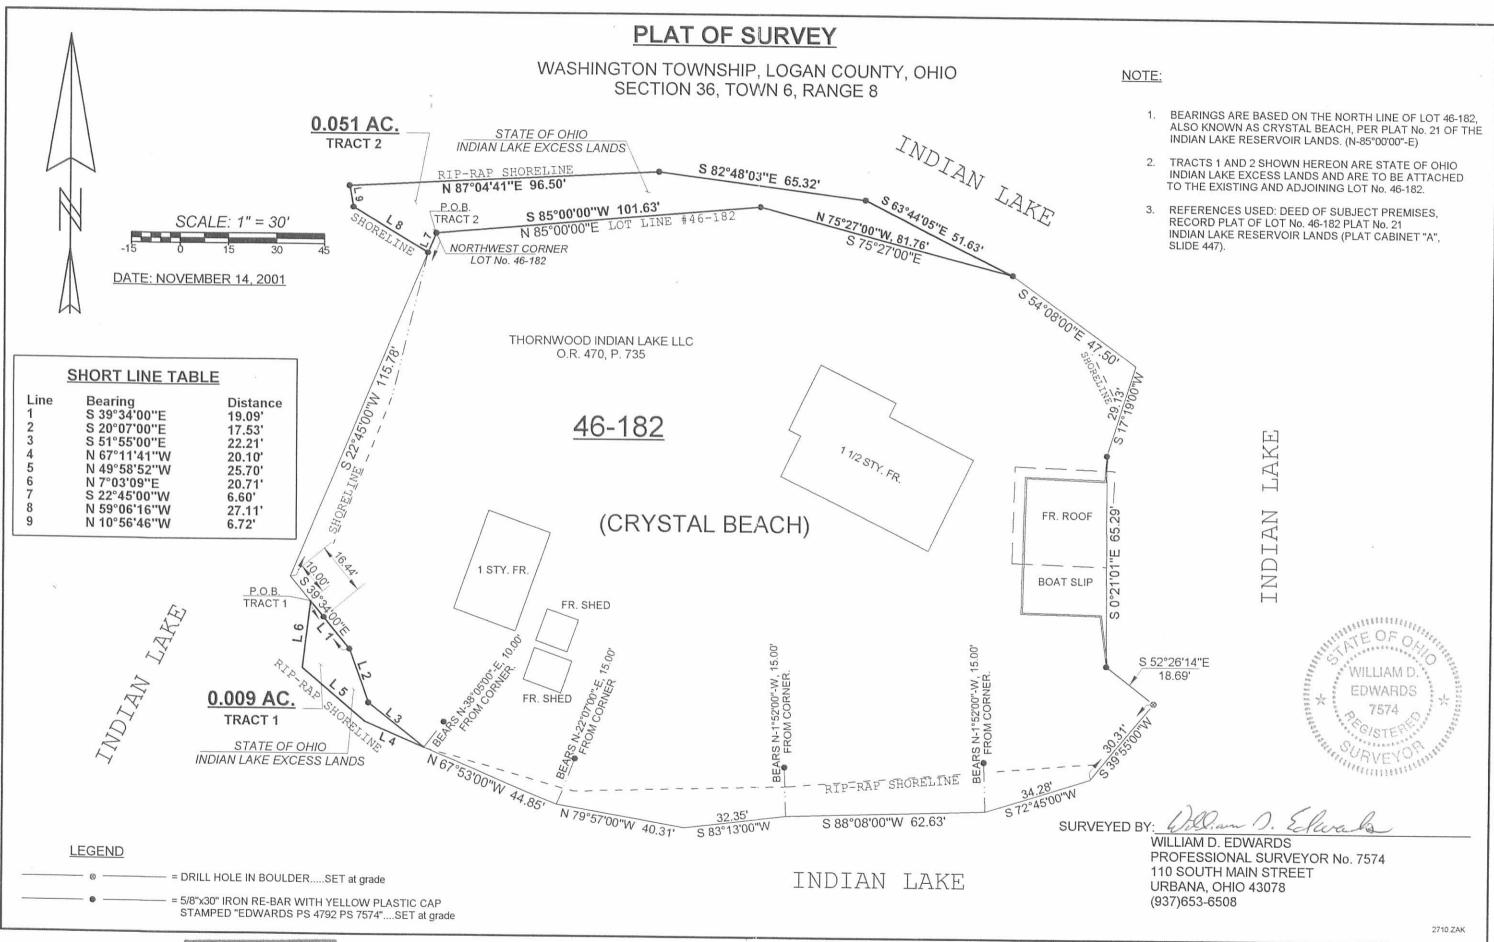

INDEXED ON MAP 9384 IP