



REC 1-2-03 SMY OK

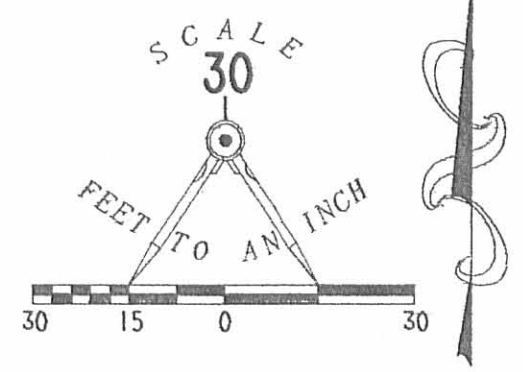

- LEGEND**
- 5/8 INCH IRON ROD SET
  - 5/8 INCH IRON ROD FOUND
  - 1 INCH IRON PIPE FOUND
  - ⊗ 3/4 INCH IRON PIPE FOUND

**RETRACEMENT SURVEY OF  
 LOTS 69 AND 92  
 WATERBURY ALLOTMENT  
 PLAT CABINET A. SLIDE 223  
 VIRGINIA MILITARY SURVEY 9925  
 WASHINGTON TOWNSHIP  
 LOGAN COUNTY, OHIO**

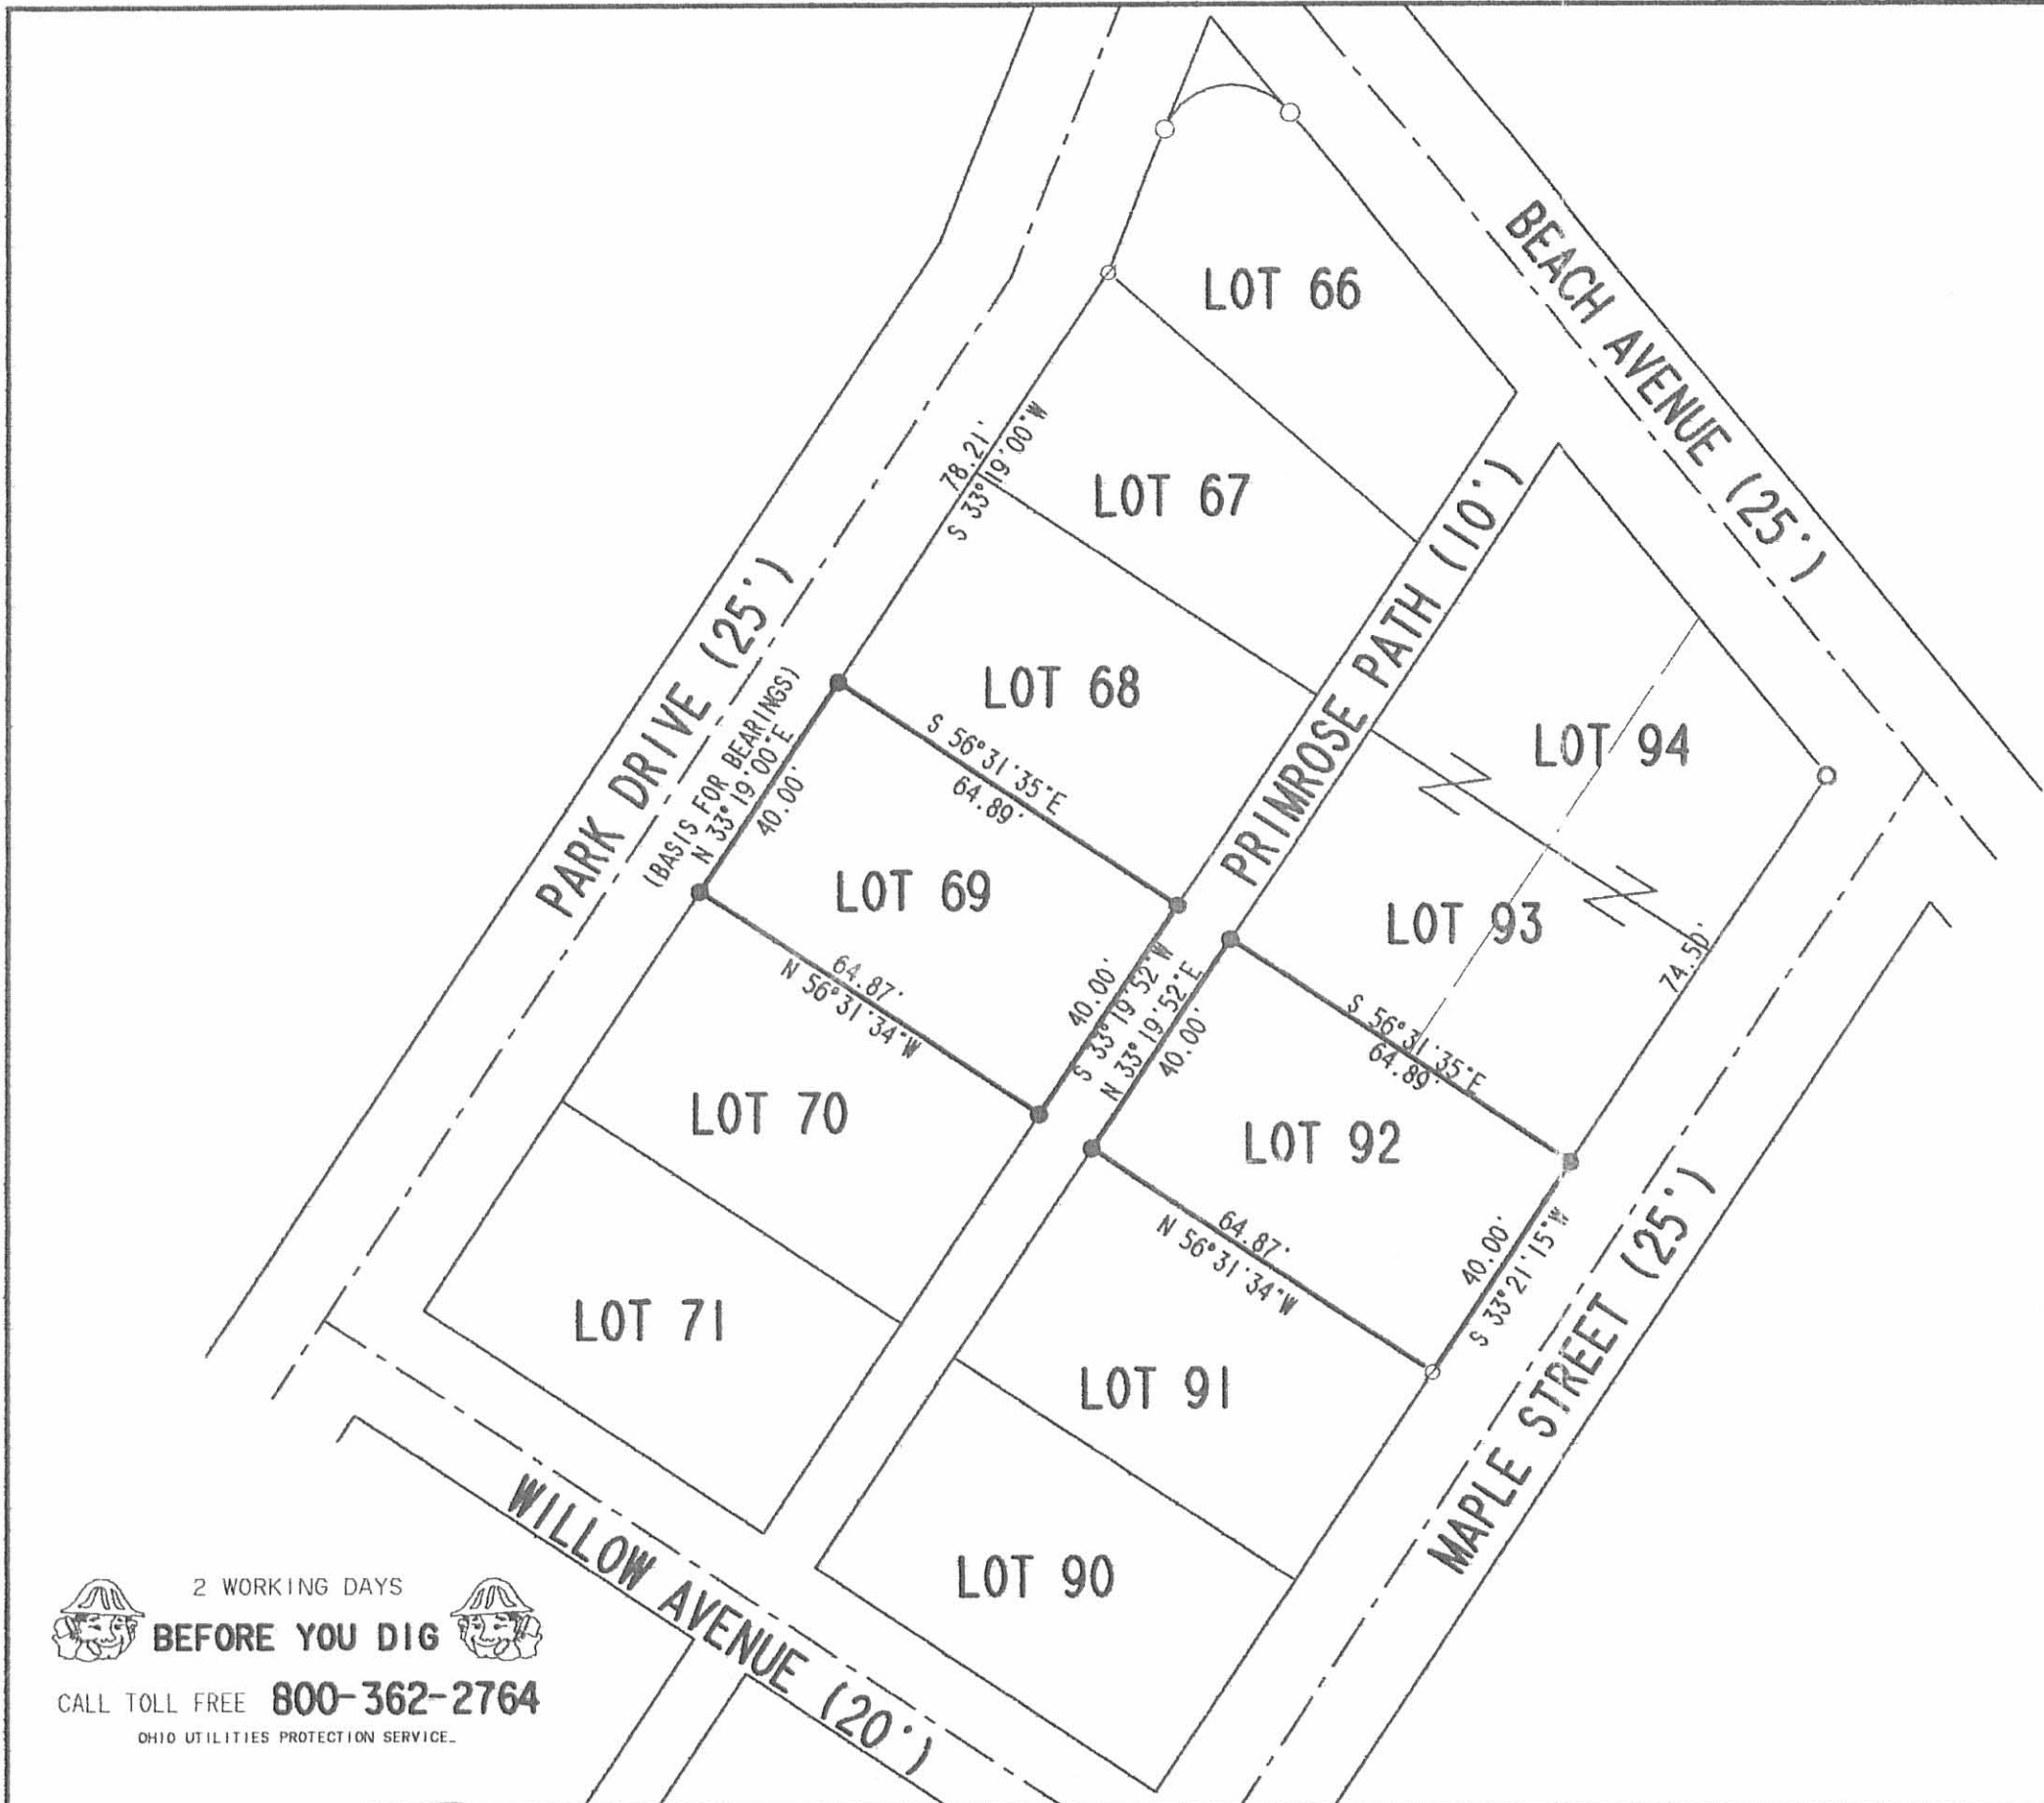

ORIGINAL STAMP IN GREEN

SURVEYED BY:  
  
 JEFFREY I. LEE  
 PROFESSIONAL SURVEYOR 6359  
 DECEMBER 9, 2002

COPYRIGHT 2002 BY:  
**LEE SURVEYING & MAPPING CO., INC.**  
 117 North Madriver Street  
 BELLEFONTAINE, OHIO 43311  
 (937) 593-7335

2 WORKING DAYS  
**BEFORE YOU DIG**  
 CALL TOLL FREE **800-362-2764**  
 OHIO UTILITIES PROTECTION SERVICE.

INDEXED ON MAP  
 9426 1P