


SURVEY OF
LOT NO. 23 IN THE ORIGINAL TOWN PLAT OF THE VILLAGE OF
WEST LIBERTY, LOGAN COUNTY, OHIO.

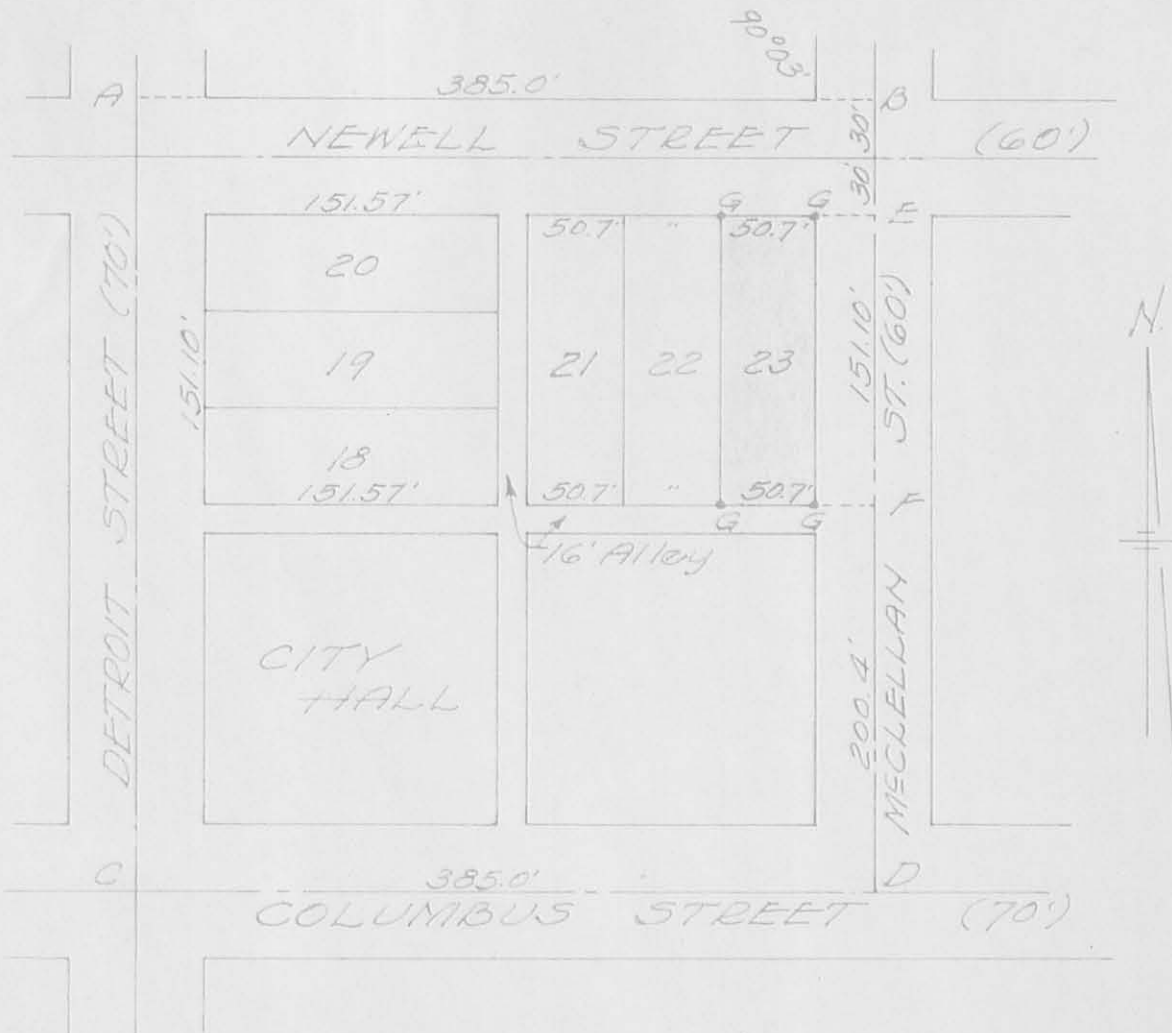

NOTES:

- * Line A-C established as centerline between curbs.
- * Line C-D established as 1.3' North of centerline between curbs.
- * Line B-D established at recorded distances from center of Detroit Street.
- * Angle at B as recorded.
- * Lots 18, 19 and 20 sized as recorded.
- F-set point per recorded distances in previous survey.
- G-set Iron Pipe as shown.

* as per Inskip survey, book #13, page 124.

I hereby certify the above Survey and Plat to be correct.
Surveyed January 16, 1960.

Cecil E. Mengerink
Cecil E. Mengerink
Registered Surveyor #3151.

INDEXED ON MAP
2511 1P