


DETROIT ST. 70'

28

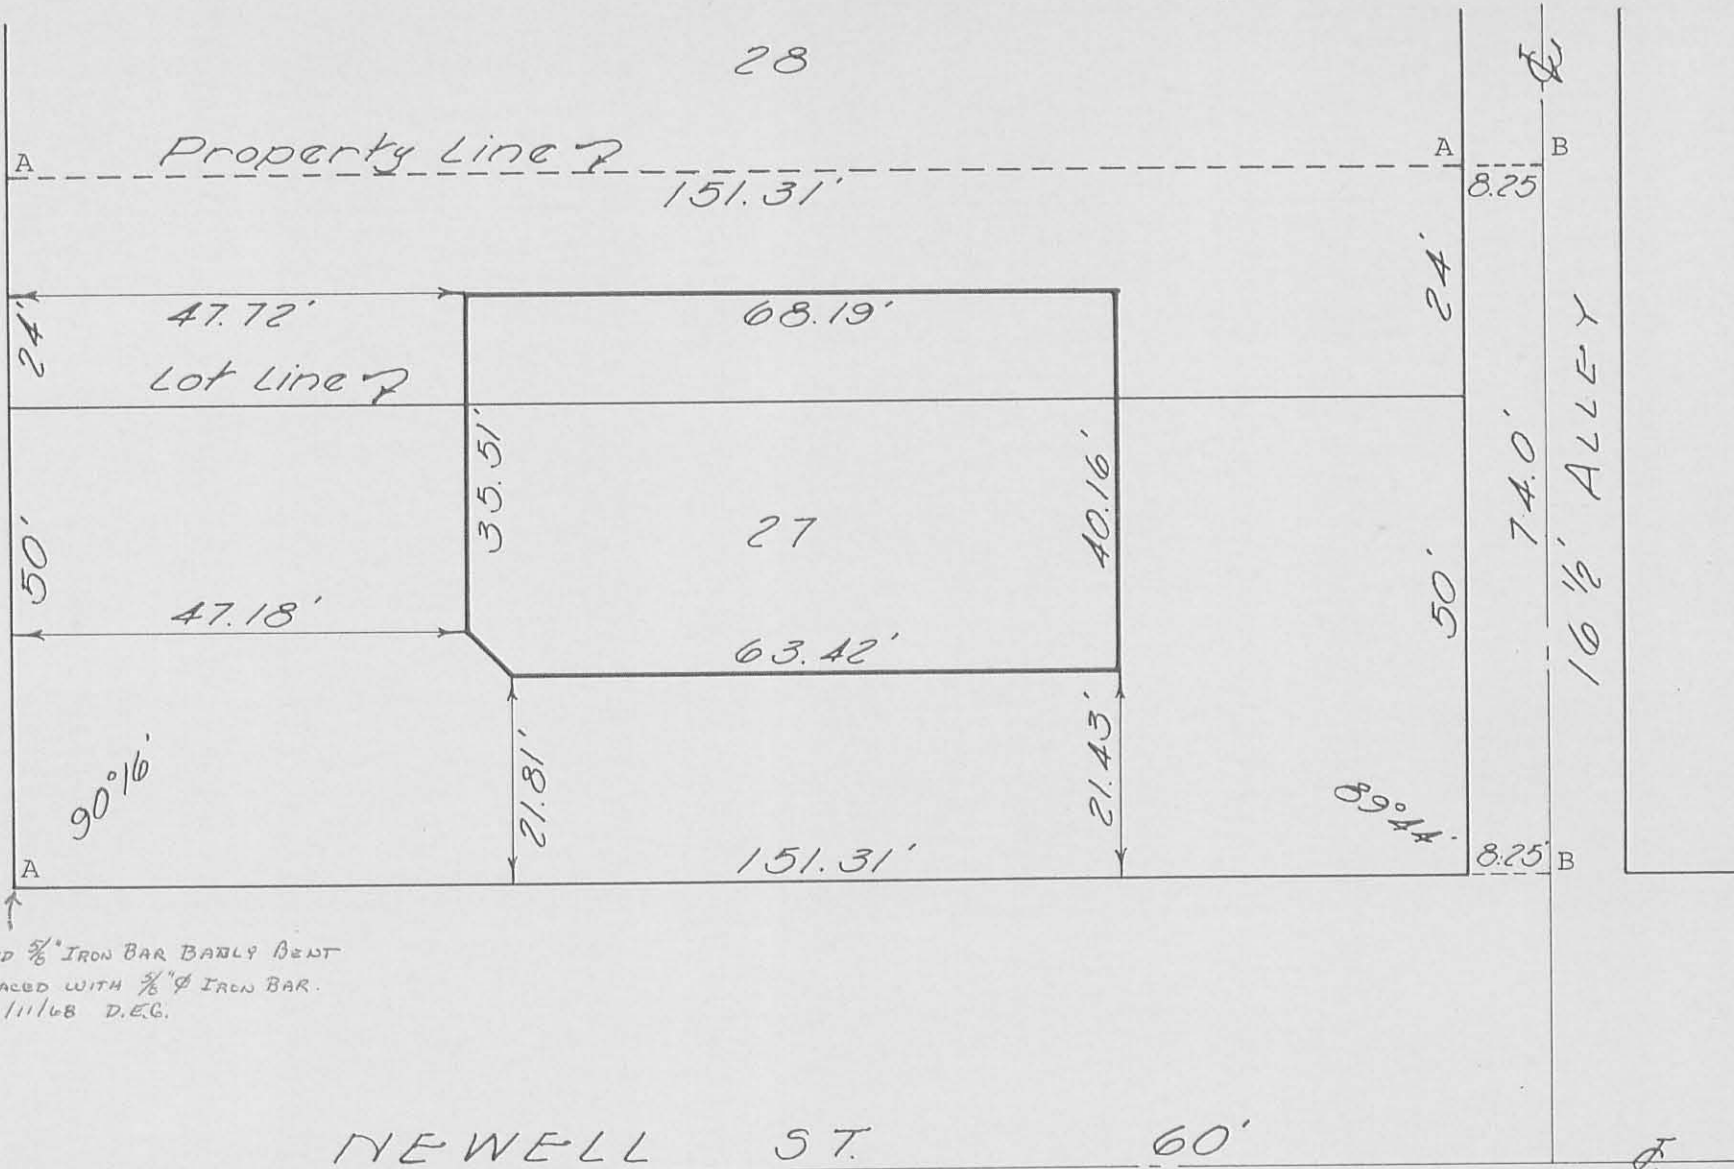

FOUND 5/8" IRON BAR BARELY BENT
 REPLACED WITH 5/8" IRON BAR.
 11/11/68 D.E.G.

NEWELL ST. 60'

REF:

Inskeep Bk. 13 Pg.124

A= 5/8" Iron Bar Set

B= Tkd. Hub Set

Dan L. Dodson

Dan L. Dodson

Registered Surveyor 4270

27.53 1P

SURVEY OF
 LOT 27-28 Pt.
 WEST LIBERTY, OHIO
 May 26, 1962
 SCALE 1"=20'
 Sec 27 T-5 R 13

INDEXED ON MAP

On plot book
 D.E.G.
 5/31/62

LOT 27 - 28 PT
WEST LIBERTY, O

LOT 27 & 28 OFF S. SIDE OF 28


- "A" = $5/8"$ Bar Set
- "B" = No pin Set - large rock pile
- "C" = Tkd Hub Set & $16'$ alley
- "D" = $3/4"$ Bar Found @ Mill St.

A-D = 349.12'

INDEXED ON MAP
2753

Dodson
Geoslin

5-26-62
Rain 70° 39'

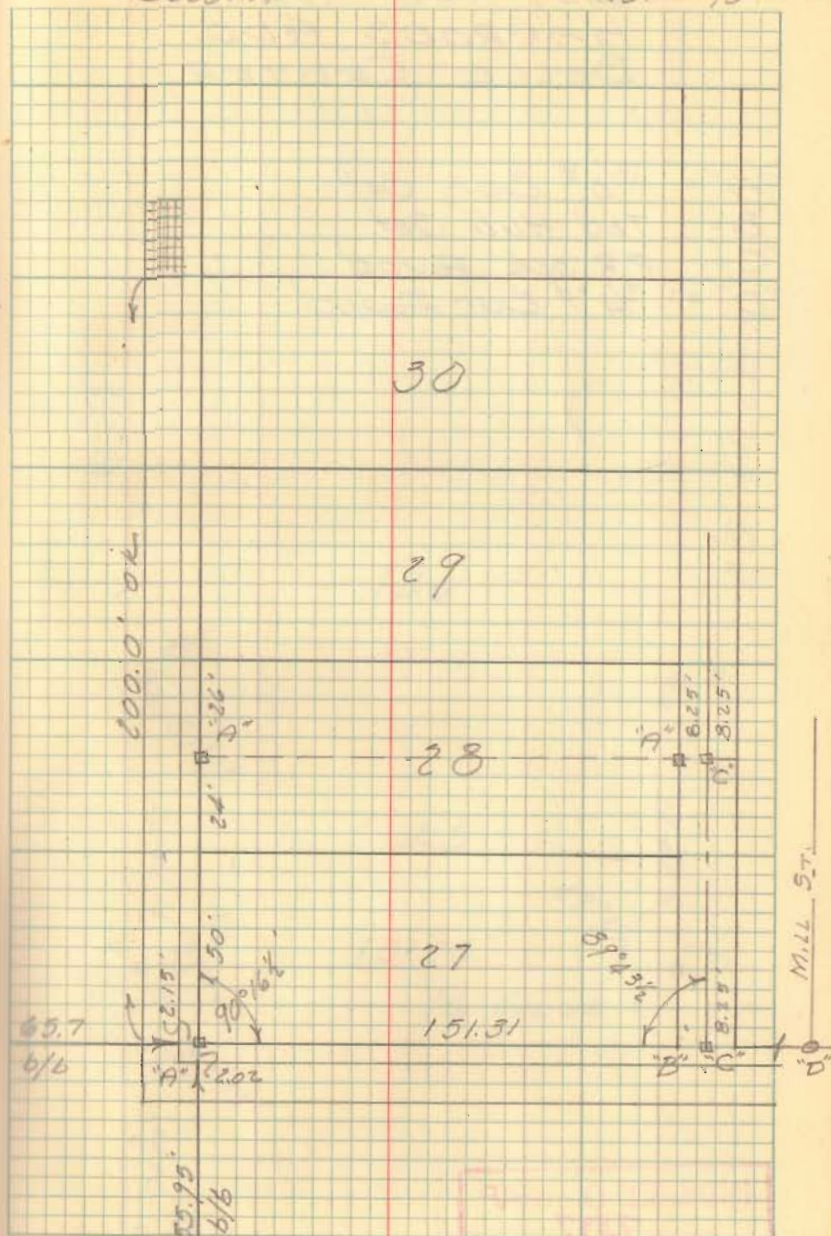

LOT 27-28

WEST LIBERTY

LOT 27 + 24' off S. side 28

$$\begin{array}{r} 300 \\ 16\frac{1}{2} \\ 30 \\ \hline 326\frac{1}{2} \end{array}$$

$$\begin{array}{r} 349.12 \\ 346.5 \\ \hline 2 \overline{) 2.62} \quad 1.31 \\ \underline{4} \\ 6 \\ \underline{6} \\ 5 \end{array}$$

$$\begin{array}{r} 151.31 \\ 8.25 \\ \hline 159.56 \end{array}$$

$$\begin{array}{r} 179.60 \\ 90 \quad 16\frac{1}{2} \\ \hline 89.43\frac{1}{2} \end{array}$$


65.76%

Bk A

Pg 39

Dutton
G. Goalin

5-26-62
Rain 32
200

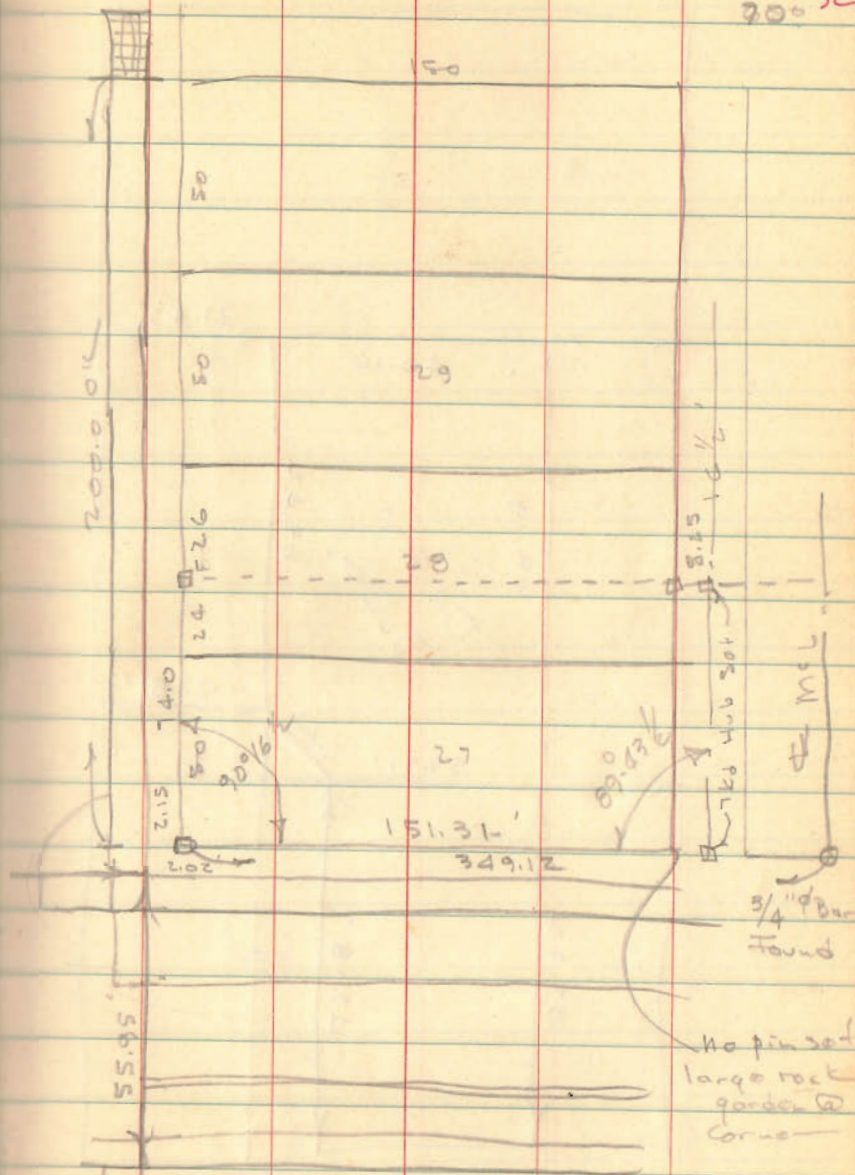

INDEXED ON MAP
2753