



SCALE
20

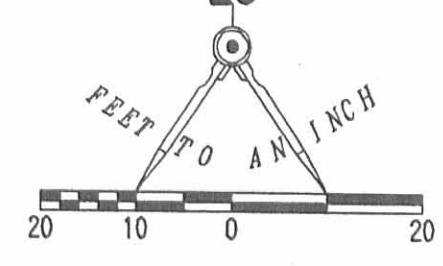

16' ALLEY

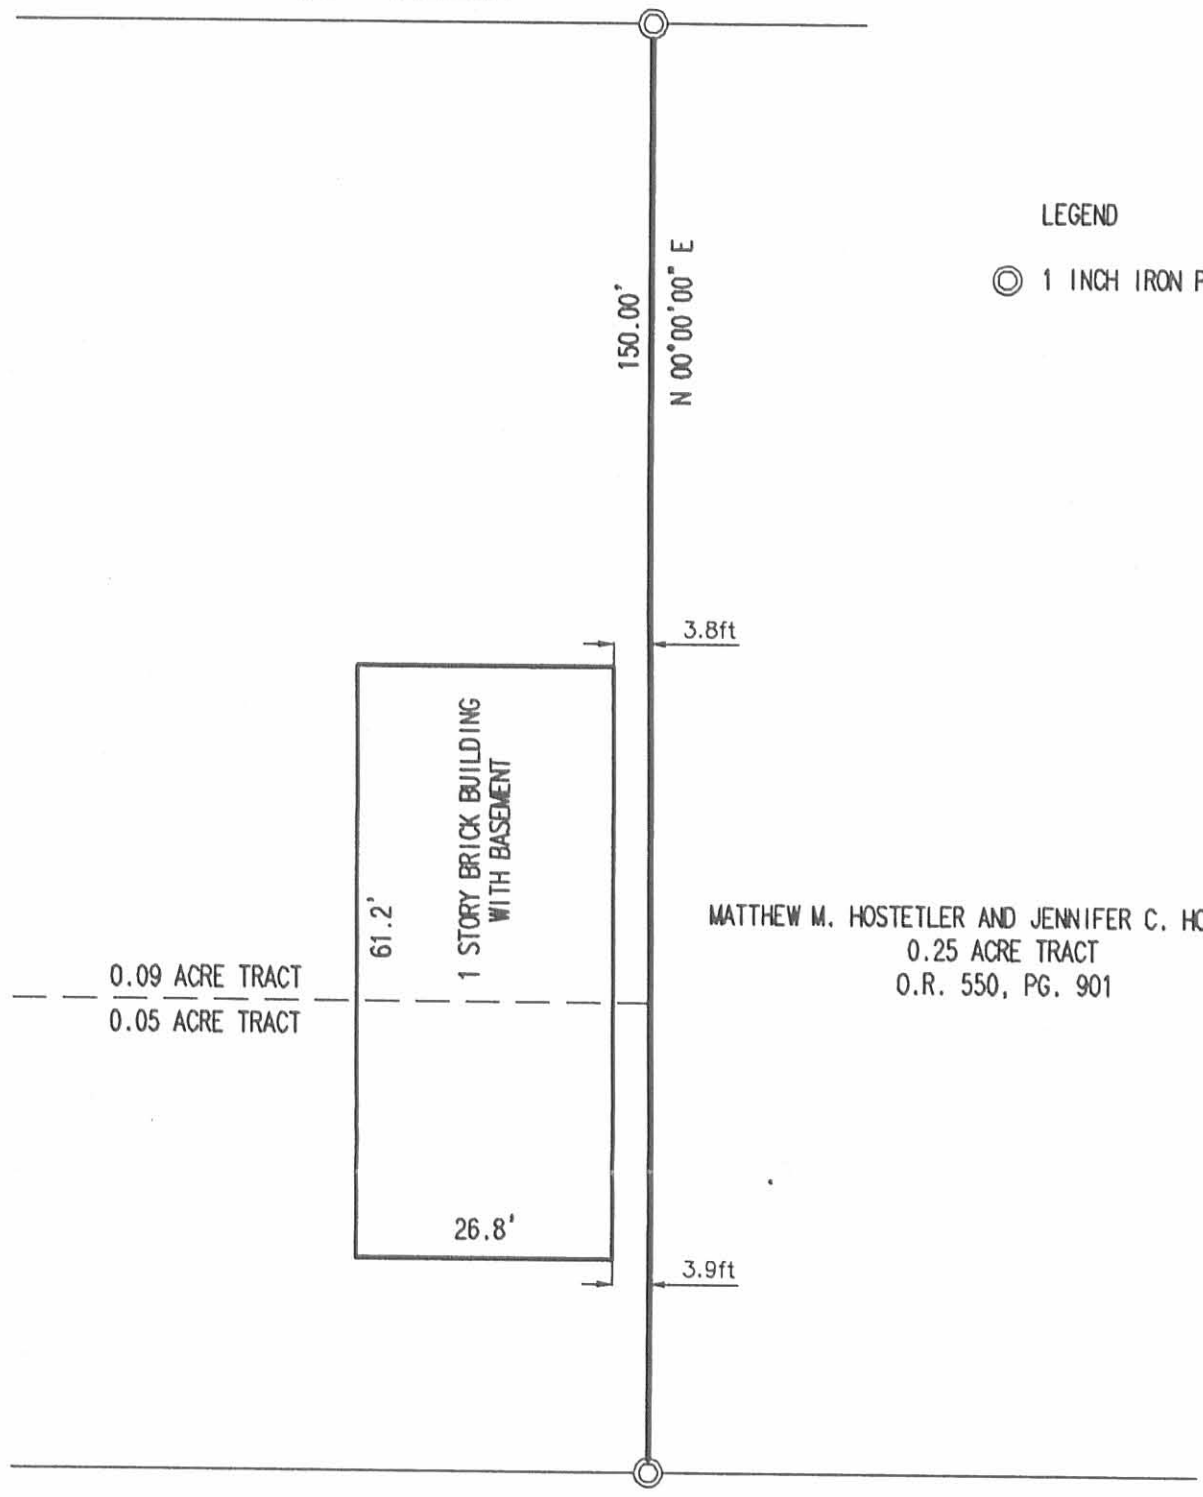

LEGEND

⊙ 1 INCH IRON PIPE FOUND

0.09 ACRE TRACT
0.05 ACRE TRACT

61.2'
1 STORY BRICK BUILDING
WITH BASEMENT
26.8'

150.00'
N 00°00'00" E

3.8ft

3.9ft

MATTHEW M. HOSTETLER AND JENNIFER C. HOSTETLER
0.25 ACRE TRACT
O.R. 550, PG. 901

EAST BAIRD STREET (60')

LOCATION OF BUILDING AND THE EAST LINE OF THE
ROBERT R. HUGHES AND SHIRLEY A. HUGHES
0.05 ACRE TRACT AND 0.09 ACRE TRACT
OFFICIAL RECORD 781, PAGE 33
TRACTS II AND III
SECTION 27, TOWN 5, RANGE 13
VILLAGE OF WEST LIBERTY
LIBERTY TOWNSHIP
LOGAN COUNTY, OHIO

THIS IS A PARTIAL BOUNDARY SURVEY
AS DEFINED IN 4733-37 OHIO
ADMINISTRATIVE CODE.

SURVEYED BY:



Jeffrey I. Lee
JEFFREY I. LEE
PROFESSIONAL SURVEYOR 6359
APRIL 3, 2006

COPYRIGHT 2006 BY:
LEE SURVEYING & MAPPING CO., INC.
117 North Madriver Street
BELLEFONTAINE, OHIO 43311
(937) 593-7335

2 WORKING DAYS
BEFORE YOU DIG
CALL TOLL FREE **800-362-2764**
OHIO UTILITIES PROTECTION SERVICE.

ORIGINAL STAMP IN GREEN

ADW D0306 1948016 L-1948016-3

INDEXED ON MAP
3704 1P

Smith Survey West Liberty E. Baird Street May 1964 Tract # 1 0.05 Acre.
Tract # 2 0.01 Acre.

The following described land in the Village of West Liberty, Liberty Township, Logan County, Ohio and being in Section 27 Town 5 Range 13.

Tract # 1

Beginning at an iron in the north side of East Baird Street and at the west side of Liberty Street and being the S.E. corner of J.E. Jones 0.25 acre tract. Thence with the north side of East Baird Street west 66.00 feet to an iron at the S.W. corner of said Jones 0.25 acre tract. Said iron being the true beginning point of this survey.

Thence with the west side of said Jones tract North 52.65 feet.

Thence west and parallel with East Baird Street 42.00 feet to an iron.

Thence south 52.65 feet to an iron at the north side of East Baird Street.

Thence with the north side of East Baird Street East 42.00 feet to the place of beginning.

The above described tract contains 0.05 of one acre and is off of the south side of a present 0.14 acre tract.

Tract # 2

Beginning at an iron in the West side of Liberty Street and at the south side of a Public Alley sixteen feet wide and being the N.E. corner of J.E. Jones 0.25 acre tract. Thence with the south side of said Public Alley west 66.00 feet to an iron at the N.W. corner of said Jones 0.25 acre tract. Thence again with the south side of said Public Alley west 27.00 feet to an iron. Said iron being the true beginning point of this survey.

Thence again with the south side of said Public alley west 15.00 feet to an iron. The last described line being 150.00 feet north of and parallel with the north side of East Baird Street.

Thence south 30.00 feet to an iron.

Thence east 15.00 feet to an iron.

Thence north 30.00 feet to the place of beginning.

The above described tract contains 0.01 of one acre and is out of the N.W. corner of the present 0.14 acre tract.

cc
Logan County Engineer.



3704

2D
INDEXED ON MAP