

KING SURVEY  
SEC. 33 T-5 R-13  
West Liberty, Ohio


May 2, 1964

The following described real estate situated in the Village of West Liberty, Liberty Township, Logan County, Ohio and being part of Section 33, Town 5, Range 13 of the Between the Miami Rivers Survey and more particularly described as follows:

Beginning at an iron bar in the east line of Wright Street at the southwest corner of Mildred M. Heller's 0.17 acre tract; thence with said Heller's south line N. 89° 00' E. 150.0 feet to an iron bar at the southeast corner of said tract; thence with said Heller's east line N. 0° 11' W. 50.0 feet to an iron bar at the northeast corner of said tract and in the south line of Archie L. King's 2.74 acre tract; thence with said King's south line N. 89° 00' E. 216.8 feet to a stake; thence S. 0° 53' W. 214.6 feet to the northeast corner of Herbert King's 0.25 acre tract; thence with the north line of said tract, N. 89° 07' W. 122.9 feet to the northwest corner of said tract; thence with the west line of said 0.25 acre tract, S. 0° 53' W. 46.4 feet to the north line of the Sidney Road; thence with said north line N. 70° 04' W. 254.7 feet to the east line of Wright Street; thence with said east line, N. 0° 11' W. 115.8 feet to the place of beginning.

Containing 1.60 acres more or less.

38021D

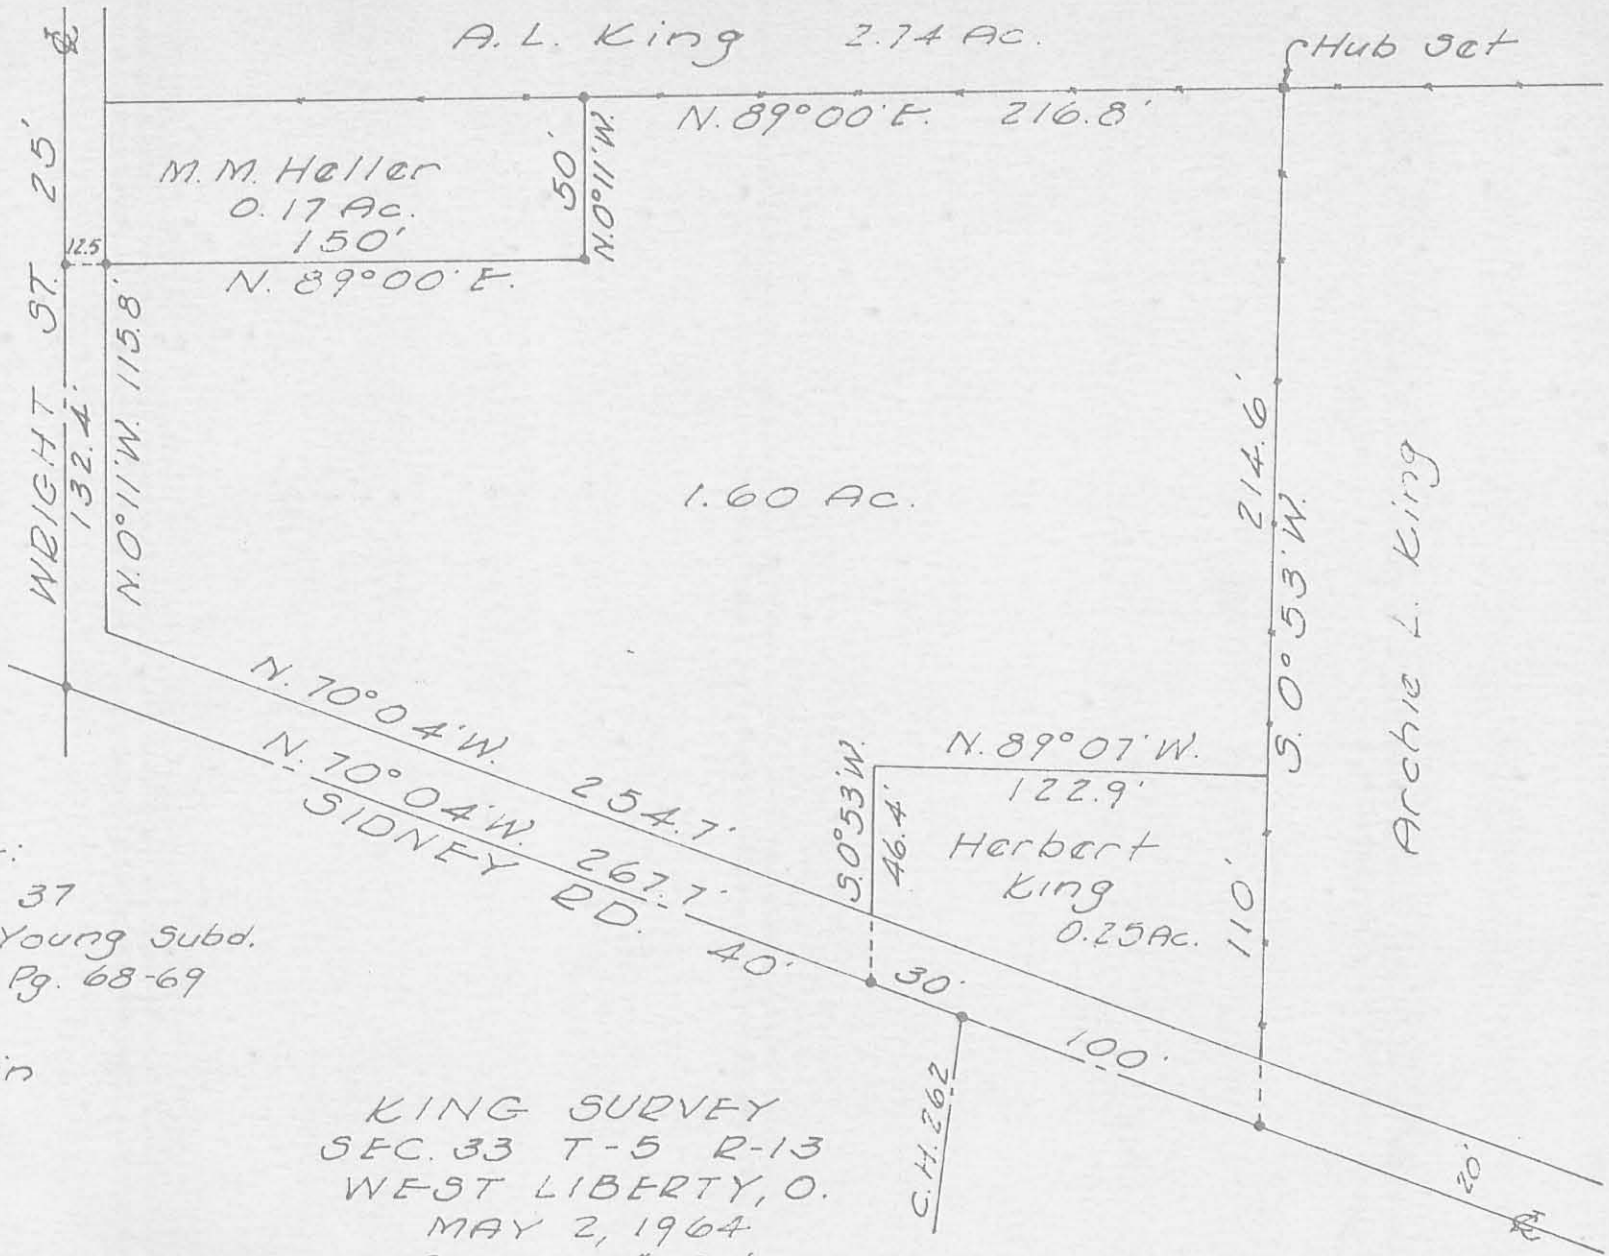

REFERENCE:

F.B. 600, Pg. 37  
 Runkle and Young Subd.  
 Deed Vol. T. Pg. 68-69

• = Iron Pin

KING SURVEY  
 SEC. 33 T-5 R-13  
 WEST LIBERTY, O.  
 MAY 2, 1964  
 SCALE 1"=60'

3802 IP

INDEXED ON MAP

*Don L. Dodson*  
 Don L. Dodson  
 Reg. Surveyor 4270  
 Bellefontaine, O

ON PLAT BOOK  
 7/9/05  
 D.E.G.

# KING SURVEY

WEST LIBERTY

See Lolo. Eng F.B 600 pg 37

For Survey of 0.25 Ac.

$$\begin{array}{r} 89.11\% \\ 60 \\ \hline 29.11\% \end{array}$$

$$\begin{array}{r} 160.0 \\ 71.78 \\ \hline 231.78 \end{array}$$

CONC.  
P Marker


INDEXED ON MAP.  
3802

Dodson  
Goodlin

May 2, 1964

80°

7

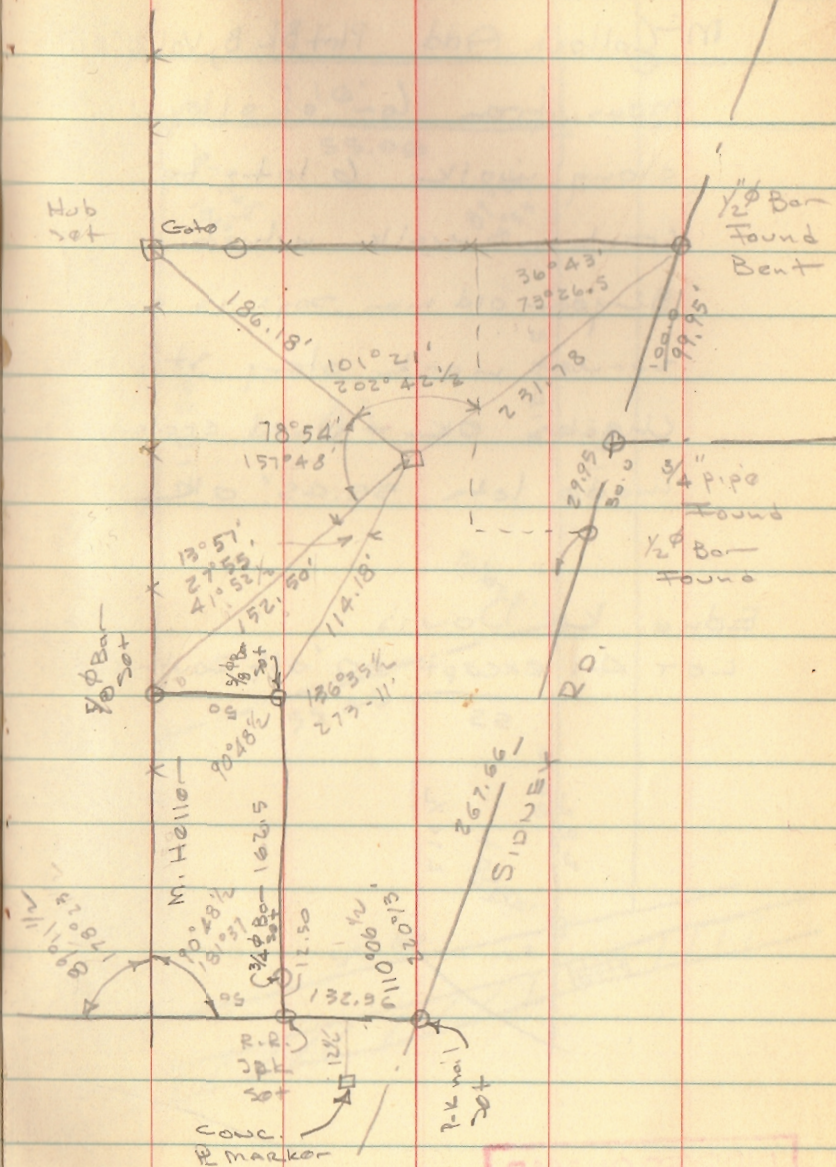

7  
SP 18