

Newton S. Weber Survey  
Part of Lots 24 & 25  
West Liberty, Ohio

November 11, 1968

The following described real estate situated in the Village of West Liberty, Township of Liberty, County of Logan, State of Ohio and being a part of Section 27 Town 5 Range 13, Between the Miami Rivers Survey and a part of Lots 24 and 25 of the Village of West Liberty;

Part A: Beginning at an iron bar, Southwest corner of Lot No. 25 in the north line of Newell St.;

Thence with the west line of Lot No. 25, N.  $1^{\circ} 15'$  E. 80.00 feet to an iron bar;

Thence S.  $88^{\circ} 39'$  E. 77.75 feet to a point in Lot No. 24, passing the line between Lot No. 25 and 24 at 50.48 feet;

Thence S.  $1^{\circ} 15'$  W. 80.00 feet to a point in the north line of Newell Street;

Thence with the north line of Newell Street, N.  $88^{\circ} 39'$  W. 77.75 feet to the place of beginning, passing the line between Lot No. 24 and 25 at 27.27 feet.

I hereby certify that this is a true and accurate description of a survey made by me on November 11, 1968.

*Daniel E. Gilbert*  
Daniel E. Gilbert, P.S.  
Reg. Sur. No. 5402  
428 N. Madriver St.  
Bellefontaine, Ohio 43311



10-1

4463

INDEXED ON MAP

Newton S. Weber Survey  
Part of Lots 24 & 25  
West Liberty, Ohio

November 11, 1968

The following described real estate situated in the Village of West Liberty, Township of Liberty, County of Logan, State of Ohio and being a part of Section 27 Town 5 Range 13, Between the Miami Rivers Survey and a part of Lots 24 and 25 of the Village of West Liberty;

Part B: Beginning at an iron bar, Southwest corner of Lot No. 25 in the north line of Newell Street;

Thence with the west line of Lot No. 25, N.  $1^{\circ} 15'$  E. 80.00 feet to an iron bar for the true place of beginning;

Thence continuing with said west line of Lot No. 25, N.  $1^{\circ} 15'$  E. 70.00 feet to an iron bar in the south line of a 16.5 foot Alley, also being the Northwest corner of Lot No. 25;

Thence with the south line of said Alley, S.  $88^{\circ} 39'$  E. 77.75 feet to a point in Lot No. 24, passing the Northeast corner to Lot No. 25 at 50.48 feet;

Thence S.  $1^{\circ} 15'$  W. 70.00 feet to a point;

Thence N.  $88^{\circ} 39'$  W. 77.75 feet to the place of beginning, passing the line between Lot No. 24 and 25 at 27.27 feet.

I hereby certify that this is a true and accurate description of a survey made by me on November 11, 1968.

*Daniel E. Gilbert*  
Daniel E. Gilbert, P.S.  
Reg. Sur. No. 5402  
428 N. Madriver St.  
Bellefontaine, Ohio 43311



ID-2

4463

INDEXED ON MAP

Newton S. Weber Survey  
Part of Lot 24  
West Liberty, Ohio

November 11, 1968

The following described real estate situated in the Village of West Liberty, Township of Liberty, County of Logan, State of Ohio and being a part of Section 27 Town 5 Range 13, Between the Miami Rivers Survey and a part of Lot 24, of the Village of West Liberty;

Part 0: Beginning at iron bar in the North line of Newell Street and the South line of Lot No. 24 that is N.  $88^{\circ} 39'$  W. 21.20 feet from the Southeast corner of Lot No. 24 and the West Line of McClellan Street;

Thence with the north line of Newell Street, N.  $88^{\circ} 39'$  W. 2.0 feet to a point;

Thence N.  $1^{\circ} 15'$  E. 150.00 feet to a point in the north line of Lot No. 24 and the south line of a 16.5 foot Alley;

Thence with the south line of said Alley, S.  $88^{\circ} 39'$  E. 2.0 feet to an iron bar;

Thence S.  $1^{\circ} 15'$  W. 150.0 feet to the place of beginning, passing through an iron bar at 70.0 feet.

I hereby certify that this is a true and accurate description of a survey made by me on November 11, 1968.


Daniel E. Gilbert, P.S.  
Reg. Sur. No. 5402  
428 N. Madriver St.  
Bellefontaine, Ohio 43311



1D-3

4463

INDEXED ON MAP

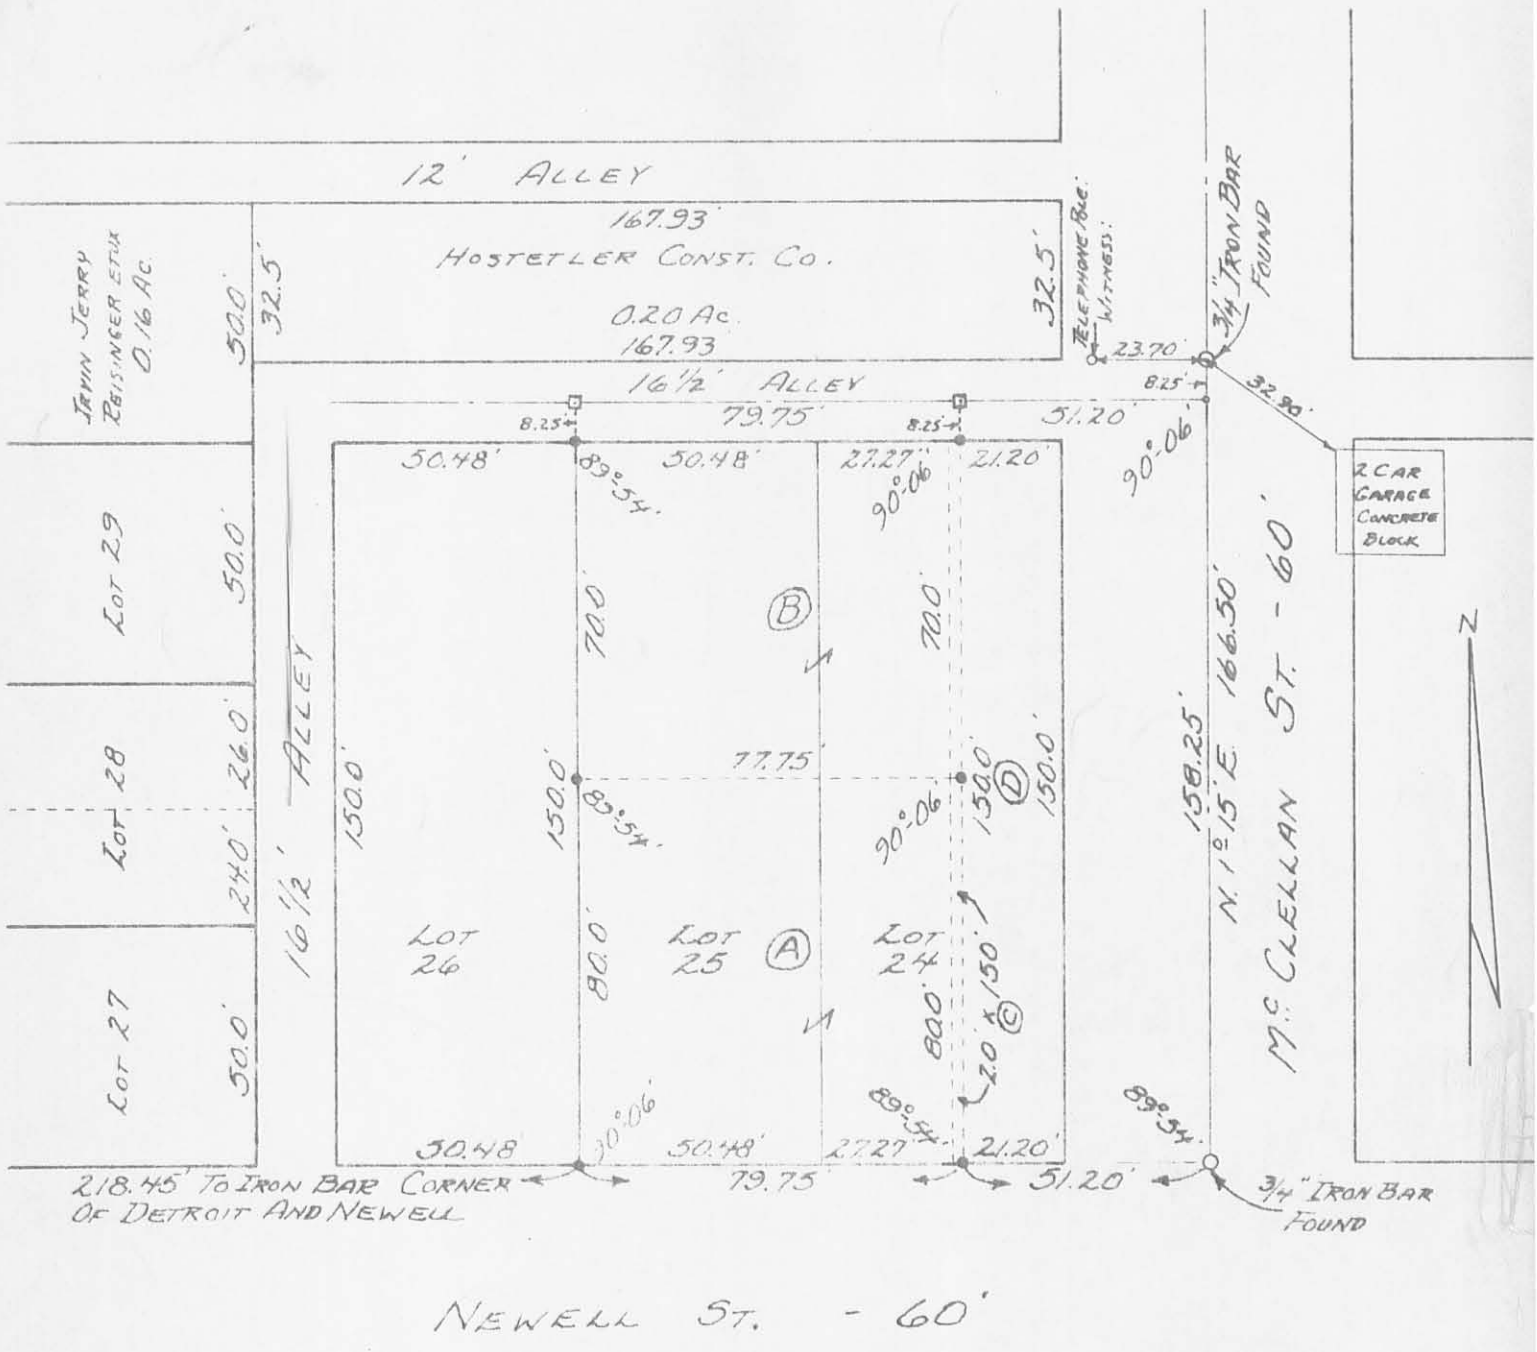

- ☐ - TACKED HUBS SET.
- - P. K. NAIL SET.
- - 3/8" φ IRON BARS SET.

SURVEYED AND PLATTED BY:  
 DANIEL E. GILBERT, P.S.  
 REG. SUR. NO. 5402  
 428 N. MADRIVER ST.  
 BELLEFONTAINE, OHIO 43311



NEWTON S. WEBER SURVEY  
 LOTS 24 PT. & 25 PT.  
 VILLAGE OF WEST LIBERTY  
 SECTION 27 T. 5 R. 13  
 LIBERTY TOWNSHIP  
 LOGAN COUNTY, OHIO  
 NOVEMBER 11, 1968

SCALE: 1" = 40' (4463)  
 INDEXED ON MAP