

Received 12-30-93
or 1-5-94

LESLIE H. GEESLIN
REGISTERED SURVEYOR NO. 5248
P.O. BOX 274
RUSHSVLVANIA, OHIO 43347
TELEPHONE: (513) 468-2793
ROSENGARTEN SURVEY

November 12, 1993

The following described real estate situated in the State of Ohio, County of Logan, Township of Liberty, being the south 42 feet of Lots 145 and 146 in the Village of West Liberty and more particularly described as follows:

Beginning at a 5/8 inch iron bar set in the west line of White Street that is SOUTH 108.00 feet from the northeast corner of Lot 145.

Thence with said White Street SOUTH 42.00 feet to a point.

Thence with the north side of a 16.5 foot alley WEST 100.00 feet to a 5/8 inch iron bar set at the southwest corner of Lot 146.

Thence with the west line of Lot 146 NORTH 42.00 feet to a 5/8 inch iron bar set.

Thence EAST 100.00 feet to the place of beginning.

Containing 0.096 acre more or less.

The above described 0.096 acre tract being a new survey of the tract described in O. R. Vol. 97 Page 734 By Leslie H. Geeslin.

Bearings are based on an assumed bearing (SOUTH) for the west line of White Street.




Leslie H. Geeslin

INDEXED ON MAP
8867 1D

EST. BY SIDEWALK SPLIT

BAIRD ST. (60')

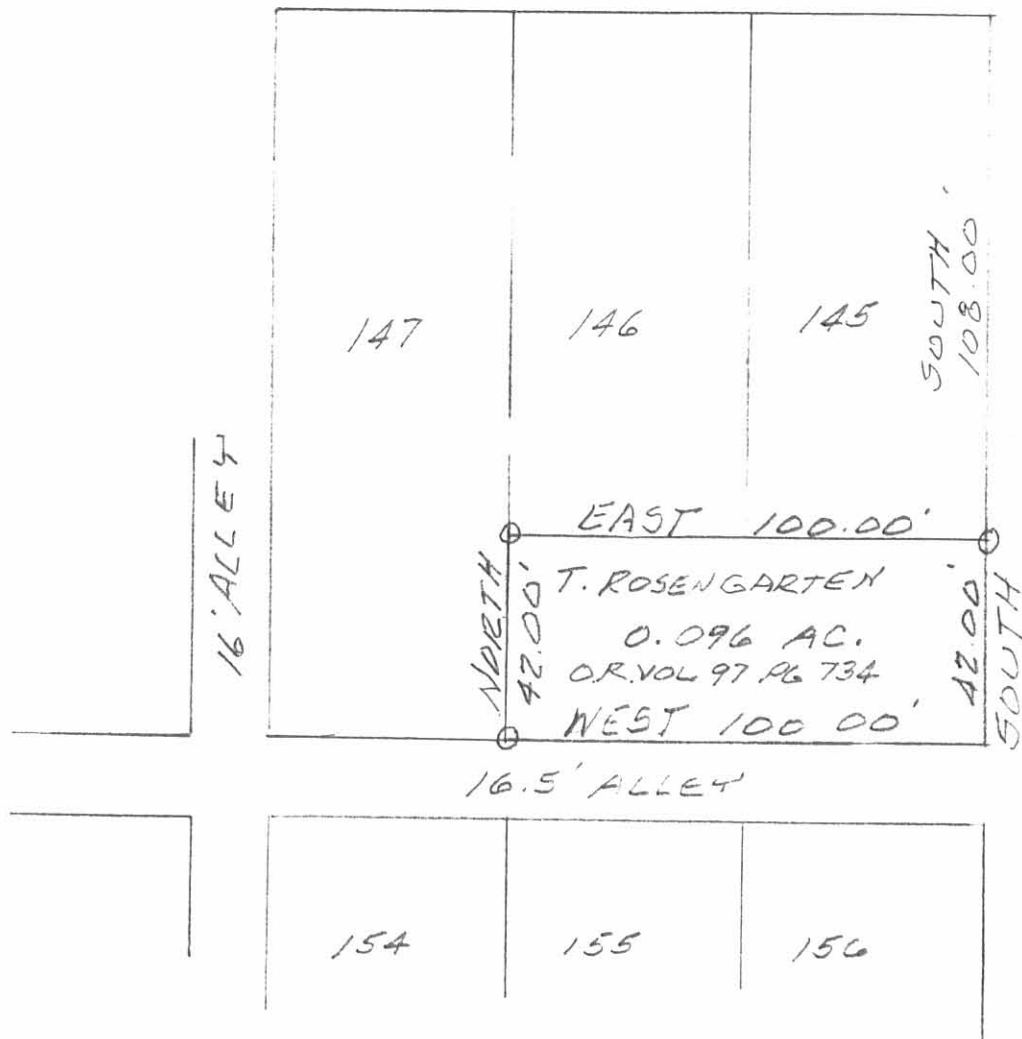

SURVEY OF 0.096 AC. TRACT (SOUTH 42')
 ON S. SIDE OF LOTS 145 & 146 IN THE
 VILLAGE OF WEST LIBERTY, OHIO FOR
 TIMOTHY ROSENGARTEN.
 NOVEMBER 12, 1993
 SCALE: 1" = 40'



LEGEND:
 O = 5/8" IRON BAR SET



INDEXED ON MAP
 8867 IP

Leslie H. Geeslin
 LESLIE H. GEESLIN
 RUSHSVLVANIA, OHIO
 PH 513-468-2793