

SHROYER SURVEY
V. M. S. 755-6155
WEST MANSFIELD, OHIO

May 16, 1959

The following described real estate situated in the Village of West Mansfield, Bokescreek Township, Logan County, Ohio and being part of Virginia Military Survey 755-6155 and more particularly described as follows:

Beginning at a spike in the center of State Route No. 47 at the southwest corner of an 0.88 acre tract presently belonging to the Board of Education; thence with the center line of said State Route No. 47 North 83°-18' West 300.0 feet to a spike; thence North 5°-35' East 353.1 feet to an iron pin in the south line of Cuba Bushong's 4.33 acre tract; thence with said Bushong's south line South 83°-20' East 300.3 feet to a post, being a corner of said Bushong tract and also being the northwest corner of said 0.88 acre tract; thence with the west line of said 0.88 acre tract South 5°-35' West 353.3 feet to the place of beginning, passing an iron pipe at 328.3 feet.

Containing 2.43 acres more or less.

The above described tract being part of Robert W. Shroyer's 4.00 acre tract.

INDEXED ON MAP

2788 1D


Shoyer Survey
 U.M.S 755-6155
 West Mansfield

Dodson
 Coeslin

May 16, 1959

56

School lot

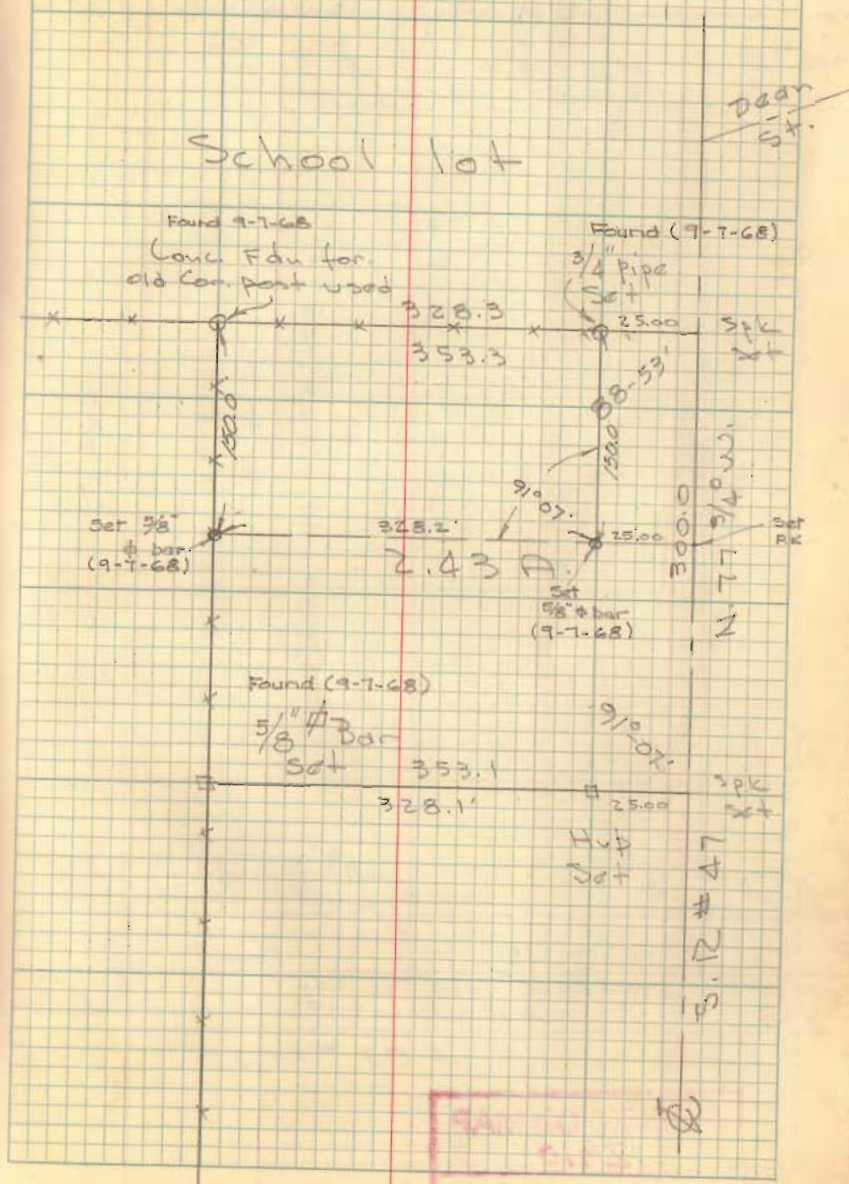

INDEXED ON MAP
 2788


INDEXED ON MAP
 2788

Bk 3 pg 56

328.3
25.0
353.3

May 16, 1959

7

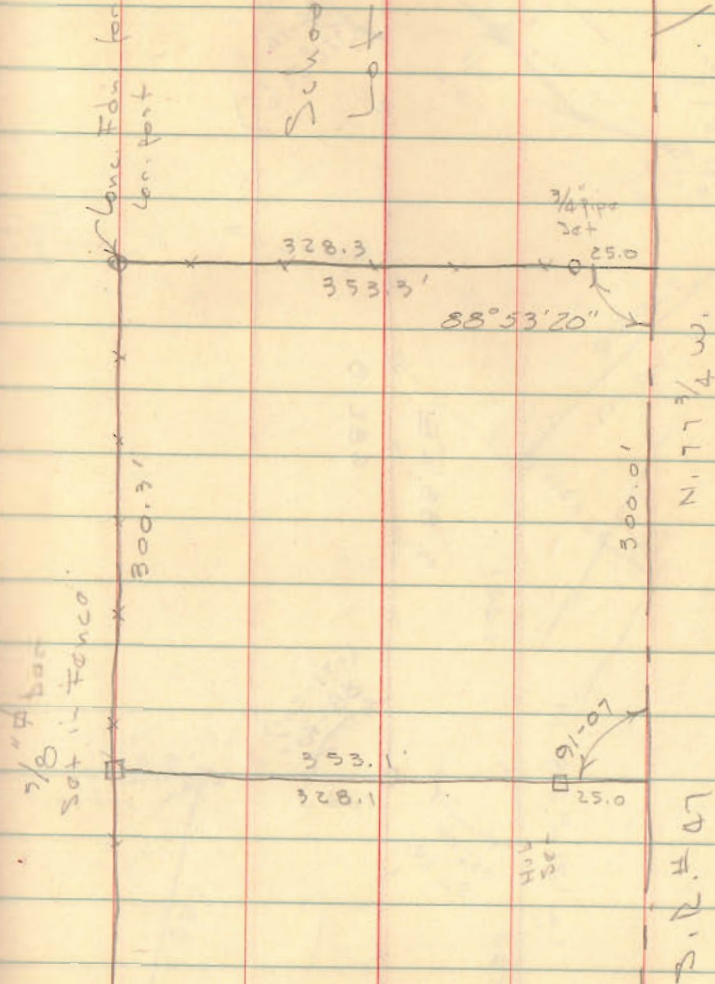

Dean St.

N. 77° 4 W.

D.R.# 07

INDEXED ON MAP
2788

R/W
10.00
50.91
50.91
R/W
10.00
50.91