
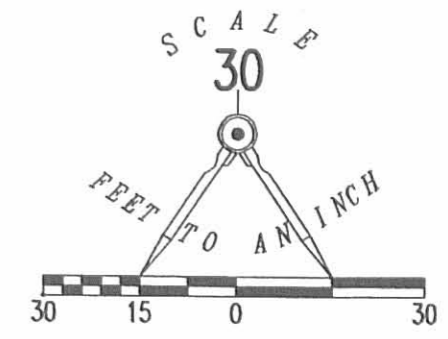


REC'D 7-6-05 SMJ RL

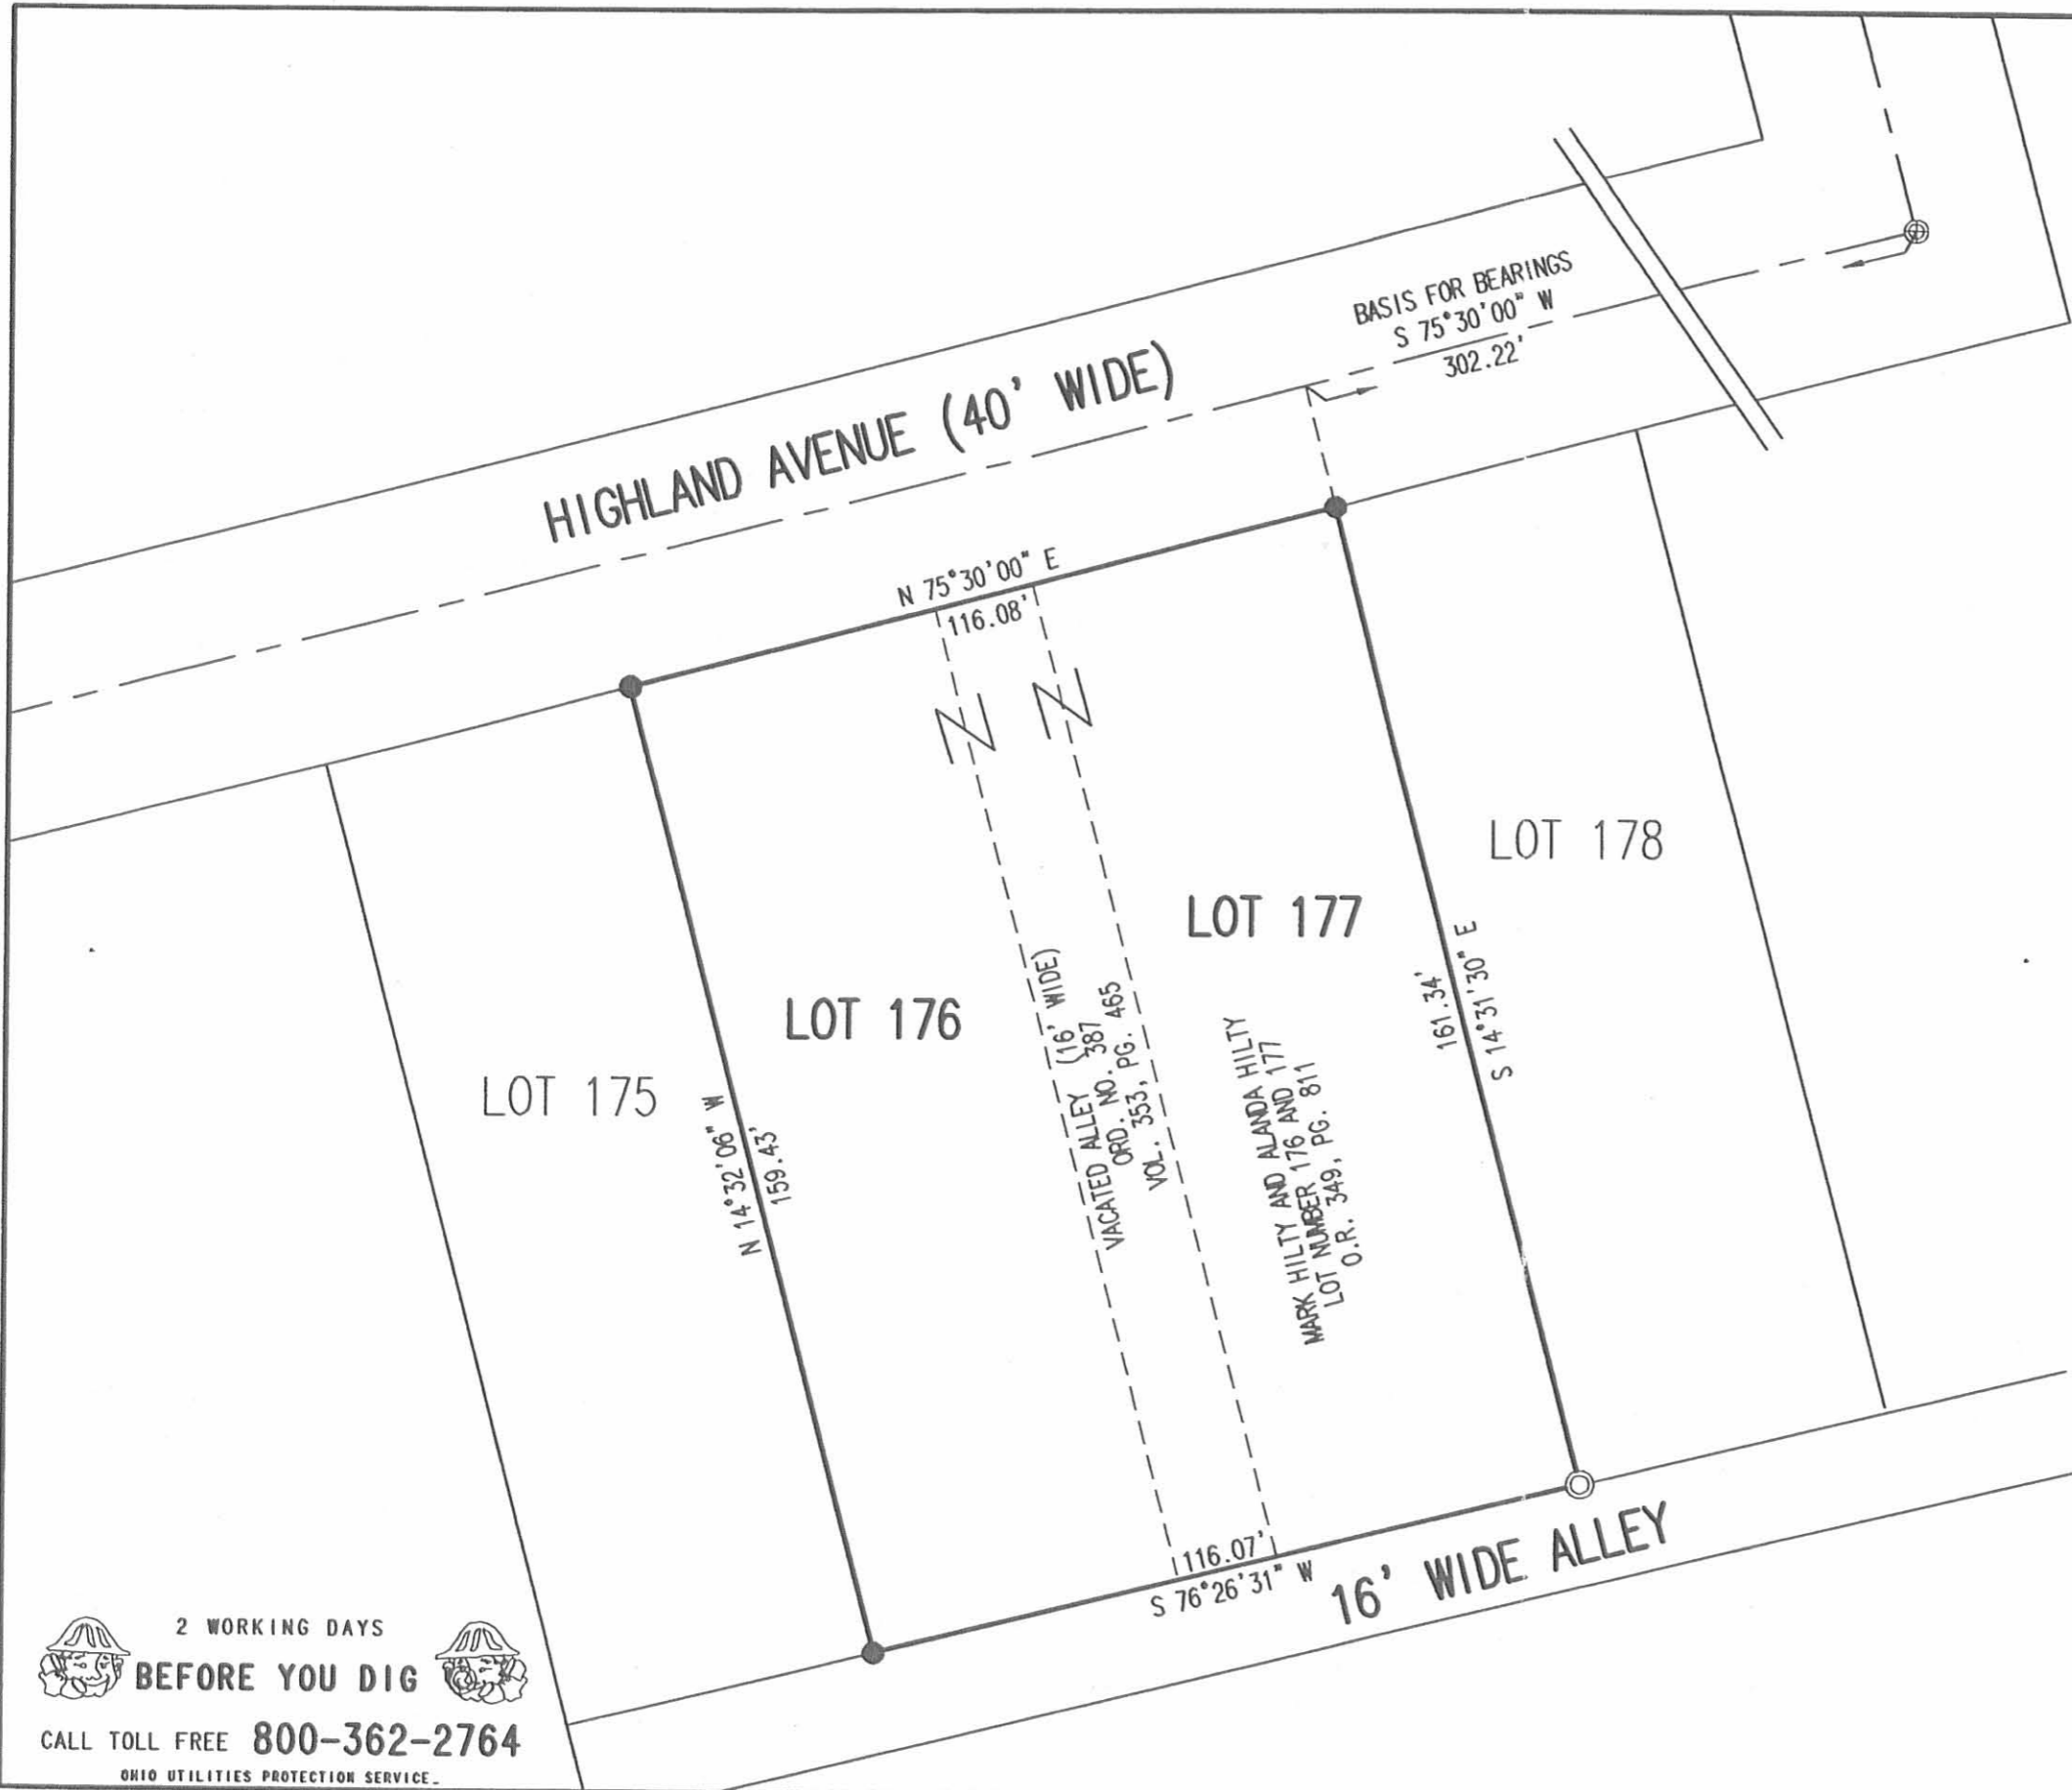


LEGEND

- 5/8 INCH IRON ROD FOUND
- ⊙ 3/4 INCH IRON PIPE FOUND
- ⊕ 3/4 INCH IRON ROD FOUND

A RETRACEMENT SURVEY OF THE
 MARK HILTY AND ALANDA HILTY
 LOT NUMBER 176 AND 177
 OFFICIAL RECORD 349, PAGE 811
 WILLIAM R. GILBERT ADDITION
 PLAT CABINET A, SLIDE 130
 VILLAGE OF WEST MANSFIELD
 BOKESCREEK TOWNSHIP
 LOGAN COUNTY, OHIO

SURVEYED BY:

[Signature]
 JEFFREY I. LEE
 PROFESSIONAL SURVEYOR 6359
 JULY 1, 2005

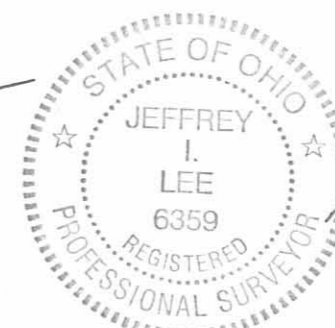

ORIGINAL STAMP IN GREEN

COPYRIGHT 2005 BY:
 LEE SURVEYING & MAPPING CO., INC.
 117 North Madriver Street
 BELLEFONTAINE, OHIO 43311
 (937) 593-7335

ADW D0705 40450605 L-4045065-3

2 WORKING DAYS
BEFORE YOU DIG
 CALL TOLL FREE **800-362-2764**
 OHIO UTILITIES PROTECTION SERVICE

INDEXED ON MAP
 5551 IP