

Road 153


60' Commissioners Journal 3 Page 138

June - 1833

Old Notes Book 373 p. 372

Jan. 19-1934
Jear
Wright
Stone
Mills
Rothfelder

39

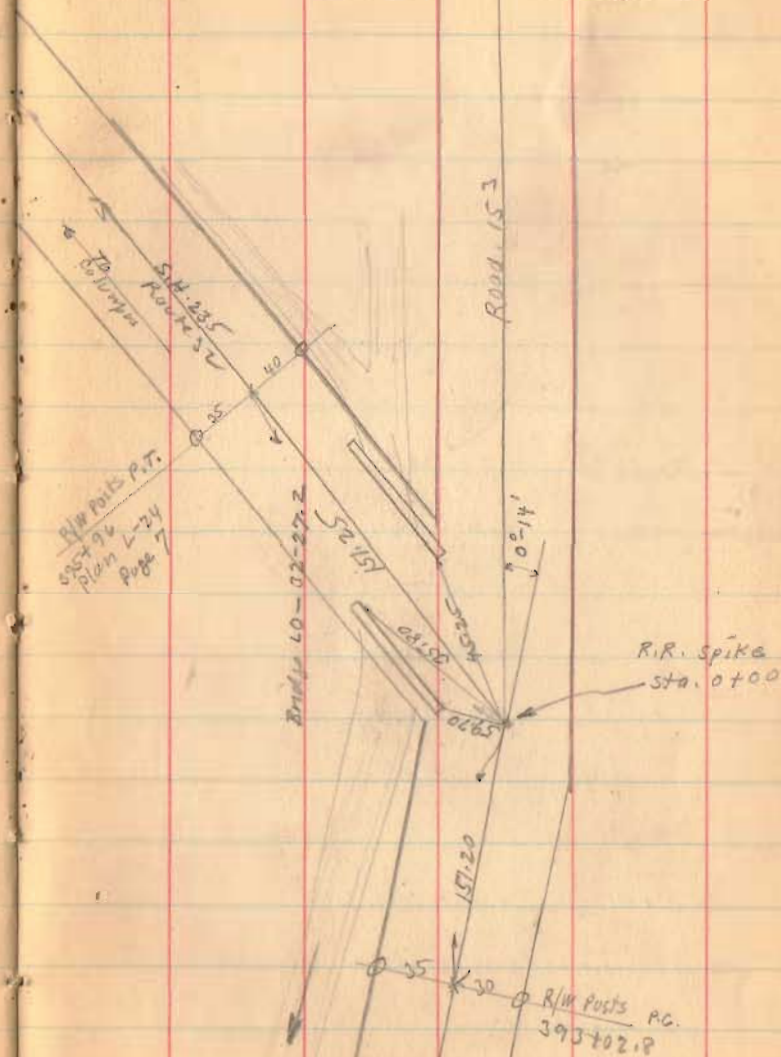

1536
INDEXED ON MAP

Road 15

14+00

Right Only

8+00

Right Only

2+00

Right Only

Monuments 30' from $\frac{1}{4}$
for 60' road.

1536
INDEXED ON MAP

G.E. DUNAWAY

14+93

1-19-54

14+93
R.K. Smith
NO. 147



30

14+93 (Road 147)

See B-144
375
Page 28

See F.B. 451 P. 38

Open ditch

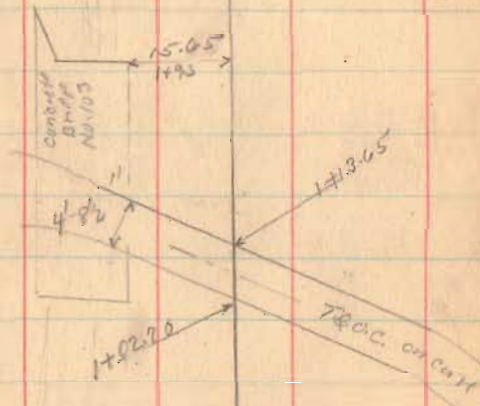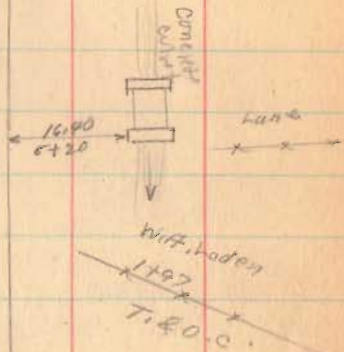

Sig. E.
Noodle

Road 153

lane

45+00

Right Only

39+50

Right Only

33+00

Right Only

27+00

Right Only

20+00

Right Only

1536
INDEXED ON MAP

1-19-54

I.R. & M. Huesey

48+23

B. Taylor

Iron set

Mar 11, 1952 C.E. Keyser

Sta 48+21.7

lane



Bridge 153-0.80



Cross on wall

Open Ditch

B. Taylor

28+17

GE Overway

39+92

39.15

30°

R.R. Spiky

39+50

0°-05' Right

I.R. & M. Huesey

28+19

W.A. Loder

Iron set


Mar 11, 1952 C.E. Keyser

Sta 28+16.6

33

bridge
wood
floor

lane

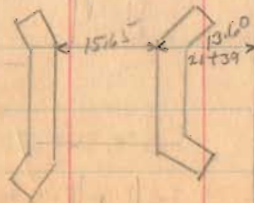

Road 153

58+50

56+00

52+00

Right Only

1536
INDEXED ON MAP

1-19-34

28

Samuel Banta

Nelson Johnson

Bridge
145-0.05

Road 145

106.25

107.10

H.R. & M.L. Hussey

Marrow Valley
School
Dist. road

18.95

31.90

56+6.9

Brick
lot

107.05

X X X X X
57+00

H.R. & M.L. Hussey

R.R. Spine

57+97

1247 Right

52+50

52+50

SIDE
ROAD

R.R. Spine

58+00

0°54' left

70

42" CL. PIPE

FALL 10


LONG

51+00

Road 153

63+00

1536
INDEXED ON MAP

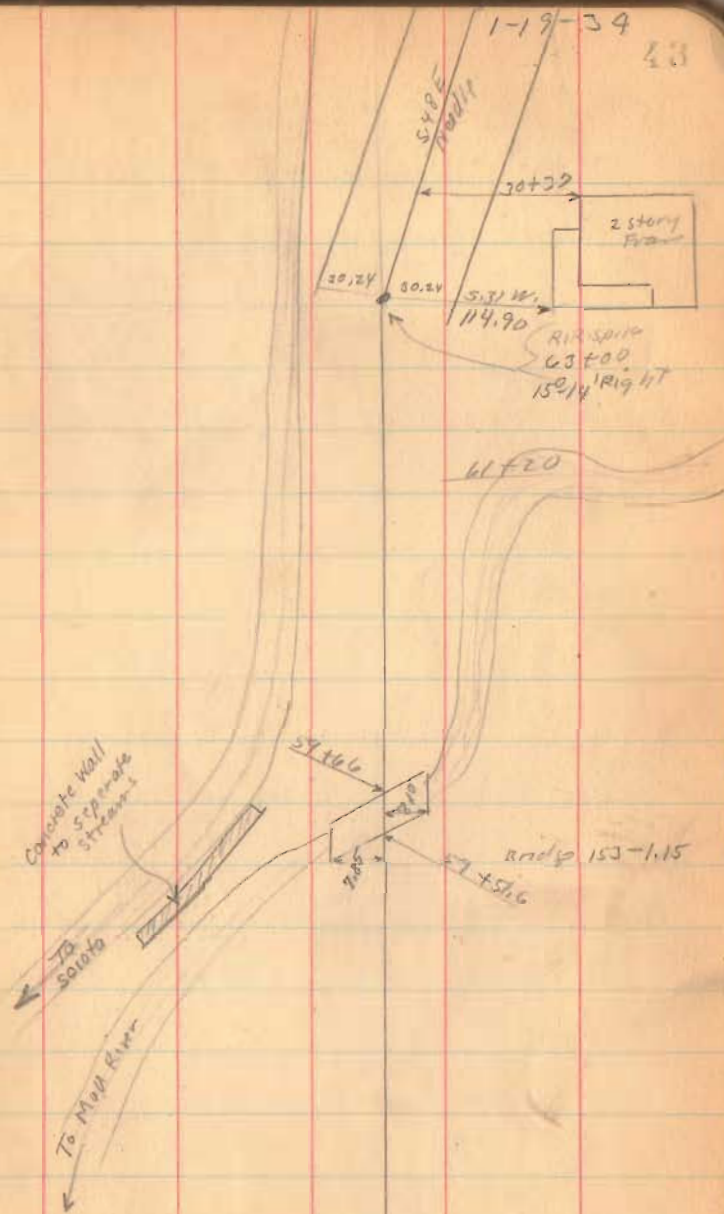

Flood. 153


69700

65700

1536
INDEXED ON MAP

1-19-34

24

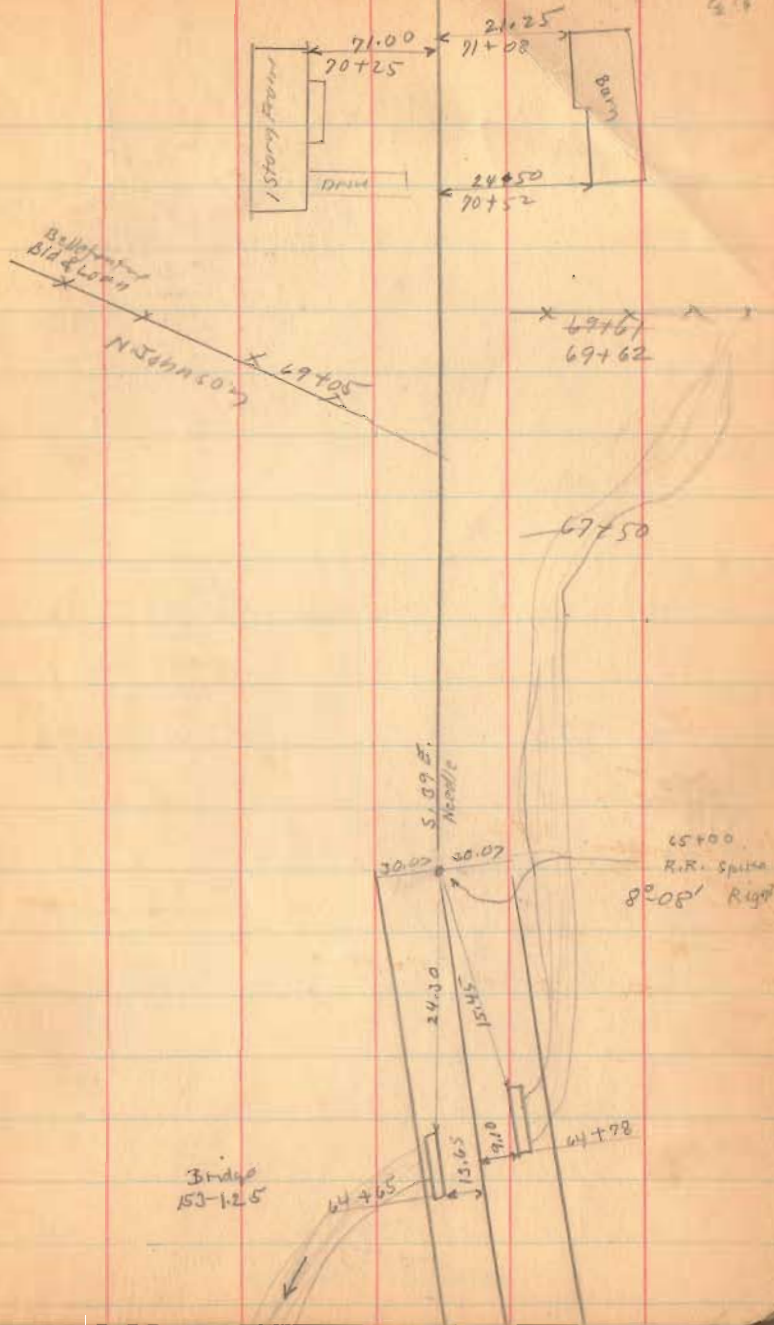

Road 153

80+00


75+75

71+60

1536

INDEXED ON MAP

43

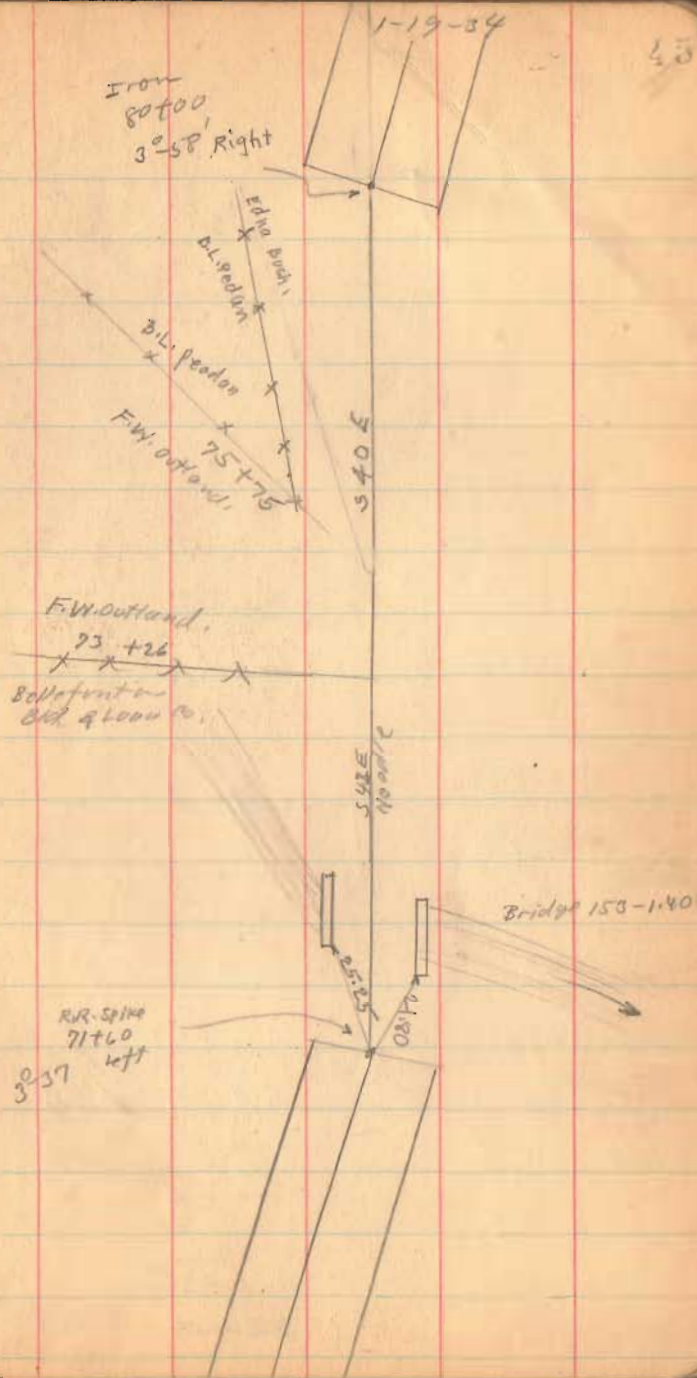

97+35
2113
7497

Road 153

100+20

96+00

92+00

87+38

83+00

1536
INDEXED ON MAP

109286.4
75 33
7574

100136
975 33
219

Jan 24, 1939
Clear - SHH 6
Wright
Crane
Mills
Dugan
Ramsider



Edna Bess
W.H. +
Bldg & Loan Co.

SURE
NAD

Ed. 5/8" iron
3 June 1971
C.N.

38.5Y
20.37

Don
87+38
21°-47' Left

SURE
NAD

$$\begin{array}{r} 113.75 \\ 106 \\ \hline 7135 \end{array}$$

$$\begin{array}{r} 104+86.4 \\ 100+24 \\ \hline 4140.4 \end{array}$$

Road: 153


112+00

106+00

104+00

1536

INDEXED ON MAP

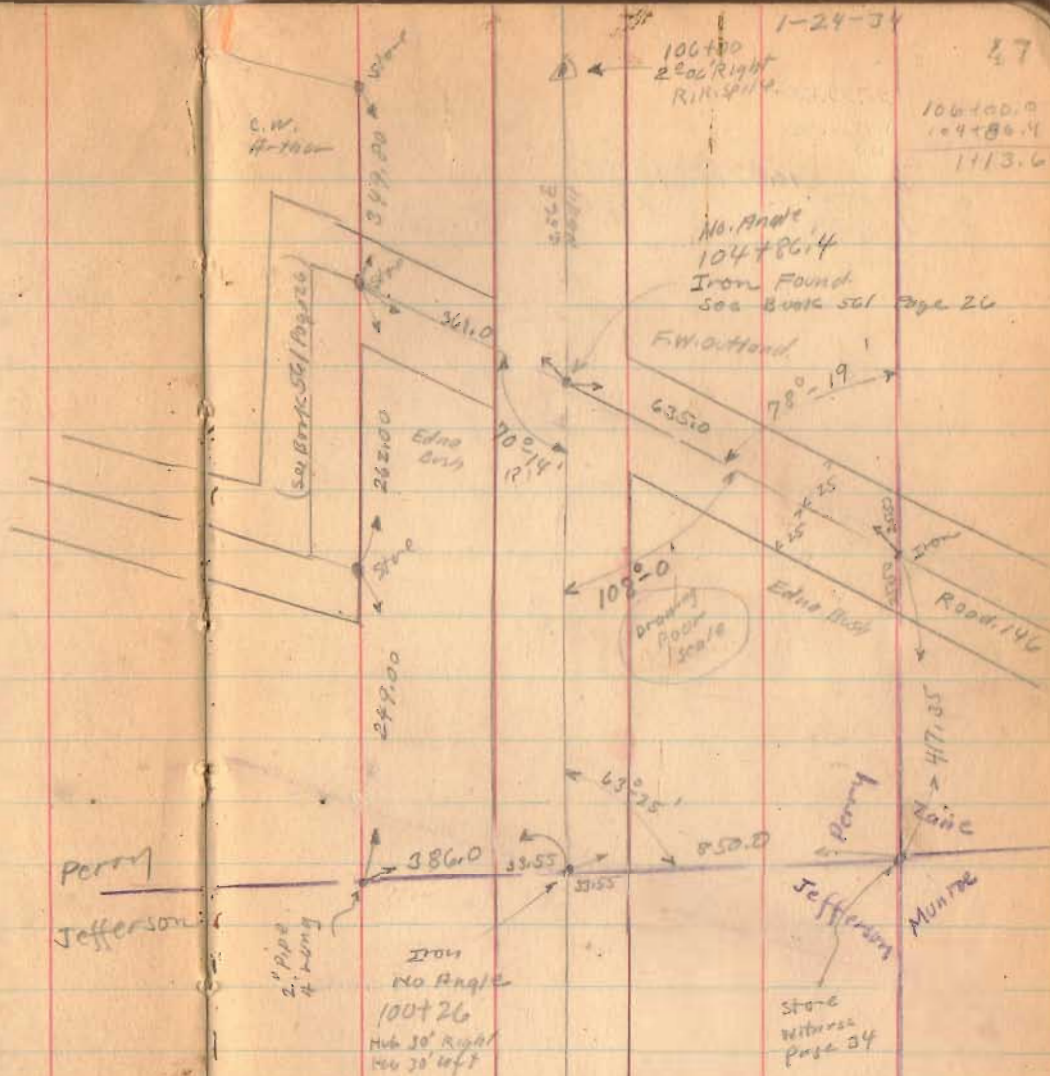

Road. 153

114+00

Road. 144
East Liberty Pk
(See Book 561 Page 24)

C. Hatcher

C. W. ...

1 story frame

1-24-34

48

114+00
R.R. Spike
4' 2 1/2' Right

Ed. R. Espino
3 June 1971
C. N.

30.02 30.02

R.R. Spike
113+13.8
No. Right

7.30
90°

44.25
N. 55° W
10'
10' 59" W

110+87

1 1/2 story frame

lane
111+00


1536

INDEXED ON MAP

Road 153

121+00

116+43.38 Top line (on skew)

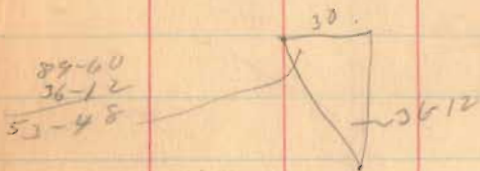

Sec. 53-48 116+43.38

SW $\frac{11693.30}{50,286.0}$

TO $\frac{13663.0}{40,589.0}$

1536

INDEXED ON MAP

1-24-34

49

1/2 story
Frame

123+01

S 51-21 E

119+27

Bridge 53-230

112+55

ZEINE
PERRY

36.12'

30.00
20.50
30
30
30
30.00
30.00

R.R. spike
116+43
Top line
No Angle

FS 1/2 dip
3 June 1971
C.N.

J.W. Patrick
115+92
E. Outland

Road. 153

138+28


132+00

127+00

125+00

1536

INDEXED ON MAP

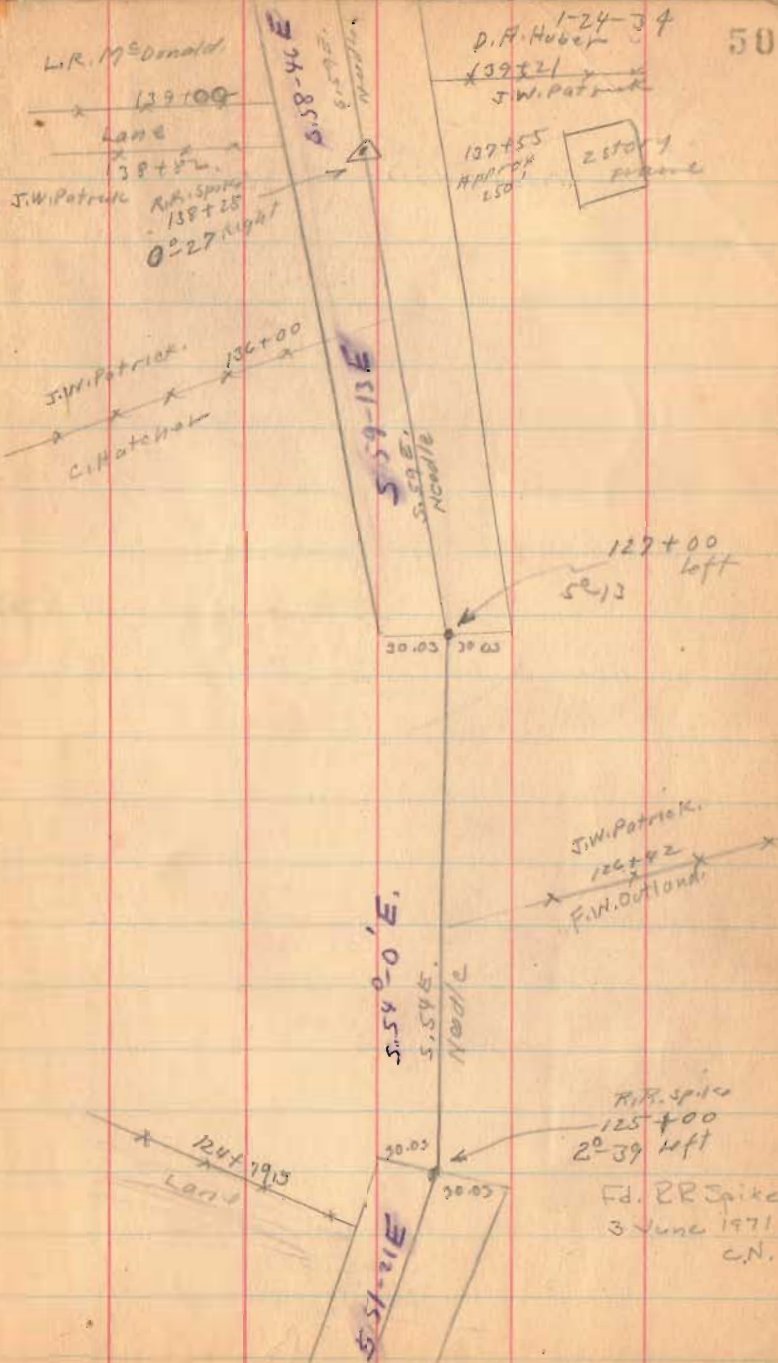

Road 153

156+00

157+00

145+00

1526

INDEXED ON MAP


1-24-34

51



R.R. Spiker
Set 11/2/12
Sta. 158+46.93
P.R.C.


J. Hardman
L.R. & E. Arnold
158+44
D.F.H. 602

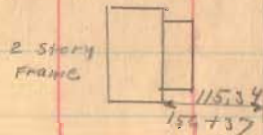

S-58-46E

152+61

149+58
L.W.C.
00 000 000

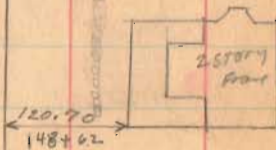

Road 153

173+00

162+00

162+00

INDEXED ON MAP

153C

1-24-34

53

R.R. Spike Set
9/29/72
P.C.
Sta. 172+92.59

O.D. Lane
172+94
L.R. McDonald



R.R. Spike Set
9/29/72
Sta. 168+04.89

O.D. Lane
168+59
L.R. McDonald

S. 59-50 E.

S. 00 E.
needle

R.R. Spike
162+00
P-04 left
Found 9/27/72
P.R.C.

358

Road 153

182+25

179+00

1536

INDEXED ON MAP


129-34

53



R.R. spike
182+25
4°-47 left

182+25
177.72
4+53

453

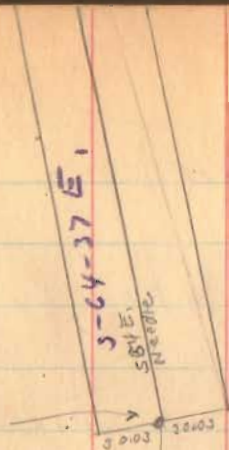

Could not
find 9/29/72
P.R.C.

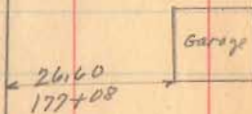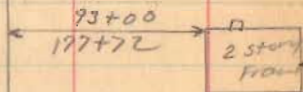

Road 153

189+00

Right Only

188+32.3

Left Only

187+75

Right Only

Jan. 25, 1934
cloudy - Windy 5/1
Wright
Craw
Mills
Dugan
Rothslder

Iron
2° 22' Right
188+32.3

S 62 E
N 41 W 1/2

E. L. Richards

Road 243
S 53 W
Needle

O. D. Lane

J. A. Reams

L. R. McDonald

187+88

1536

INDEXED ON MAP

Flood 153

214+43.3

90° Backside

207+00

199+88

194+00

90° from Backside

1536

INDEXED ON MAP

Jan-26-1934

Clear

Wright


Crain

Duggan

Mills

Rothfield

55

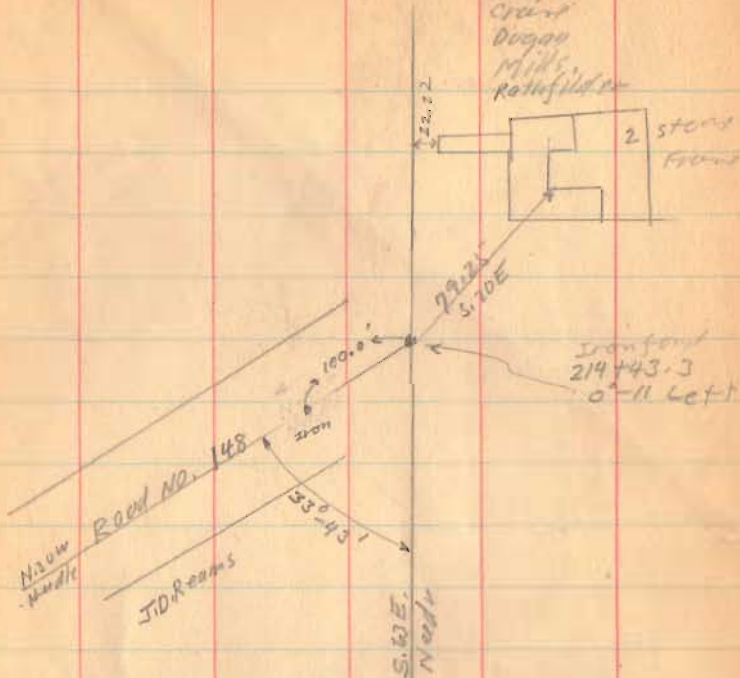


1/2 story
Frame



82.30
200+92

Iron
1 1/2 left
199+88

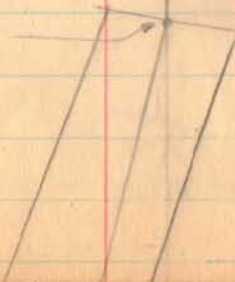

Road 153


220+00

1536

INDEXED ON MAP

MIDDLEBURG

56

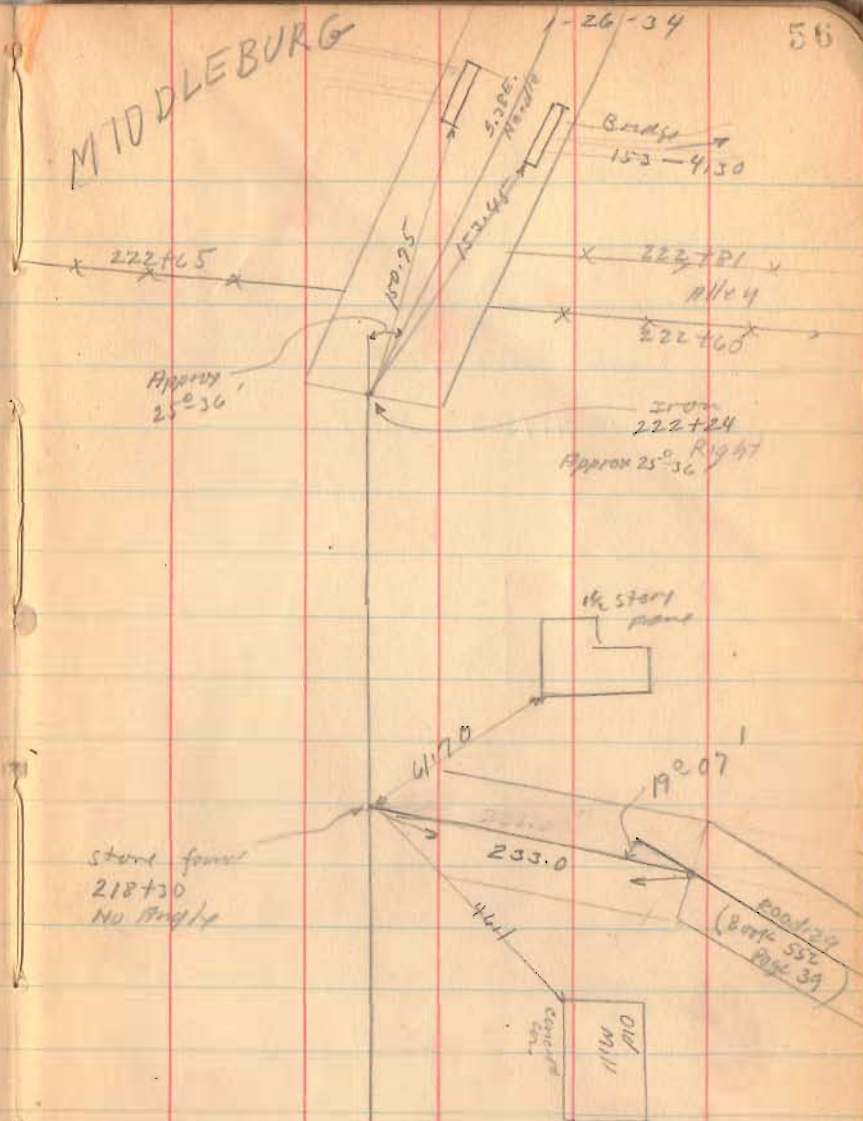

Road 153

Length 23424 Feet.

Length 4.4363 Miles

1536
INDEXED ON MAP

1-20-34

57

Green St.

S.H. 607
Route 280



(See Book

558 Page
45)

234+24

MIDDLEBURG

Columbus St.

230+92 Apartment E

Urbana St.
Middleburg