

3-22-39


W. J. G. S.
Phillips
- 1776

Co Line Survey


Logan & Union

INDEXED ON MAP


4442

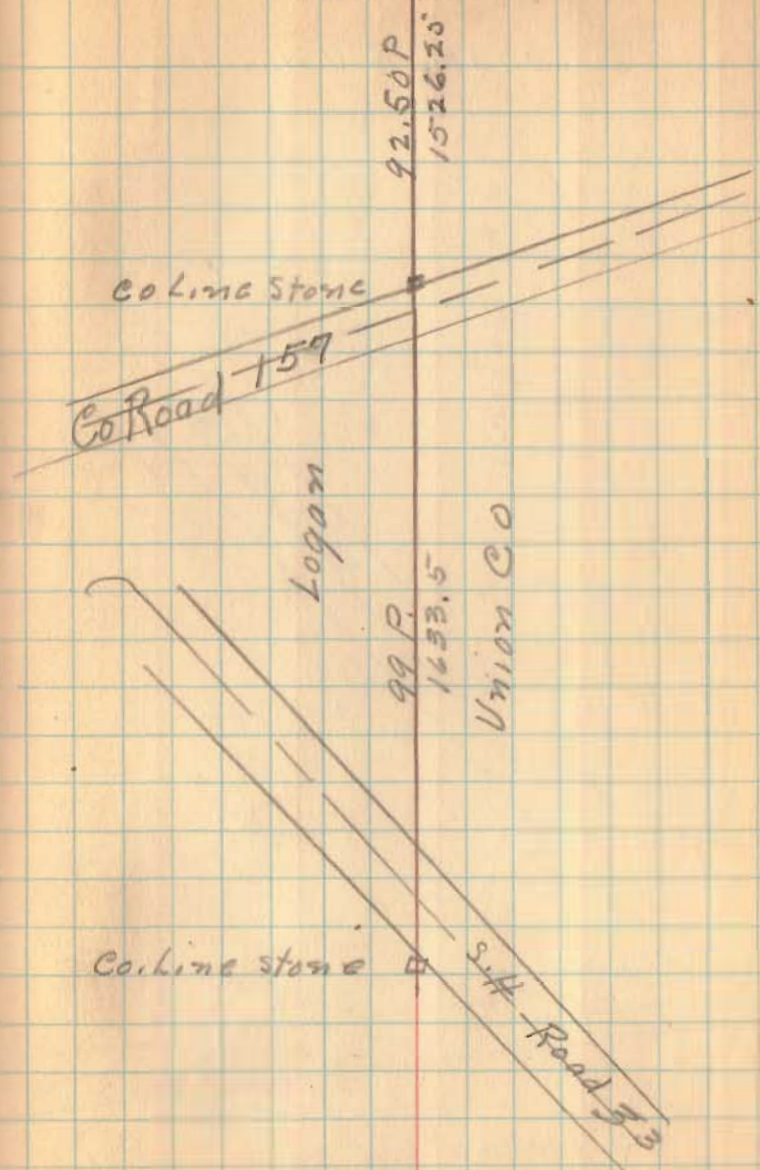


Co Line.
Logan & Union

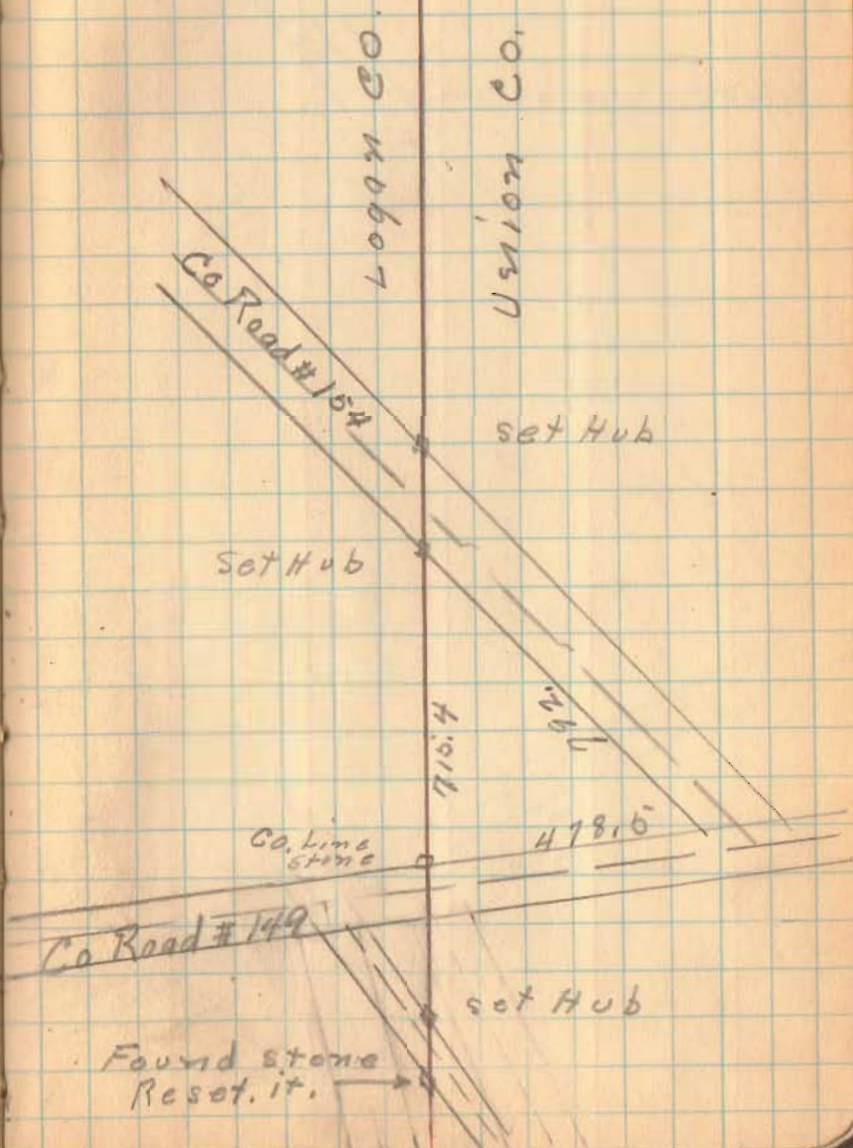

Co Line
Logan & Union

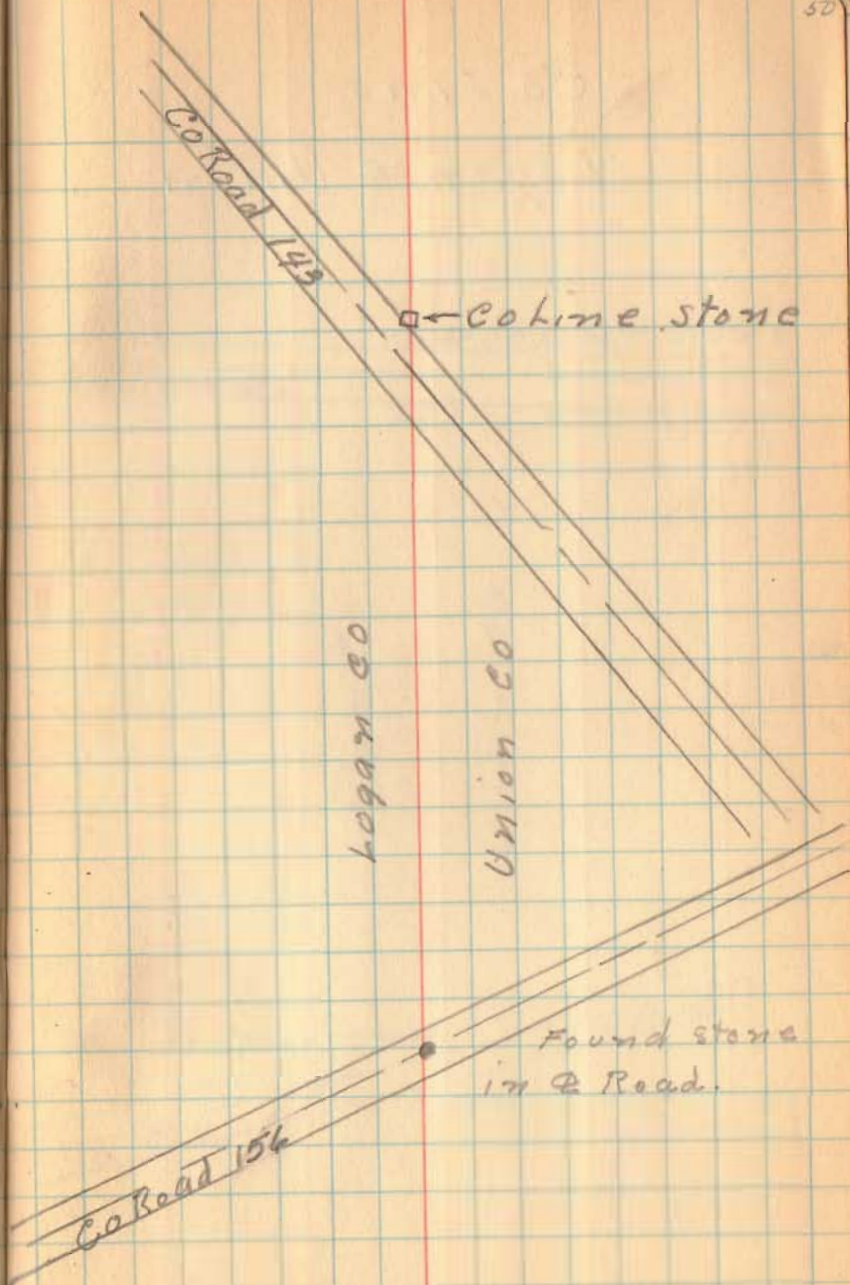

Co Line
Logan & Union

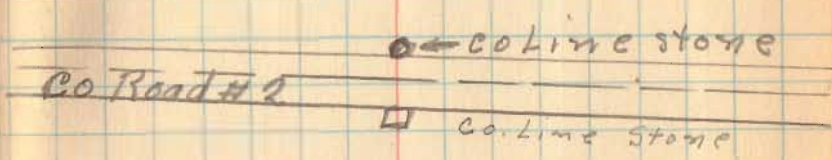

Logan Co

Union Co.

