

(See's said Survey thence $\text{N} 52^{\circ} \text{E}$ 109 poles to the beginning¹²
containing 50 acres in the N.E. corner of Thomas Deas survey on
the water of Darby's Creek c. 1545 - 42° easterly variation.

David Warner

John Sharp $\frac{1}{2}$ b.c.

Isaac Warner marker

Warren Williamson

Surveyor of Logan County

9th mo. Sept. 26th 1823. Survey N^o 20.

8171

Surveyed 50 acres of land for

Joseph Stokley; beginning at 3 beeches from one root
9 of the trunks are some decayed, I marked 2 black astis, all
standing on the east bank of Beaver run of Darby's Creek
the south east corner of George

McCrudie's Survey c. 3155 thence

$\frac{1}{2}$ b.c.

138°E with the east line of McCrudie's Survey 58
acres said survey 73 1/4 poles to
an ash tree, and buckeye.
thence $\text{N} 52^{\circ} \text{E}$ 109 poles to 2 beeches
and sugar tree, thence $\text{N} 38^{\circ} \text{W}$
 $73\frac{1}{4}$ poles to 2 sugar trees and a

180°E 109

bush in the north line of McCrudie's Survey 1545 - thence with said line
 $\text{N} 52^{\circ} \text{W}$ 109 poles to the beginning containing 50 acres in the north
west corner of Thomas Deas Survey 1545 on the water of Darby's
Creek - 42° easterly from the original lines allowed.

David Warner

Warren Williamson

John Sharp $\frac{1}{2}$ b.c.

Isaac Warner marker

Surveyor of Logan County


9th mo. (Sept. 26th 1823) Survey N^o 21.

8172

1823
1824

Surveyed and divided 42 1/2 acres of land for
Jose H. Garwood Beginning at the south west corner of George
McCrudie's Survey c. 3155, originally 2 beeches, they being dead a
sugar tree and hickory unmarked, thence a 23 28 290 poles
crossing beaver run of Darby's Creek at 250 to [2 sugar trees
and 2 elms easterly to McCrudie's said Survey] thence 138°E 176 poles
to 2 beeches easterly corner to Levi Hollingsworth's Survey c. 3160
thence $\text{N} 52^{\circ} \text{W}$ 390 poles crossing said branch at 2 36 poles to

2 beeches southwesterly
corner to Hollins
= worth laid
survey, thence
er 88 W 174 poles
to the beginning
containing 4 24 $\frac{1}{4}$
acres the whole

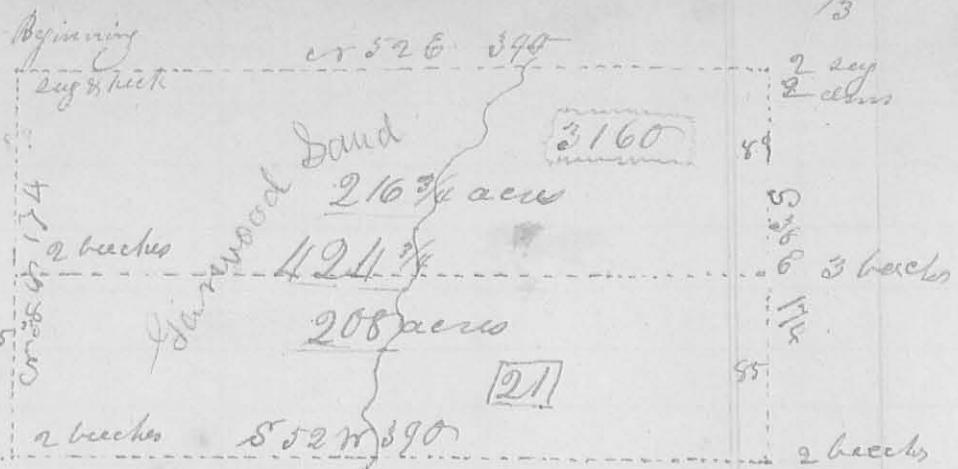

of Levi Hollinworth's said survey on the waters of Darby's
Creek - The division line begins in the westerly line S 38 E
89 poles from the beginning thence er 52 E 390 poles cropp
ing beaver run to 3 beeches in the easterly line of said
Survey, making 216 3/4 acres on the northerly side and
208 acres on the south side of the division line -
 $\frac{1}{4}$ of a degree easterly variation from the original
lines were allowed


Jonathan Garwood
John Bishop
Daniel Garwood marker


J. W. Marion
Surveyor of Log and
Land

9th inst. (Sept, 27th 1823)

SURVEY NO 22

Surveyed 222 acres of land for
José H. Garwood, beginning at 2 beeches & sugar trees S.W. corner
to later on his survey c 463 688 thence S 52 W 208 poles crooping a
branch at 184 poles, to 2 sugar trees and red oak S.E. corner to Peter
Pelham's survey er 46 97
thence er 38 W 171 poles
to 3 sugar trees in the
east line of Pelham's
laid survey thence
er 52 E 208 poles
crooping a branch at
104 poles to 2 ash and
iron wood in the
west line of Yancey's
said survey, thence
with said line

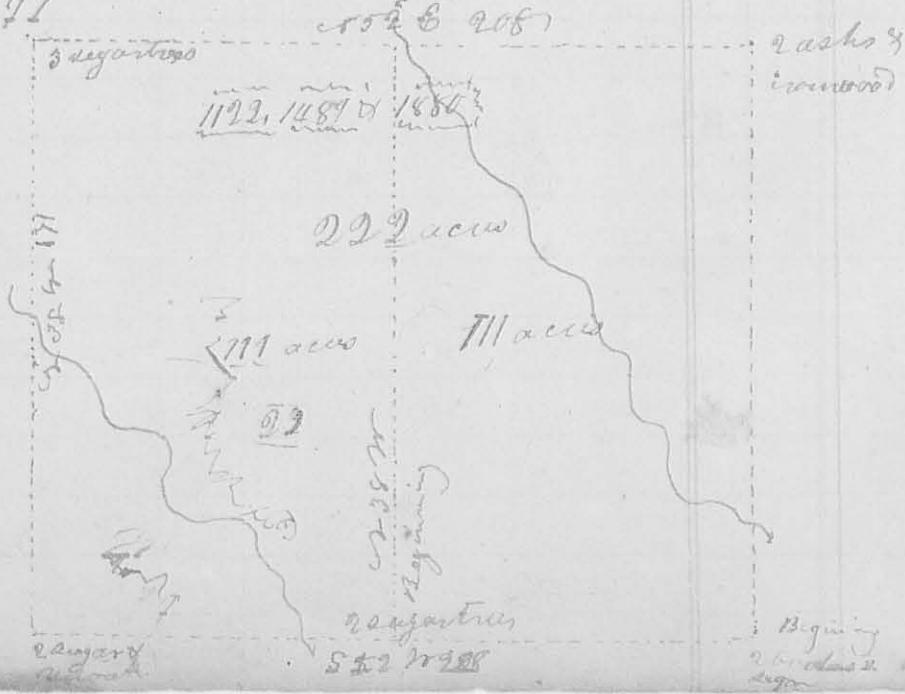

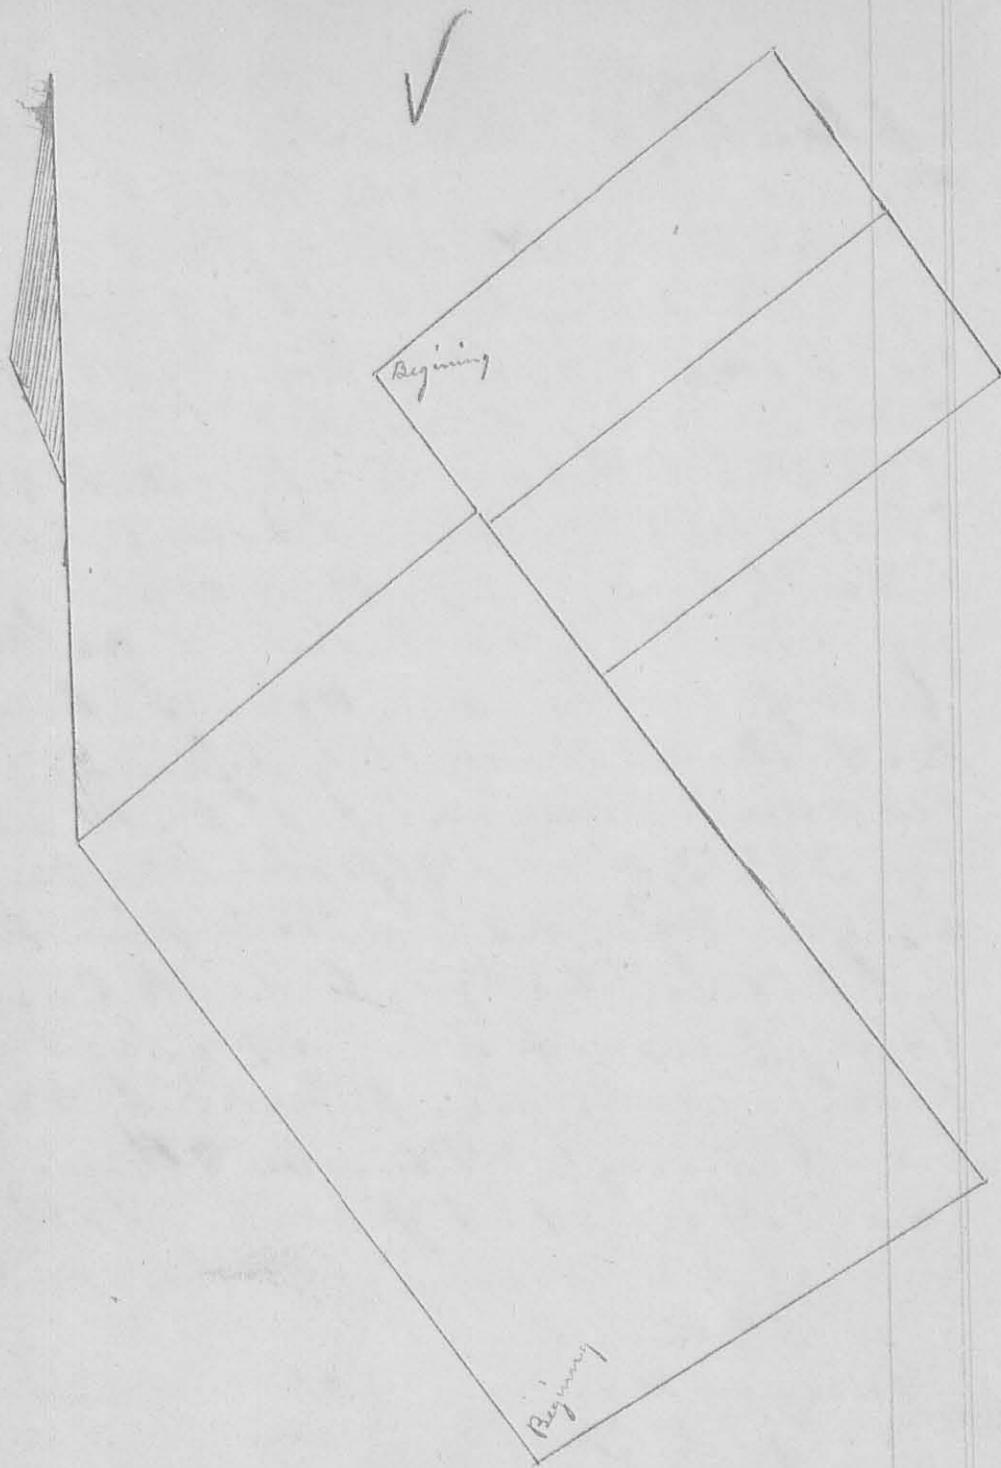Survey
552

December 28th 1846. Being presented with
the following Notice to list; Mr John W
Davis, On Monday the 28th of this Month
be intimated to have a Survey of our Land
and the corners of the same established by
the County Surveyor, and can attend
if you see proper Dec 31st 1846 J. W. Warner
and the services of this and other Similar or
notices are W. Miller, Isaac Sparks, Job
Smith, Joshua Ballinger, and John

than B Garwood being acknowledged
I proceeded to make Survey as follows
Jose H Garwood first being first and
Sworn in behalf of Jesse Warner and
others made answer to the following ques-
tions as follows

1 Do you know the South West corner of
Survey or 3155, entered in the name of Geo-
rge Mc Creadie is, & if so point out and
state by what means your ascertainment it to
be such?

As Administrator of Daniel Garwoods
estate I employed J W Marmon, County
Surveyor, on Sept 26 1823 and by the entire
Survey of Survey or 3160 ascertained the
corner to be near two Elms standing ^{now} dead
Q How far do you think the corner to be from
the dead Elm?

I think it is about six links North of the
dead Elm.

J H Garwood

John Sharp Jr being first and sworn in
behalf of Jesse Warner & others made an-
swer the following questions as follows

1 Do you know where the South East
Corner of Survey or 3155 is, and if so point
it out and describe it?

Said corner was marked on two sugars
and an Elm and I think from the position
of the trees that the corner was about
7 links S from dead Elm

2 By what means did you ascertain
this to be the corner?

I was Chain Carrier for J W Marmon
when said corner was established

John Sharp Jr

In accordance with the above Evidence Begun
as above described And ran N 58 E passing
Swamers corner at 111 poles and Job Smith's
corner at 112 $\frac{1}{2}$ poles crossing flat branch
at 138 poles, 221 poles to point agreed upon
by parties present; and ascertained by course
and distance of this and the next line to settle
corner. Planted stone. Present Isaac, Jerry
& David Warner, Wm Wittery, James and
John Edwards, then S 35 $\frac{1}{2}$ E crossing Midway
road at 178 poles 34 $\frac{3}{4}$ poles to a stake in
the east line of Ethos Deans Survey. Present
Isaac, Isaac & David Warner, James Edwards
and John Ballinger, then S 53 W 218 poles
to an Ash Buck Eye of Elm, Planted stone
Present Isaac, Isaac & David Warner
Joshua Ballinger and James Edwards, then
S 37 $\frac{1}{2}$ 328 poles to the beginning containing
459 $\frac{1}{2}$ acres
Isaac Sparks { et al A H Hartman
C 82 C 60

At the same time surveyed for John Bel-
linger and James Edwards the following ad-
joining lands. Beginning at corner of Ethos
Deans Survey (which corner was ascertained
by the course and distance of S 53 E 218 poles
from 3 Buck Eyes and two black Ash (among)
on the east bank of Bear river being the east-
erly corner of Philip Slangetor's Survey &
3154 and corner to George Mc Creadies Survey
& 3155; to point where planted stone.

Joshua Ballinger, John Ballinger, James &
John Edwards, present,) and run N 57 $\frac{1}{2}$ E
crossing flat branch at 31 poles 21 $\frac{3}{4}$ poles
to Red Oak, Sugar and Hickory (Sugar has
some appearance of Hickory left) Planted stone

Planted Stake present at Cr, David and
Jesse Warner, Jas. Edwards John & Joshua
Ballinger then S 35 $\frac{1}{2}$ E 16 $\frac{1}{4}$ poles to Iron
Woods & Buck / Buck gone and one Iron iron
down) then S 53° W 26 $\frac{1}{4}$ poles to a Stake two
White Oak and two Buck in Warners line
then with Warners line N 36 $\frac{1}{2}$ W 79 $\frac{1}{4}$ poles
to Stake which point James Edwards &
John Ballinger agreed upon as their cor-
ner present & Cr chs, Jesse and David Warner
and Joshua Ballinger then N 52° W E 210
poles to Stake agreed upon as another cor-
ner between said James Edwards and
John Ballinger. John Ballinger's lot
contains 106 $\frac{1}{4}$ acres James Edwards
lot contains 105 $\frac{1}{4}$ acres.

A. K. Hartison

C. S. G. C. O.