

oak & hickory: thence east 45 poles to a stone 345  
in the east line of the whole tract: thence with said line  
south 45 poles to the beginning

W. Beckman  
Robt. Hamilton

John Mechem  
County Surveyor Logan County

Survey 3  
N<sup>o</sup> 511 3 4<sup>th</sup> Mo. April 14<sup>th</sup> 1843  
Surveyed for Jacob Grieb Attorney for James Birby  
a lot of ground in Zanesfield: Beg. at a Stone N.W. cor. to a  
lot conveyed by In<sup>o</sup> Pinn & wife to Jacob Grieb: thence with the north  
line of said lot S 74° E 7 <sup>5</sup>/<sub>16</sub> poles to a Stone: thence N 45° E  
4 poles to a Stone: thence N 78° W 9 poles and 19 links to a Stone;  
thence S 69° W 2 poles and 23 <sup>1</sup>/<sub>2</sub> links to the beginning  
Containing 30 square poles. Ch<sup>o</sup> Mechem Sur Logan Co


Survey 3  
N<sup>o</sup> 512 3 4<sup>th</sup> Mo. April 21<sup>st</sup> 1843  
Surveyed for William Watson  
120 <sup>1</sup>/<sub>2</sub> Acres of land part of Survey N<sup>o</sup> 9905  
on the waters of Cherokee Run: Beginning  
at an Ash and Ironwood on the bank of the creek  
(both down): thence S 10 <sup>1</sup>/<sub>2</sub>° E 136 poles to 5 beech (all  
down): thence N 77 <sup>1</sup>/<sub>2</sub>° E 111 poles to a Black  
walnut and beech (the beech is down): thence N 10 <sup>1</sup>/<sub>2</sub>° E  
205.4 poles to 4 sug. on the bank of the creek  
(3 down): thence with the center of the creek where  
distance 184.2 poles to the beginning  
Adam Hanes 3 Ch<sup>o</sup> Mechem  
Moses Workman 3 Surveyor Logan Co

Survey 3  
N<sup>o</sup> 513 3 6<sup>th</sup> Mo. June 30<sup>th</sup> 1843  
Surveyed for Cicin Thomas part of Survey  
N<sup>o</sup> 4570 as follows: Beginning at a Sugar tree  
and beech southwesterly corner to Survey: thence with  
the original west line thereof S 19° E 456 <sup>1</sup>/<sub>16</sub> poles to a  
sugar stump corner to William Green's land: thence N 56° E  
287 <sup>1</sup>/<sub>16</sub> poles crossing a branch at 24 another at 36 another  
at 117 & another at 126 poles to a Stake in the located  
line of the road leading from Middlebury to Polkton's

Amory  
 No. 519  
 8491

349

Plat of M Colloch's Addition to  
 Jamesfield  
 Bellefontaine road  
 79° E

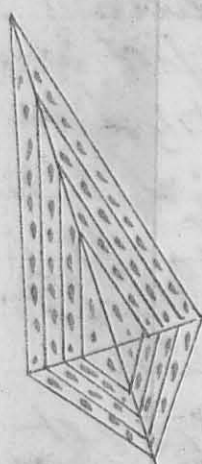

W  
 E



The annexed plat represents M Colloch's addition to the Town of Jamesfield located on James Calderwoods Survey No. 3137 on the waters of Mac river and on the lands of N & Elliott M Colloch; Lots No. 1 to 24 inclusive



front on the Bellefontaine road, <sup>55 feet</sup> extending back  
 210 feet to Sugar Alley; Lot N<sup>o</sup> 1 fronts on  
 Walnut alley; Lots N<sup>os</sup> 4 & 5 front on Green  
 alley; Lot N<sup>o</sup> 8 fronts on Main Street; Lots  
 N<sup>os</sup> 9 to 16 inclusive fronts on Columbus street  
 55 feet extending back to Sugar alley;  
 Lot N<sup>o</sup> 9 fronts on Main Street 327 feet; Lot  
 N<sup>o</sup> 12 fronts on Green alley 30½ feet; Lot  
 N<sup>o</sup> 13 fronts on Green alley 300 feet; Lot N<sup>o</sup>  
 fronts on Walnut alley 274½ feet; Lots N<sup>os</sup> 17 to  
 24 inclusive front on Columbus Street 55  
 feet, extending back 170 feet to Apple tree  
 alley, Lot N<sup>o</sup> 17 fronts on Walnut alley; Lot  
 N<sup>os</sup> 20 and 21 fronts on green alley and Lot N<sup>o</sup> 24  
 fronts on Main Street; Columbus <sup>extended</sup> Street is 60  
 feet wide and bears N 80° W; Main Street is  
 60 feet wide and bears N 16° 20' E. Sugar alley  
 extended is 16 feet wide, and runs parallel with  
 with the North line of the town plat which is  
 N 73° W; Green alley is 16 feet wide and bears  
 N 16½° E the same as the present bearing of  
 Walnut alley; Apple <sup>tree</sup> alley is 16 feet wide  
 and runs parallel with Columbus Street;  
 there is a lime stone planted at the N. E  
 corner of Lot N<sup>o</sup> 1 with the N. E corner thereof  
 at the point of beginning; this Stone bears S 69° W  
 85 feet distant from the S. W corner of Lanson  
 Curtis dwelling house and 31 feet south of the  
 line between Lanson Curtis and N. J. and  
 Elliot M Colloch at the distance of 190 poles  
 from M Colloch's South West corner.

I certify that the foregoing plat is correctly laid  
 down by a scale of 100 poles to the inch from  
 actual survey of the ground.

Surveyed Dec 19<sup>th</sup> 20<sup>th</sup> 1845 John Mechem Surveyor  
 of Logan Co. O