

My 29/1827

C H Austin
 James B Dillon
 Joseph S Carl
 Robt Cutland
 W J Whitcroft
 J H Garrison

my 30th

I proceeded to take Evidence & make Survey as follows,
 having first from the Beginning Corner described in John and
 Mary Sharp's Deed of Conveyance to the Day Meeting As
 "Beginning at a sugar tree by a Spring about 30 poles South-
 erly from John Sharp's dwelling house" but the point
 where ~~the~~^{the} sugar tree stood being as put to me, John Sharp Esq
 Jesse Warner, Samuel Warner, John Newman, and J Sharp
 On behalf of Applicants, being first and qualified,
 testified as follows.

1 Question of Applicants to John Sharp Senior

is near which ~~the~~^{the} Do you know where the Spring
 is near which the sugar tree stood at the Beginning Corner of
 the meeting house lot

Answer, About ten feet from the Buck Eyes front stamp
 2 Question of Sam, Do you know where the sugar tree stood
 which was marked as a corner

Answer, I Do not

3 Question of Sam, Did you ever see any marked trees or
 bushes near the Spring

Answer, I think I have seen some bushes about ten
 feet S 15 W from the three Buck Eyes marker

4 Question of Sam, Was the Spring on the meeting house
 lot, Answer, I told them to take it in.

I Do

John ⁱⁿ Sharp
 mark

1 Question of Applicants to Jessie Warner

Do you know where the Spring is near which a sugar tree
 stood at the Beginning corner of the meeting house lot

Answer, I think about ten feet West from the three
 buck eyes from one stamp

2 Question of Sam, Did you ever see the sugar tree
 which was marked as a corner near the Spring and
 if so where did it stand

3 question, Did you ever see a sugar mark
Spring ~~and if so~~ which was stoned to you as a
corner and if so where did it stand

Answer, I saw a sugar tree about 6 poles from
the three Buck Eyes in a west course

4 question of Sam, How long since it was stoned
to you and by whom was it stoned to you?

Answer About 30 years ago it was stoned to me by John
and Joel Cull as their corner of the meeting house lot

Jesus Warner

1 Question of Applicants to Sam Warner

Do you know where the spring is near which the sugar tree
at the corner of the meeting house lot

Answer I suppose it to be at or near the three Buck Eyes
I question of Sam, Did you ever see a sugar tree marked
as a corner near the spring and if so where was it

Answer, I believe I have seen a sugar tree about 6 poles
from the three Buck Eyes in a western direction

3 question of Sam, Did you ever hear it spoken of
as a corner tree and if so by whom, Answer, I never did

This deposition was rejected to be signed

1 Question of Applicants to John Marmar

Did you ever see the sugar tree which was
marked as a corner of the meeting house lot near the
spring and if so where was it.

Answer, I was not present when the corners were made
but I have seen it frequently and think it stood about 4
poles from the Buck Eyes in a western direction

2 question of Sam, Do you know where the coal house
used by the friends formerly stood and if so where was it-

Answer, The door in the east end of the house stood about
3 poles 19 links from the Buck Eyes,

3 question of Sam, About what time was the coal house
built, Was it intended to be on the meeting house lot, And were
the lines and corner trees standing when it was built,

Answer, In about 1810 or 1811, Ana was intended to be
on the meeting house lot - Ana I think the lines and corner
trees were at that time standing.

1 Question on Cross Examination to same

Do you know that the Coal house was on the lot

Answer, Only by hearsay John Morrison

1 Question to Jack Sharp & Affidavits

Do you know where the sugar tree
corner was near the spring, Ana if so where was it.
Answer, I think it was west of the three Buck Eyes

of Sharp

Jack Curl being first and sworn on behalf of
Yes S Curl says in answer to 1 Question, Did you
ever see a Beginning corner to the meeting house lot, if
if so state where it stood

Answer, I think it stood about 2 poles 14 links
from the Buck Eyes in a North direction

2 Question of same, Did the tree stand where a stone
is now planted

Answer, Thereabouts as near as I can recollect,

3 Question, Was it marked for a corner of the meeting
house lot, Answer, It was

4 Question, At what time did you see the marks
on this tree, Answer, About 1817

5 Question, Do you know anything about this cor-
ner since that time

Answer, In Company with Jas S Curl I bought
to the stone above mentioned from Jas Curl Sr
and arrived from this corner

6 Question of same, Did the sugar at that time
stone where the stone now stands,

Answer, As near as I can recollect it does and
I set my fence to it

Cross Examined by Affidavits

1 Question, When was it that you fenced to this cor-
ner - Answer, In about 1828

2 Question of Sam, How long did the fence remain
here, Answer, until I removed it to Green Co

3 Question of Sam, Was the stone put there while the fence
stood, Answer, I do not know

4 Question of Sam, Was there a corner of your field or
land ~~or was it only~~ where the stone stands, or was it only
in the line of your land,

Answer, It was at the corner,

5 Question of Sam, Is there any land marks now stand-
ing, to show that the stone now stands where you made
your corner, And if so what is it

Answer, The branch ran thru or four feet west of the
place where the stone now stands,

6 Question of Sam, Has your son sold and conveyed
the land and if so to whom,

Answer, I do and it has been conveyed to Joseph S. Curt
of Joseph Curt Sr

7 Question of Sam, Are you a son of Joseph Curt Esq
Answer, I am

8 Question of Sam, In the area from Joseph Curt Sr to
Joseph Curt Jr was this corner of the meeting house lot
described as one of the corners, Answer, It was

9 Question of Sam, Did you receive any property, either
real or personal from the estate of Joseph Curt Sr, and
if so how much

Answer, I am not in my memory dead to receive an equal
share of which I have already received a part

Joel Curt

Exceptions taken to the Joel Curt's testimony of Apprising
Charles Curt being first and qualified on behalf of
of Joseph S. Curt says in answer to 1 Question
What do you know about the meeting house lot
Answer, I recollect that a sugar supposed to
be the corner stood at or near the place where
a stone now stands And was the corner from
which Jas S. Curt and Joel Curt divided their land

2 question by same does the sugar tree marked as a corner, Alabama, I can not tell,

3 question by same, Cross Examined by Appellants
Affidation, When and by whom was that stone planted
Answer, Sometime during winter of 1826, L7

2 Question by same does there any fence or other
land marks then when the stone was planted

Answer, I do not think there was,

3 Question by same, what has become of the sugar tree
which you say formerly stood there, and how long has it
been gone

Answer, It blew up and is decayed and rotted away
about 14 or 15 years ago

4 Question by same, Are you a son of Joseph Curl yes
How low old are you, Answer, I am now in my 28 year

Charles Curl,

In accordance with the Evidence which seemed to carry
repose, to the greatest extent; with the Conveyance
for this lot, and particularly with Jesse Burners and John
Marmans Evidence, the latter of whom pointed out
a place as being in very near the place where the
sugar stove, which place prior to course and distance
to be S 59 E 30 poles from the house formerly occupied by John
Sharp and to be N 77 1/2 W 4 poles 22 links from B Buck
Eyes from our Stump or rather root - And also in Con-
sequence of this point being the following Courses
and distances from a large lime stone now standing
as the South East corner of said meeting house lot
to wit, S 49 W 14 poles, then N 41 W 16 poles 13 links; the
above mentioned large lime stone being placed at
a point which was ascertained to be the South East
corner of the lot by the testimony of witnesses hereinof-
fore called, and the courses and distances from the
lime stone to the place pointed out by James Mar-
man being the calls of the deed for the lot reserved
I planted a lime stone as the beginning corner of the

Mutting Louse lot 30 poles S 67° E from the corner formerly occupied by James Sharp, and 4 poles 22 links or 77 ft N from the Buck Eye frame corner and ran S 41° E 16 poles 17 links to a point in Olden-trim's line, where planted a stone, witnessed by White Oak 2 1/2 ft dt, 18 1/2 ft E 4 poles 1 link from stone then S 49° E 14 poles to a point in Antmins line, at which place the following testimony was taken,

Mr Evans being first duly sworn said in answer to Question by Applicants, Do you know where the stone called for in Antmins line at the S 8 or E corner of the Mutting Louse lot was originally made and if so where was it

Answer, I think there never was a stone planted, but I think it was not more than one rod from where the 14 poles came to from the first corner called for in D Antmins line, and would think as likely to be exactly at the ~~same~~ distance as any distance from it.

Question by Sam, What means does you of knowing where this corner was made

Answer, By seeing Jasua Sharp Survey it when it was first run off for the purpose of School house lot when carrying of James Sharp for that purpose

Mr Evans

Jasua Sharp having been sworn in answer to Question by Applicants, Do you know where the South East or E corner of the Mutting Louse lot in Antmins line was originally made and if so where was it

Answer, I think the distance of 14 poles from the first corner named in Antmins line is not 5 feet from the place where the corner was, and I am enabled to come to this conclusion by the old road marks, and that it is 2 poles S 2 E from a Bush 16 1/2 ft - Jasua Sharp

3^d
Joseph Glascock being first sworn on part of
Applicants, 1st Question, State whether Joseph
Curl Jr ever stoned you the East or S E corner of the
Meeting house lot and ana if so when was it

Answer, Joseph Curl and Abram B Dillon stoned
me the S E corner of the Meeting house lot and I think
it was about 2 poles S 2 E from a Bush 16 I D, which
Conclusion I come to from the position large
black stump immediately across the track of the road
from where the corner was pointed out to me
2^d Question by Sam, who owned the land adjoining this
corner at the time it was pointed out to you

Answer, the Meeting house lot lay on one side, Mr
Dillans owned on the other, and Mr J S Curl owned the
farm adjoining the Meeting house lot on the west
west,

3^d Question by Sam, were you ever stoned near N E
corner between him and land owned by Dillon
ana if so whom and when is it

Answer, the corner was stoned to me by Jas S Curl and
A B Dillon, and a stone now near to the remains
of a bar post to be the corner,

Cross Examination by J S Curl,

1st Question, when did I stoned this corner

Answer by Sam, when the land was run off ~~to~~ by A B
Dillon to Mr Jas S Glascock

In accordance with this testimony I planted a large live
stone for the corner witnessed by a Bush 15 I D, or 3 3/4 W
53 links from stone, then ran N 37 W 15 poles 17 links
to a point claimed by Applicants to be the corner, and
which was believed to be the corner from the corres-
pondence of courses and distances rather than a point
referred to by the testimony following to wit-

Joel Curl on behalf of J S Curl

1st Question by J S Curl, state when the west East
corner of the Meeting house lot is, and when your corner

at the same place was

Answer, I think the Ironwood stood about 3 poles
18 links East of the present track of the road, and on
the bank of Channel of branch as then run.

Question of Sam, How did you know this to be
the corner of the meeting house lot?

Answer, By my father & Isaac Dillan looking at the
corner when the road was first run and Mr Dillan
saying that the road would be on the meeting house
ground, and I saw it measure from the corner to
the corner at the spring,

3 Question of Sam, What was the distance to the spring
Answer about 25 or 26 poles

Cross Examined by applicants

1 Question, Was there any marked trees at the
corner the first time you saw it as any at any
other time,

Answer, Not the first time I saw it but I think
I did after.

Joel Cull

According to the course and distance from the last
stone set, I established the corner in the west line of
line of the road, but as it would likely be removed by
imperceptibly if the road did not plant any stone
but took witness as follows; to wit, a large stone
in natural position, 5-poles 1 link S 1 $\frac{1}{4}$ W from
corner and a lime stone 12 $\frac{1}{2}$ links S 87 $\frac{1}{4}$ W from
corner, then ran S 67 $\frac{1}{4}$ W 25 $\frac{3}{4}$ poles to the begin-
ning containing 1 $\frac{1}{4}$ acres, the last course and
distance given from calculation, corner stones
planted in presence of George Warner, Isaac Sparks,
David Wilkins, Thomas Dillan, Jas S Cull, and
Smith Seaman

John Clugerman 3 cler
John Curston 3 cler

A. H. Hartman
C. B. Yeo


84

Survey
5901

Survey July 26 1827 for
 Jacob Boevers the following
 lot of land being part of
 Survey or^o Beginning
 at a grey Ash & Iron Woods
 corner to S 10 E 1/2 line & then
 from N 12 W 117 poles to a blue
 Ash corner to Jas Hull's line
 and Jacob Kems in a County road
 then S 18 W 66 1/2 poles to a stone
 in said road then S 12 E 107 poles to a sugar tree
 & a Bush in Jacob Boevers South line then with
 said line or N 18 E 66 1/2 poles to the Beginning Con-
 taining 11 1/2 acres

Jas Hull
 Jacob Boevers
 Saml Kems

A. W. Martin
 C. L. G. Co.

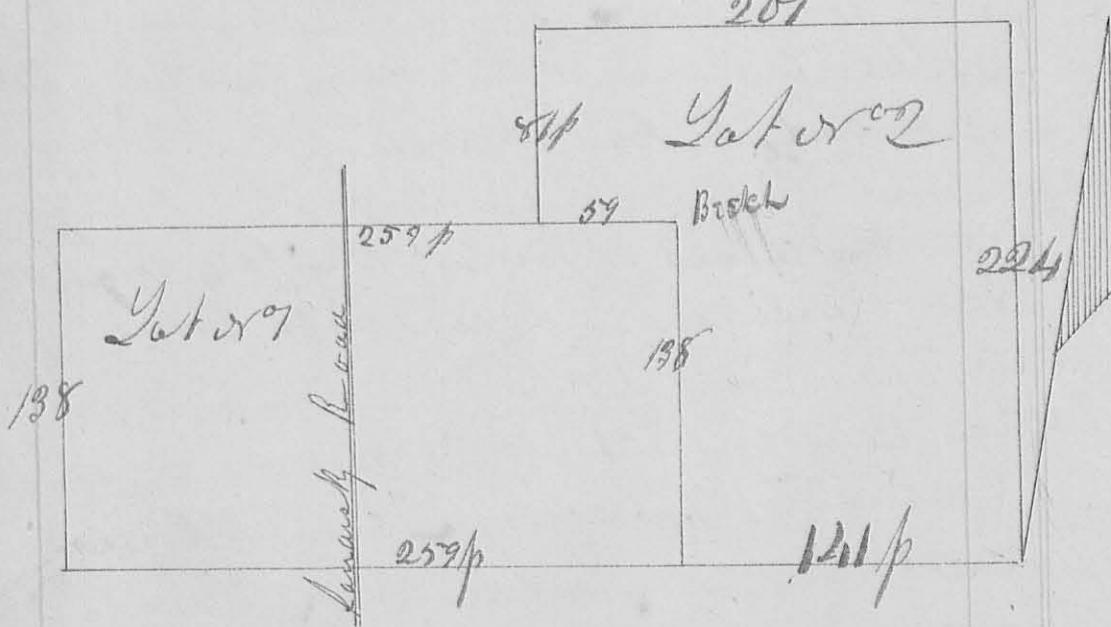Survey
591

25

Surveyed Aug 28th 1847 for John Anna Jacob
Grabel the following described lands; by
Surveyor &c and Beginning at
at a Blue Creek, two sugars and a buck (asl
gave) corner to John Garrison's Peterfield's
land Anna run N 10° W 138 poles to a sugar
and a Buck, then N 80° E 200 poles to 2 sugars
and a Buck, then N 10° W 84 poles to 2 sugars
in the line of me Arthur's Survey or 010631 of
corner to J Evans Survey or 12536, then
N 80° E 201 poles to 3 Buck & a sugar then S 10° E
221 poles to or corner of Peterfield's land
then S 80° W 401 poles to the beginning
containing 1048 Acres

See plat for size of lots

A. M. Garrison
\$54.00

Survey
592

(8529)



V

Surveyed Aug 30th 1847 for Horicklands
and above as the following describes
lands being part of Survey rd 9902

Lot or 1, Beginning at a Stake in Chero-
ke ~~run~~ and Leinster road (plantation)
at the SW corner of D Garrett's land &
run with Garrett's line or 12 W 200 poles to a
stake (W Oak 20 I.D S 2 R E 25 links, and; 8
W Oak 18 I.D S 61 W 2 R links) then S 78 W
80 poles to two grey oak, 6 I.D, then S 12 E
200 poles to a stone in Leinster road
then with said road or 78 E to the Begin-
ning Containing 100 Acres


Lot or 2, Beginning at a stone in
Leinster road South west corner to lot
N^o 1, And run with the west line thereof or 12 W
200 poles to a Stake in Leinster road the
with said road or 78 E 80 poles to two grey
Oak 6 I.D, then S 78 W 80 poles to a stone then
S 12 E 200 poles to a stone in Leinster
road then with said road or 78 E 80 poles
to the Beginning Containing 100 Acres

Jason Thompson C. A. Harrison
Jacob Barlow C. S. Scott

Survey
593

V

87

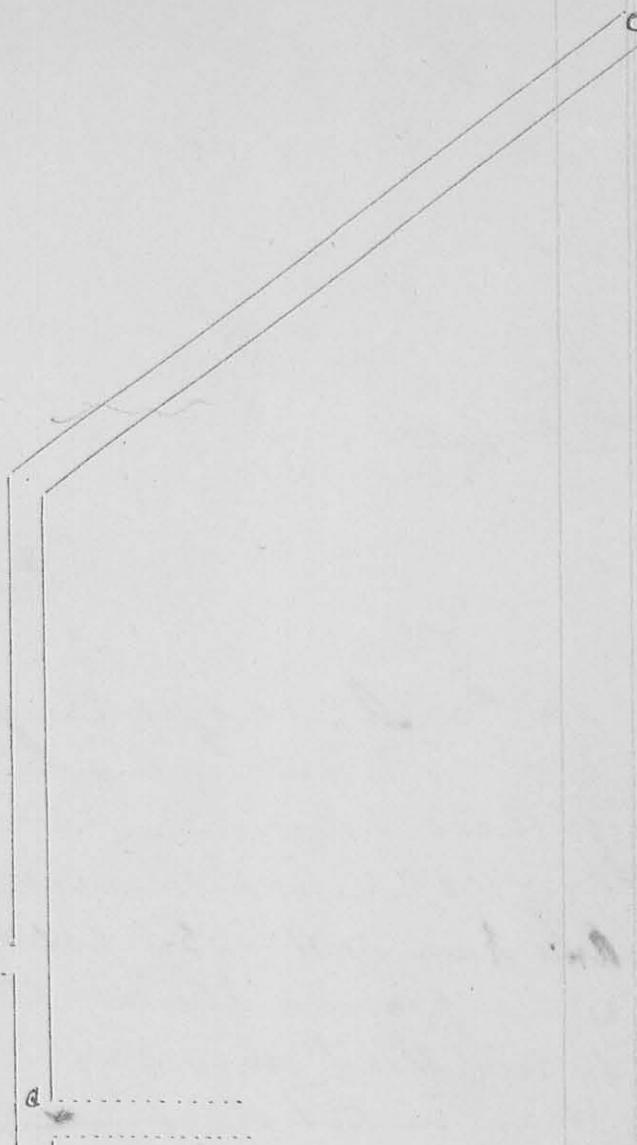

Surveyed Aug 10t 1863 for Johnathan Plum
A County Head as follows; Beginning at a
point in the Logansville road one mile road
opposite Mr Kpatrick's house (house of Plum)
and run N 52 E 78 poles
to a point 24 poles, S 3° E from the place
^{which} Cherry ~~not~~ since was about the place
where the angle ~~at~~ at the end of his house
in said road was made when it was laid
out & this plot was made at time of survey by J H Blackman
but mislaid until after my decease Q S Yeule

Survey
594



Surveyed Aug 30th 1867 for
Fleming & part of Survey lot as
follows: Beginning at 1 small Hickories, a
grey Ash, and a Beech Oak (one Hickory gone)
and run N 11 W 126 poles to an Ash and a White
Elm (planted stone) then S 29 W 125 poles
to two Hickories and a White Oak (planted
stone) in the Roberts line then S 26° 15' E 130
poles to a Small Ash, W Oak and Hickory
then S 78° 10' E 111 1/2 poles to the Beginning
containing 100 1/2 acres

J. M. Hartigan
© S. Geo. O.

Survey
595

(853D)

8^o 2

8^o 1

Surveyed Sept 1st 1847 for James Stewart
and Lucia Elder, a part of Sect 13, 32, N 15
Lat or 1^o, Beg at the NW Corner of said Sec-
tion (W Oak 16 I.D., S 86° E 28 links dist; And W Oak
20 I.D., N 58½ W 110 links dist) And run S 17° W
119 poles to a stake in J Lawrence's field
then N 88½ W 26 poles to a stake (W Oak 22
I.D., S 50½ W 32 links dist) Then S 17° W 13 poles
to a stake south of Spring branch, then N 88½ N
13½ poles to stake (W Oak 24 I.D., N 40½ W 25 links)
Then N 11° E 151 poles to Stake (Hickory 18 I.D.,
S 22 E 15 links), then S 88½ E 162½ poles to
the Beginning Containing 106 5/100 Acres

Lot 8^o 2 Beginning at the NW Corner
of 8^o 1 (Hickory 18 I.D., S 22 E 15 links) And
run N 88 W 35½ poles to a stake in Greenville
treat line then with said line S 80 W 132 poles
to the NW Corner of said Section in Greenville
treat line then S 17 W 38 poles to Greenville
town, 136 poles to a stake in Court house
(W Oak 18 I.D., N 88 1/4 E 3 1/2 14 links) Then S 88 1/2
162½ poles to Stake W Oak 24 I.D. & N 40 1/2
26 links, then N 11 1/2 E 160 poles to the begin-
ning containing 153 3/100 Acres

Elias Thompson
John Miller 3 chm

J. H. Harrison
C. S. L. Co. O

Sunny
596

✓
wwoz

wwoz

Surveyed and Subdivided
Sept 12 1847 for James
Miller and Fleming
the East half of Section
19, S2, R15 as follows
Lot or Beginning at the
N W corner of said Section
and run S1W W 136 poles
to a Stake in Center of
County road (W Oak or 88 $\frac{1}{4}$
E 3 poles 11 links) then
88 $\frac{1}{4}$ W 162 $\frac{1}{4}$ poles to a
stake (Jack Oak 4 DD, or
2 E, 31 links, and Jack Oak
6 DD, 566 E 36 links) then

w 11 $\frac{1}{2}$ E 10 $\frac{1}{4}$ poles to stake in Greenville
brick line (W Oak 1/2 DD 528 $\frac{1}{2}$ E 28 links)
then w 80 E 164 poles to the Beginning
Containing 120 acres

Lot No 2, Beginning at the South East
corner of said Section (W Oak 1/2 DD S1W
1/2 links, and W Oak, 6 3/4 DD or 6 1/2 E 31 links)

#3 This last tree down but stump from a line run
w 88 $\frac{1}{4}$ W 162 $\frac{1}{4}$ poles to Stake (W Oak, 18 DD
or 6 1/2 E 37 links) then w 11 E 160 poles to
a Stake (Jack Oak 1 1/2 DD, N 2 E 3 1/2 links
and Jack Oak 6 DD, 566 E 36 links then S
88 $\frac{1}{4}$ E 162 $\frac{1}{4}$ poles to Stake in County
road (W Oak 18 DD or 88 $\frac{1}{4}$ E 3 poles 11 links)
then with said road 3 1/2 E 160 poles to the


Beginning Containing 162 $\frac{1}{4}$ Acres

Elias Thompson
Saml Stewart Jr.

A. Harrison
C. S. Yeo & Co

8533

Survey
596

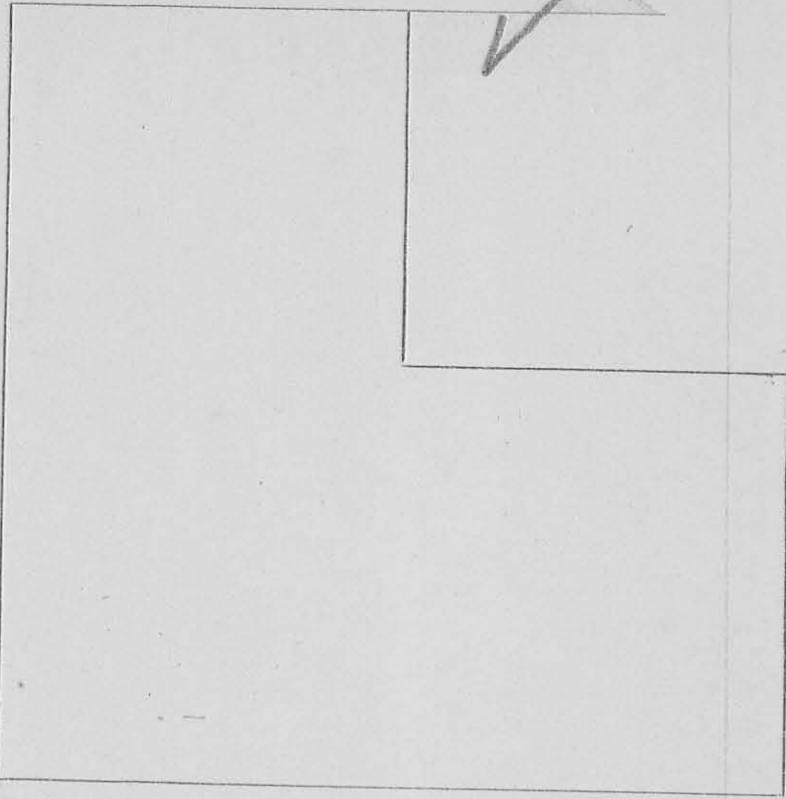

Surveyed Sept 1st 1847 for Robt Patterson
 Administrator of A C Spencers Estate a part
 of the 1/8 of Sect 15, 23, R 14, as follows
 Beginning at a stone in Sect line 80 poles or 88 $\frac{1}{4}$
 W from NW corner of said Section, and run
 N 88 $\frac{1}{4}$ W 16 $\frac{3}{4}$ poles to a stake (Hickory 14 D
 S 35 W 10 links, W Oak 12 D, S 75 E, 35 links)
 Then S 1 $\frac{1}{4}$ W 18 $\frac{1}{4}$ poles to a stake (W Oak 20 D,
 S 1 $\frac{1}{4}$ W 5 links) then S 88 $\frac{1}{4}$ E 95 poles to
 West edge of prairie, 16 $\frac{3}{4}$ poles to stake
 in prairie then N 88 $\frac{1}{4}$ W 64 poles to West
 edge of prairie 86 poles to a stake in field
 then N 88 $\frac{1}{4}$ E 72 poles to the Beginning con-
 taining 125 45 acres

J D Klein
A Bassett

A Harrison
C S Yeo Co

92

(8534)

Survey
5-97

✓

Surveyed Sept 5th 1827 for John Kauthman
Surveyor 9888. As follows;
Beginning at a Blue Oak, sugar tree and Elm
(Elm gone) in Greenville trcy-line At the South
East corner of Jamisons land corners Survey 9887
One run with said trcy-line or 80 E crossing
one branch at 30 poles One at 106 poles and
One at 178 poles 380 poles to 2 Buck (lost
one) then or 10° W 106 poles to branch 191 poles
to Mill Creek, 340 poles to Spring branch
100 poles to Stan then, S 80° W 100 poles
to the two sugar trees and a buck or
corner of said Jamisons Survey then
S E 450 poles to the Beginning
containing 936 7/10 acres
J Kauthman 3 Cm M Hartman
Geo Kauthman 3 Cm

Survey
598

✓
8535

93

Surveyed Sept 9th 1847 for Smith and Robert Edmiston a part of Survey No 9902, as follows:
Lot No 1 Beginning at a Stake in R Edmiston's East line and run N 80 E cross Cherokee road at 27 poles & 3 poles to a stake then S 10 E 200 1/4 poles to a Stake in Lenistown road then S 80 W 43 poles to a Stake then S 10 W 200 1/4 poles to the Beginning Containing 53 95/100 Acres
Lot No 2, Beginning at a Hickory, Dogwood and Ironwood (Dog-wood, Iron-wood, and some) then S 11 E 56 poles to Cherokee Creek, 200 1/2 poles Stake in Lenistown road then with said road S 80 W 88 1/4 poles to a Stake then S 10 W 201 poles to a Stake in S 80 W 1/2 line of said survey then with said survey S 80 W 87 poles to the Beginning Containing 110 1/200 Acres

A. H. Hartison
C. S. Geer C.


✓
 94 Surveyed Jan. 8th 1848 for John Quinn
 of Rushcreek Township L. County Ohio
 (8536) part of Military Survey N. 9976 as
 follows to wit Beginning at an ash
 and Beech (Ash down) Hence S 18°
 100 P. & 6 links to two sugars and Beech
 (all down). Hence S 79° E. 60 P. to W. Oak
 48 inches Diameter West 3° links. Hence
 S 11° W. 100 P. 6 links to a crossing E. Br.
 Survey of Miami river at 20 poles. To a stake
 N 59° E. Hence S 79° E. 60 poles to the beginning
 containing 37.50 Acre

O Hayes Ld. L. Ohio

J. S. Hull
 Peter Powers Chas. Cris.
 Michael Quinn Marker.

True Mer.

Scale 20 P. to an I. "

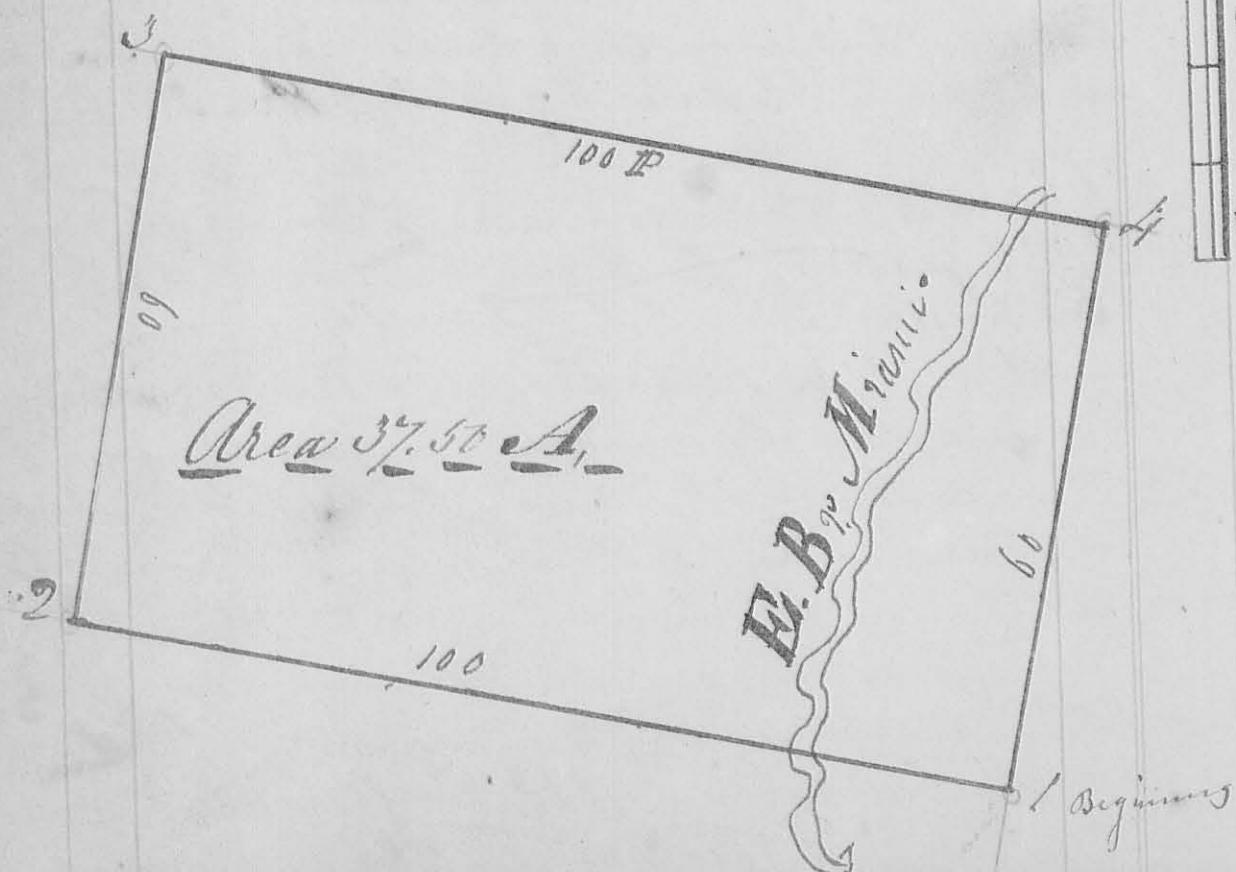

8536

95


Surveyed Jan'y 8th 1848 for Charles Quinn
 part of Military Survey No 9976 on the
 waters of the S. G. Miami in Russcock Twp.
 Logan County Ohio as follows "to wit"
 Beginning at a ~~*~~ Buck Stump Southwrd.
 thence SW^oEⁿ 101.75 Poles Beech 16 ft. diam 486 m
 48 Links dist. thence N 79° E. 139 P. N. Oak 18
 in. diam. West 37 $\frac{1}{2}$ thence N 11 W. 26 Poles Stake
 thence S 79° W. 73 Poles Stake in field
 thence N 20 P. W. 76 Poles Sugar 16 in. diam.
 N 37 $\frac{1}{2}$ E. 30 Links thence S 79° W. 55 poles
 to beginning containing 50.30 Acre.

S. Hull
 Peter Powers Ch. Cars.
 Michl Quinn Marker.

O. Hayes C. L. C. Ohio

True Mer.

Survey
 No 600

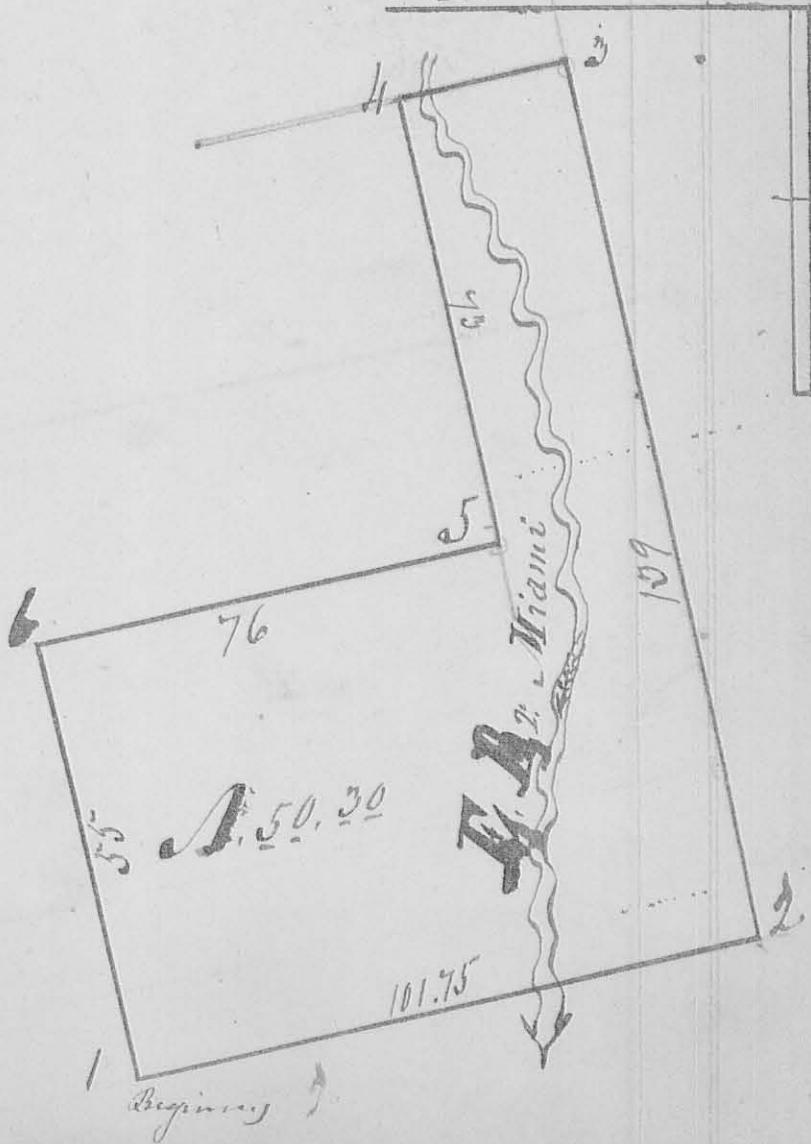

Scale 30 P. to an I.

96

8537

Surveyed January 17th 1848 for Ephraim
Murdell of Rush Creek Twp Logan County
on the plat of Rush Creek - part of
Military Survey N. 13. 446 as follows
to wit. Beginning at a stake in the
road leading from the town of Rush-
sylvania to Harrison County line
thence S. 12 W. 203 poles to a Hickory,
Sugar and Elm. thence S. 78 E. 113 poles to
three Beechys and a Sugar. S. E. corner
thence S. 11 E. 282 poles to Ironwood & Hickory
~~(Hickory down)~~ thence S. 78 W. 106 poles to
the beginning containing One hundred
and thirty eight acres two rods and
thirteen perches (138 A. 2 R. 13 P.) -

James Morrow
John Rawling Jr. et al.

C. Gray Sur. L. C. Ohio

1^o 602

97

838

Surveyed for Wm Pollock of Rich
land Twp. Logan county Ohio on the
20th day of July 1848 part of Military Survey
S. 99 72 on the waters of the Miami as
follows to wit; Beginning in the east
line of said Survey at 2 Sugar trees and
Buckeye & Sugar & Buckeye大道 N 8 E corner
to Lemuel Lysley 10 acres thence S 78 W
151.5 poles - Beech thence S 12 E 104.7 poles
to a Stake and 2 Beeches in the south line
of said Survey. Thence S 79 W 68.7 poles
to an Ash and Spruce, thence S 12 W
139 poles to 2 Hickories. Thence S 78 E 103.5
poles to an Elm Ash & Bopelder thence S 12 W
130.75 poles to a Stake 6 feet from E. bank
of tail race of Pollock and Johnson's mill
thence S 78 E (up said race) 24 poles to a Stake
thence S 80 E 6 poles to an Elm, thence S 80 E
22 poles to a Blackberry thence S 24 E 8 poles
to a white Ash thence S 42 1/4 E. 8.75 poles
to a Maple. thence S 50 1/2 E. 24 poles to an
Elm. thence S 72 E 40.5 poles to an Elm
thence S 91 1/2 W 4 poles to a Birch Oak & Elm
thence S 58 1/2 E 23 poles to a Stake thence
S 11 E 70.75 poles to the Beginning containing
One hundred and Seventy nine acres and a
half more or less

Miles J. Chas
J. Johnston Chas

Note In the above survey
I did not run round the
whole tract. Mr Pollock only
wanted one line run which
I did therefore I say "more or
less" and do not consider myself bound as to the
accuracy of the survey except the one line. The other
Bearings and distances were given me by Mr. P. G.

O. Hayes Sec. S. Co.

✓

N^o. 603. Surveyed Jan'y 22nd 1848
 for William Henry Adams of
 the estate of Isaac Rea Jr. dec'd. late
 of Perry Twp. L. County Ohio part of Military
 Survey N^o. 6232 on the waters of Miller's
 as follows to wit Beginning at a lym
 stump and stake thence S 5 M 38 poles to
 an Elm. thence S 38 E 237 poles to a sugar
 and two ironwoods. thence S 52 E
 63 poles to a planted stone thence N 15 M
 17.24 poles to a planted stone thence N 83 M
 15.0.5 poles to the Beginning containing
 15.0 acres Also subdivided said tract be-
 tween Sam'l V. Costin Job Smith and Geo'r.
 Sudduth as follows gave Costin fifty
 acres off the North end of said tract boun-
 ed South by a line parallel with the
 North line and divided the balance
 between Smith and Sudduth by running
 a line along the centre of the Bellfontaine
 and Franklin Turnpike for
 plat and notes see next pages 99 &
 101

Levi Seaman
 Mrs More (More) Ch. C. S.

O. Hayes Sur. \$60

99

Cottins beginning at the N.W. corner of said tract at a Sycamore and Beech (both down but stump of Sycamore still there) thence S 57 W. 38 poles to an Elm thence S 38 E 25 poles to a Stake. thence S 83 E 154 poles to a Stake thence N 15 W 57.0 poles to a planted stone thence N 83 W 150.5 poles to the beginning containing fifty acres.

Job Smith described as follows -

Beginning at Cottins S.W. corner at a Stake thence S 38 E 101.5 poles to a Stake in the centre of the Bellfontaine and Franklinton Free Turnpike thence along the centre of said road N 67 1/2 E 104 poles to a Stake thence N 15 W 25.0 poles to a stone (planted) thence N 83 W 154.5 poles to the beginning containing ~~45.000~~ ^{43.000 and 120 rods} ~~45.000~~ acres.

Geo. W. Suddethis is described as follows Beginning at Smiths S.E. corner at the Stake in the aforesaid Bellfontaine and Franklinton Free Turnpike thence S 38 E 112.6 poles to a Sugar and 2 Ironwoods then N 57 E 63 poles to a stone (planted) and small Beech. thence N 15 W 48 poles to a Stake in the centre of the aforementioned Free Turnpike thence along the centre of said Free Turnpike S 67 1/2 W 104 poles to the beginning corner containing 51.84 acres - for Plat and so forth see page 101 -

100

(8540)

No. 604. Surveyed Feby 5th 1848 for
Isaac N. McBeth 40 acres in the
South side of the N. R. gr. of Sect. 35 T 5 Range
13 M.R.S. also 32 Acres and 88 perches off the
the North side of the S. E. gr. of Sect. 34 T 5
R. 13 M.R.S. as follows "to wit" beginning
at the N. W. corner of said 40 acre lot
thence $S 89\frac{1}{2}^{\circ} E$ 178 poles to a stone in the
Springfield and Sandusky Free Turnpike
thence $S \frac{1}{2} N$ 38 poles to a stone at the
corner of sections 28, 29, 34 and 35, thence
 $S 66\frac{1}{2}^{\circ} W$ 93 poles to a stone on the centre
of the State road leading from West
Liberty to Quincy thence following the centre
of said Road $N 84\frac{1}{2}^{\circ} W$ 91.5 poles to a stone
thence $N 7\frac{1}{2}^{\circ} E$ 78 $\frac{1}{2}$ poles to a stone at
the Beginning containing Seventy two
acres and 88 perches

J. N. McBeth
Wm. McBeth Sch. no.

O. Hayes Sur. L.C.