

corner tree, and the root of a medium sized Sugar tree, which sd. Thornton told me was one of the corner trees; here I marked a Sugar 12 In. Dis. thus 'X' bearing S. 64° E. 42 links from said stone, another Sugar 13 In. Dis. N.
14° E. 38 links; and a Pidgeon Oak 4 In.
Dis. N. 85° W. 37 links; Thence with the line
between Surveyors 103, 9892 & 9893 S. 10° E. 117
Poles to an Ash Sapling 2 In. Dis., at the
N. W. corner of Mr. Furrow's land, by the
side of which I planted a lime stone
marked '+', and from which I marked a white
maple 15 In. Dis. bearing S. 11° E. 18 links, &
a Sour Elm 18 In. Dis. N. 3° E. 22 links;
Thence N. 77 $\frac{1}{2}$ ° E. 44 $\frac{1}{2}$ Poles to a lime stone
marked '+', at William Furrow's N. E. corner,
which was established at this point before
me on the said 26th day of Oct. A.D. 1858;
by the mutual agreement of the said
Charles H. Thornton, Job Wickersham,
and William Furrow, from which I
marked a Black Ash 13 In. Dis. bearing S.
77 $\frac{1}{2}$ ° W. 28 links; Thence S. 9 $\frac{1}{2}$ ° E. 29 Poles
to a lime stone marked '+' John Furrow
N. W. corner in Mr. Furrow's East line, from
which a Lynn 26 In. Dis. bears N. 52° E.
43 links; Thence N. 77 $\frac{1}{2}$ ° E. 44 Poles to an
Ironwood 4 In. Dis. (by the side of which is
a lime stone marked '+') at John Furrow,
N. E. corner, & from which I marked a
Beech 19 In. Dis. bearing S. 84 $\frac{1}{2}$ ° E. 10 links;
Thence S. 11 $\frac{1}{2}$ ° E. 81 $\frac{1}{2}$ Poles to the centre
of a Sour Elm 30 In. Dis., and S. E. corner
to the land sold to John Furrow by
Charles H. Thornton; Thence S. 10° & 20° E.
(crossing Boke creek at 12 $\frac{1}{2}$ Poles) 108

Poles to a lime stone marked '+' which I planted at the S. E. corner of Harriet Murray's land, from which I marked a Sugar 5 In. Dir. bearing N. $17\frac{1}{4}$ E. 8 $\frac{1}{2}$ links, & a Sugar 7 In Dir. $17\frac{1}{2}$ M. 50 links; Thence S. 81° W. $89\frac{2}{10}$ poles to a lime stone marked '+' which I planted in a large hollow Hickory stump in the West line of said Survey No. 989 $\frac{1}{2}$, and at the S. W. corner of the said Harriet Murray's land, from which I marked an Ironwood 8 In. Dir. bearing S. 80° W. 10 links, and a Beech 16 $\frac{1}{2}$ In. S. 23° W. 23 links. Thence S. $9\frac{3}{4}$ E. 100 $\frac{1}{2}$ Poles with the West line of said Survey to the place of beginning.

Containing three hundred & eighty two acres and eighty eight hundredths of an acre, ($382\frac{88}{100}$ acres) ---

All the aforesigned witness, and corner trees are marked thus 'X', cut with an ax in the side facing the corner, except the large Elm at John Turnour's S. E. corner, which is not thus marked.


Job Wickersham }
Charles H. Thornton } agreement
chain men, by mutual
I do hereby certify that the foregoing
plat and report of Survey, are correct.

Henry C. Moore, County Surveyor
of Logan County Ohio

328

Survey No. 781

~~8225~~
8223

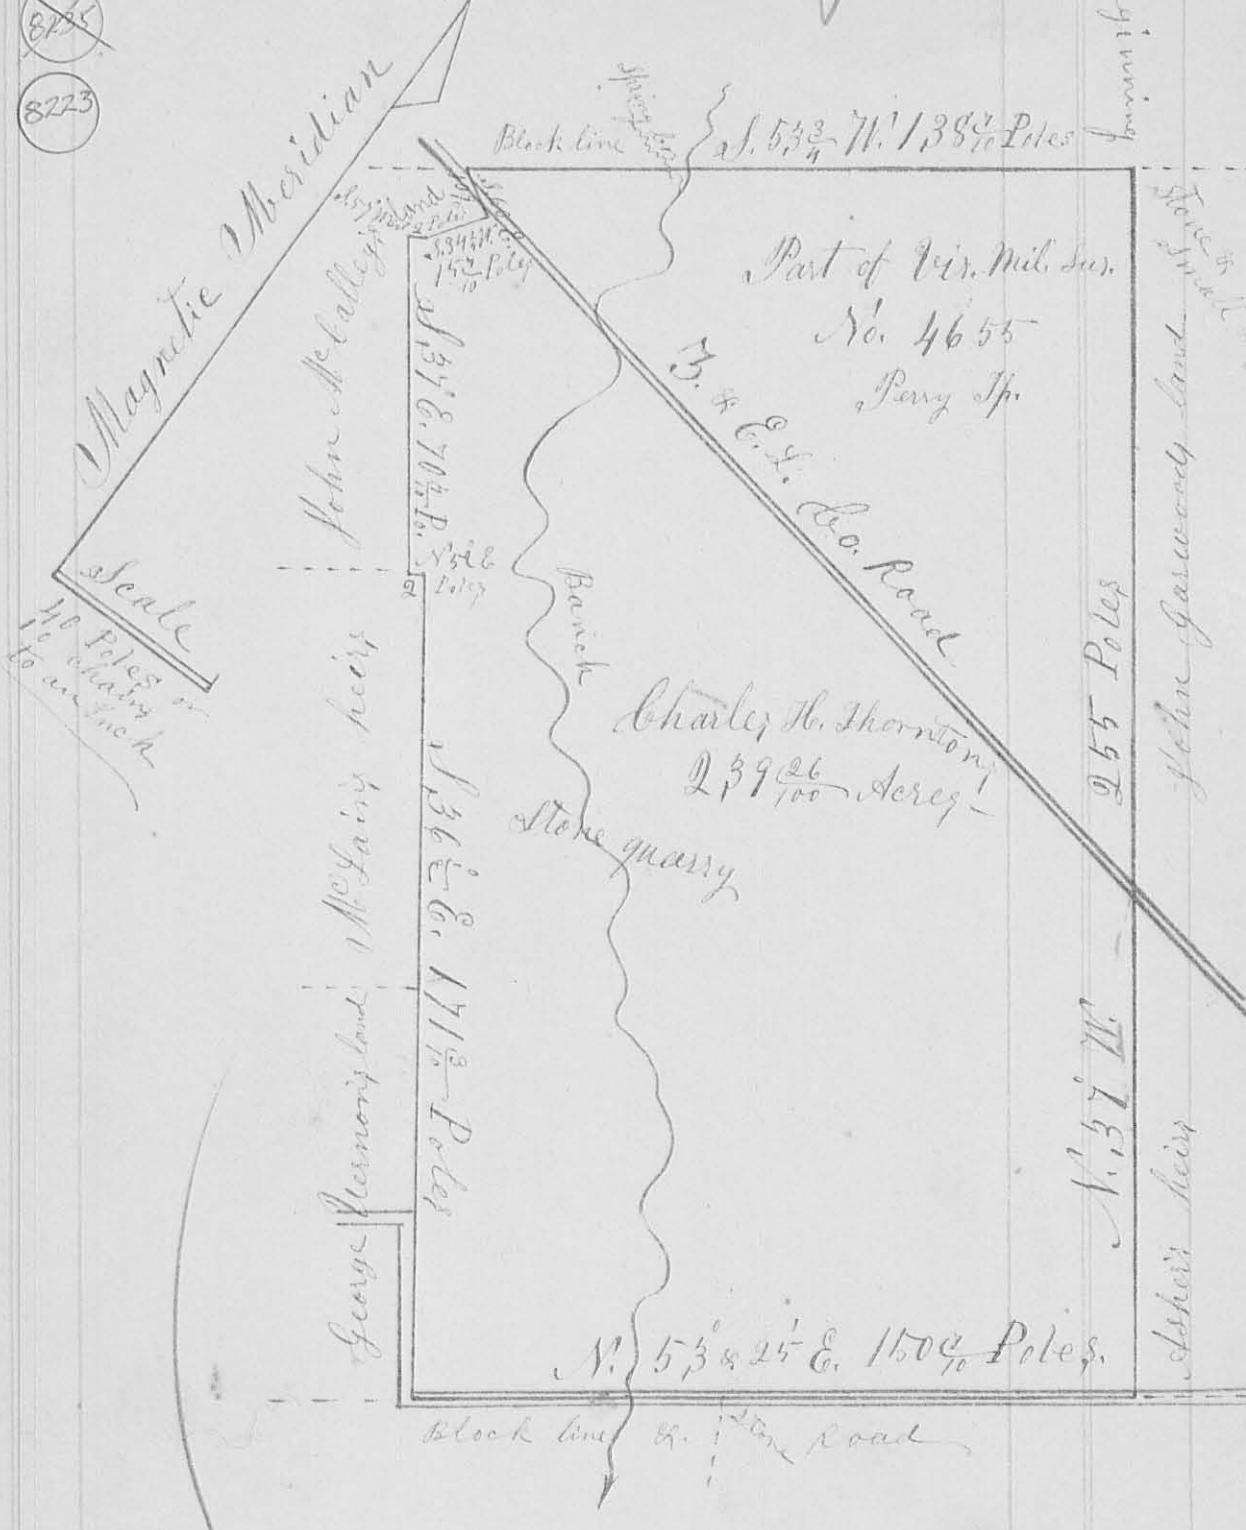

Surveyor's Office, Bellefontaine, O.
Nov. 11th A. D. 1858

The above plat is a representation of 239 $\frac{1}{100}$ acres of land, being a part of Virginia Military Survey No. 4655, in the name of the Representatives of Leaelling Jones, and and in Perry Township of Logan County Ohio.

As Surveyed by me, H. C. Moore, the 3rd
County Surveyor of said County of Logan,
on the 28th & 29th days of October A.D. 1858.
at the request of John Wickersham, of
Boke creek Township of sd. County of Logan
for the purpose of establishing the lines,
and corners thereof, and ascertaining the
number of acres contained therein; which
I did in the following manner; to wit;

Beginning at a stone in the North
line of said Survey, and at the N.W.
corner of John Gorwood's land, (in the
same survey,) from which a Sugar tree 6 In.
Dir. bears S. 50° E. two links distant,
run thence with the North line of said
Survey, S 53³/₄ W. 138³/₄ Poles, crossing a
branch at 93 Poles, & a spring branch at
109 Poles, to a stone at the North
side of a road leading from Banesfield
to East Liberty, from which a lime
stone bears N. 60° W. 11 links. Thence S. 60 E.
10¹/₂ Poles, crossing laid road, (at very acute
angle,) to a rock stone, near the South
side of said road, from which a
Walnut tree 12 In. Dir. bears N. 54¹/₂ W.
33 links; Thence S. 34¹/₂ W. 15¹/₂ poles to
a rock stone, from which a Beech
22 In. Dir. bears S. 13¹/₂ E. 8 links; Thence
S. 59 W. two poles to a rock stone from
which said Beech 22 In. Dir. bears S. 61¹/₂
47 links; Thence S. 37 E., with the East
line of John McCalley's land 70¹/₂ Poles
to a rock stone, from which a Walnut
tree 6 In. Dir. bears S. 81¹/₂ W. 64 links,
Thence N. 52° E. two Poles to a stone,
Thence S. 36¹/₂ E., with the East line of the land,

The original of this page is blank or missing.

owned by John Mc Lain's heirs, and George Vernon, 171 $\frac{1}{2}$ Poles, (passing the corner with said said heirs & Vernon. at 86 poles) to a Stone in the angle of a road, at said Vernon's S. W. corner, and in the south line of said Survey, from which a line 18 $\frac{1}{2}$ Lir. bears S. 4° E. 26 links; Thence with laid road & south line of survey, N 53 $\frac{1}{4}$ 25° E. 150 $\frac{1}{2}$ Poles, (crossing a branch at 44 $\frac{1}{2}$ poles, and passing a stone at the corner between Austin's heirs at 64 $\frac{1}{2}$ pole to a stone in said road, & Survey line at the Widow Howes S. W. corner, from which a stone bears N. 38° W. 50 link, thence N. 38° W. with the west line of said Widow Howes, and John Garwood's Land, 255 poles, (crossing said road leading from Zanesfield to East Liberty at 105 poles,) to the place of beginning
Containing Two-Hundred & Thirty nine acres, and twenty six hundredths of an acre = (239. $\frac{26}{100}$ acres)

All the afore named witness trees are marked thus, 'X' cut in the side facing the corner

Charles H. Thornton,
Job Mckersham, C. C. by mutual agreement


I hereby certify that the foregoing plat and report are correct.

Henry C. Moore, County Surv.
of Logan County Ohio

Survey No 786

(8635)

Magnetic Meridian

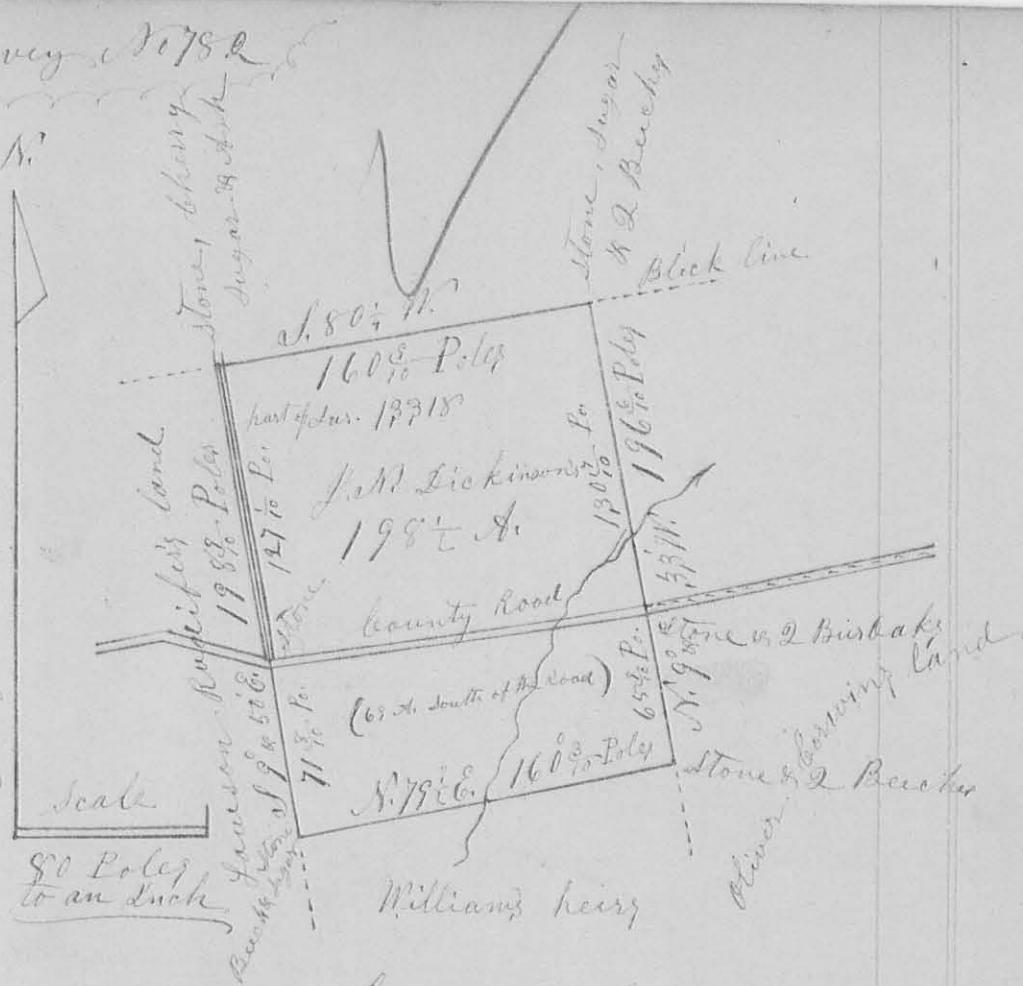

332

Survey Office Bellefontaine O.

November 11th A.D. 1858

The above plat is a representation of 198 1/2 acres of land in Rushcreek & Bokes Creek Townships of Logan Co. Ohio, being a part of Virginia Military Survey No. 13318, in the name of Ibeziah Starbuck, as surveyed by me, H. C. Moore, the County Surveyor of said County of Logan, on the 2^d 8th day of November A. D. 1858, at the request of Joseph N. Dickinson, of Bokes Creek Township of said County, for the purpose of establishing the lines and corners thereof and ascertaining the number of acres contained therein; which I did in the following manner: to wit: Beginning at a stone, which I planted in the North line of said Survey, at Lawson Rudiford's N.E. corner (in said survey) from which I marked a sugar tree (thus "X") 4 ln. dia bearing S. 12° W.

12 links, a Cherry 6 In. Dir. S. $14^{\circ} W.$ 16 $\frac{1}{2}$ links
 and an Ash 12 In. Dir. S. $53^{\circ} E.$ 25 $\frac{1}{2}$ links
 distant; Run thence S. $9^{\circ} \& 50' E.$ with
 said Rudifer's East line, 19 $8\frac{1}{2}$ Poles,
 (passing 4 old line trees in the first 50
 Rods, and a Stone in the centre of a
 County road at 12 $7\frac{1}{2}$ Poles,) to a stone
 which I planted in said Rudifer's E. line
 at the N. W. corner of Mr. William's heirs,
 from which I marked a Beech 20 In. Dir.
 bearing S. $80^{\circ} W.$ 6 links; & a Sugar 17 In.
 Dir. S. $77\frac{1}{2} E.$ 28 links distant, Thence N. $79\frac{1}{2} E.$
 16 $0\frac{1}{2}$ Poles, (crossing Boke Creek at 80 poles)
 to a stone which I planted in Oliver
 Borwin's West line, from which I marked
 a Beech 10 In. Dir. bearing S. $70^{\circ} E.$ 12 $\frac{1}{2}$ links,
 and a Beech 12 In. Dir. S. $7 W.$ 89 links;
 Thence N. $9^{\circ} \& 33' W.$, 65 $\frac{3}{4}$ Poles, (passing the
 centre of a Black Walnut tree 4 feet in diam.
 at $7\frac{1}{2}$ chains) to a stone which I planted
 in the middle of a County Road, at said
 Oliver Borwin's N. W. corner, from which
 I marked a Bur Oak 2 $\frac{1}{2}$ In. Dir. S. $70^{\circ} W.$ 16 links,
 & a Bur Oak 8 In. Dir. S. $1\frac{1}{2} W.$ 50 $\frac{1}{2}$ links,
 Thence with the same bearing, (N. $9^{\circ} \& 33' W.$)
 crossing Boke Creek at 28 $\frac{1}{2}$ poles, (or 95 $\frac{1}{4}$ poles
 from the S. E. corner,) 13 $0\frac{1}{2}$ Poles, (or 196 $\frac{1}{2}$ poles
 from the S. E. corner,) to a stone which
 I planted in the N. line of said Survey,
 from which I marked a Sugar tree 28 In.
 Dir. S. $47^{\circ} W.$ 11 links, a Beech 13 In. Dir.
 S. $74^{\circ} W.$ 13 links, & a Beech 12 In. Dir. N.
 $80^{\circ} E.$ 14 links; Thence S. $80\frac{1}{2} W.$ with the
 N. line of the said Survey 16 $0\frac{1}{2}$ Poles to
 the place of beginning, containing

One Hundred & Ninety eight acres, and one
half of an acre = (198 $\frac{1}{2}$ acres) — — — — —

All of the afore named corner stones are
marked with a notch in the top, & the
witness trees thus 'X' cut in the side
facing the ~~the~~ corner, — — — — —

Done in presence of,

Joseph N. Dickinson
Lawson Rudifer
Oliver Corwin
Christopher Cline
& James Jordan


Christopher Cline }
James Jordan } Chain Men — —
I hereby certify that the fore-
going plat & Report are correct. — —

Henry C. Moore,
County Surveyor of Logan Co., O.

375

863b

Aug. 1st 1853.

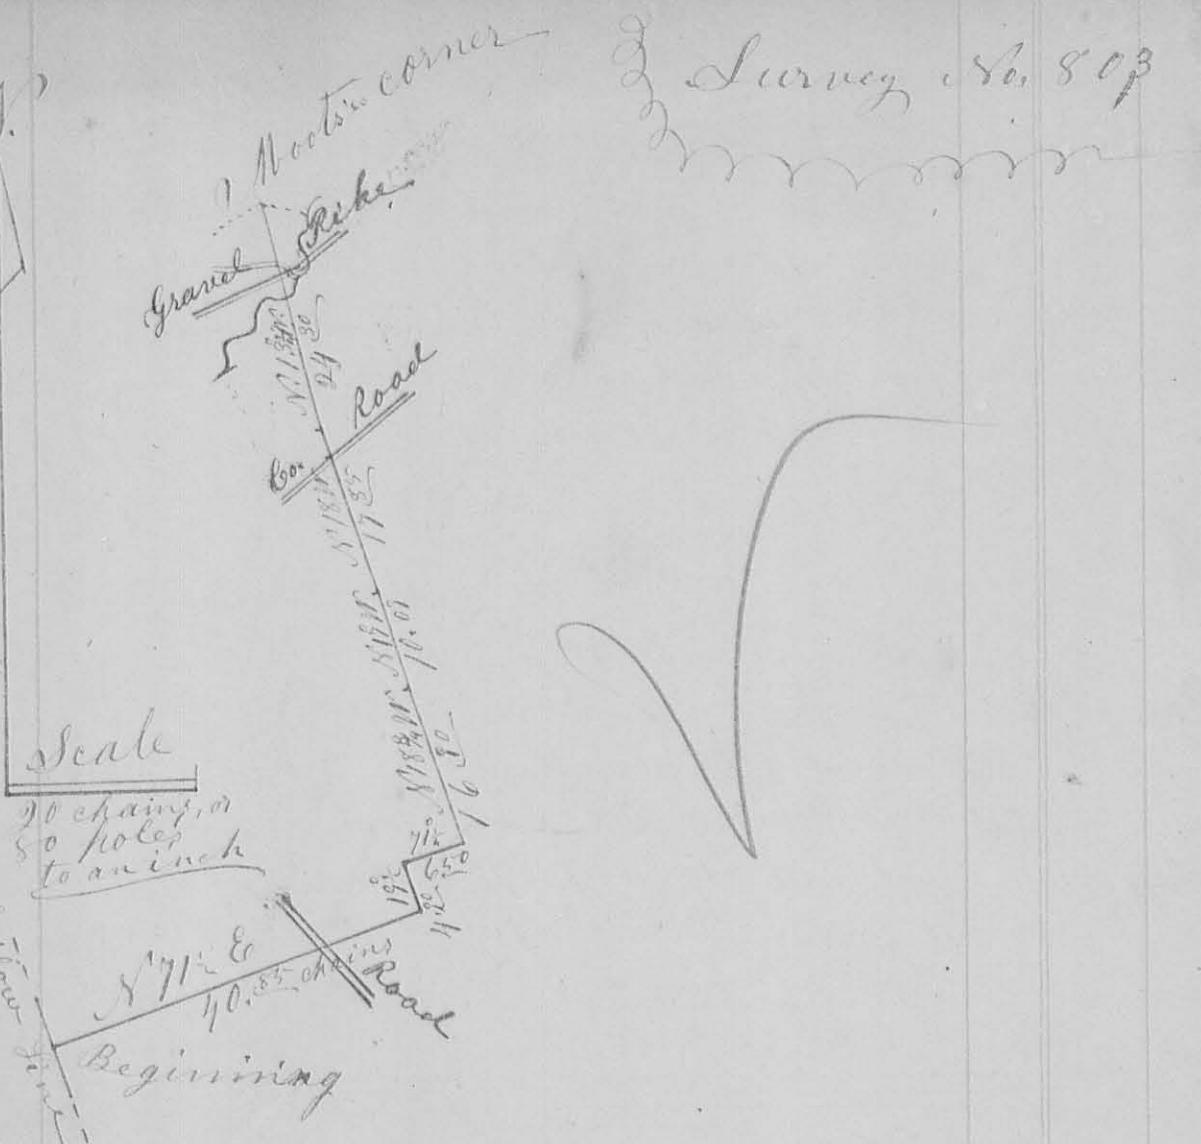

Surveyor's Office Bellefontaine Ohio

December 6th A.D. 1853

The above plat is a representation of seven lines of A. Sanderson, Piatt, land, in Monroe Township of Logan County, State of Ohio; being on the water of Mackeechack in said lots Survey Nos. 4492 and 4479, as surveyed by me, H. C. Moore, the County Surveyor of the said County of Logan, on the 26 day of November A.D. 1853, at the request of said A. Sanderson, Piatt, for the purpose of establishing said lines, and the corners therewith connected which I did in the following

manner; to wit:

Beginning at a small stake & small stone in the Ludlow line, at Adam Miller's N. W. corner, run thence N. $71\frac{1}{2}$ E. $40\frac{84}{100}$ chains (or = 163 $\frac{1}{4}$ rods) crossing a road at 30 25 . chains; to a stone, from which a Cherry 17 in. Dis. bears S. $56\frac{1}{4}$ W. 20 links;

Thence N. $19\frac{1}{2}$ W. 4.20 chains to a Black Walnut stump; thence S. $71\frac{1}{2}$ E. 6.50 chains to a stone, from which a Hickory 18 in. Dis. bears N. 34 W. 4 links & a Hickory 9 in. Dis. S. 34 E. 5 links; thence N. $18\frac{3}{4}$ W. 16.00 chains to a stone; thence N. $17\frac{1}{4}$ W. 10.09 chains to a stone, from which a red oak 30 in. Dis. bears N. 41 W. 15 links; thence N. $18\frac{1}{4}$ W. 17.85 chains to a stone passing a stone in a do. road at 15.05 chains; thence N. $13\frac{1}{4}$ W. passing a stone at Lewis Seaman's corner at 11 $\frac{24}{100}$ chains; crossing Mackachack at 14 $\frac{40}{100}$ chains; crossing the Gravel pike; and crossing Piatt's mill race at 18 chains to a stone at Woods' corner, from which a Bur Oak 14 in. Dis. bears S. 15° E. 13 links, and a Hollow Hickory 20 in. Dis. S. $15\frac{1}{2}$ E. 13 links -- -- --

Done in presence of, A. Sanders, Piatt, Lewis Seaman

and Henry Foresy the $\frac{1}{2}$

Peter King } chain men
I hereby certify the foregoing plat
and report to be correct --

Henry C. Moore Co. Surveyor Llo. Co.