

original corner trees are destroyed, thence between Sec's 22 & 28 and E 32 $\frac{1}{4}$ poles to the corner of Sec 22, Ds. 28 & 29, a hickory 524 ft 22 links original bearing tree standing, the other is down, & marked a hickory, cr 76 W 21 links — thence between Sec's 28 & 29 18 $\frac{1}{4}$ N W 32 $\frac{1}{4}$ poles crossed a road at 44 poles, to corner of Sec 28, 29, 34 & 35 — the original corner trees are cut down, — thence between Sec's 28 & 34 (crossed the road at 102 poles, a branch at 108) 3 38 poles to the beginning containing 65 acres —

The 1st

division line begins at a stake in the west line 165 poles from either corner thence 5 89 $\frac{3}{4}$ E 32 $\frac{1}{4}$ poles to the east line, a hickory 5 86 N 6 links —

stake	cr 89 $\frac{3}{4}$ N 32 $\frac{1}{4}$	n white oak	o hickory
M. George	98 $\frac{3}{4}$ ac.	Gunning	
3		81 $\frac{1}{4}$ ac.	
road		81 $\frac{1}{4}$ ac.	
M. George		81 $\frac{1}{4}$ ac.	
1 st	133 $\frac{1}{4}$ A	81 $\frac{1}{4}$ ac.	
sec		81 $\frac{1}{4}$ ac.	
stake		81 $\frac{1}{4}$ ac.	
Wadlow	Toddler	Coull	
165 $\frac{1}{4}$ L		81 $\frac{1}{4}$ ac.	
	81 $\frac{1}{4}$ ac.		
	81 $\frac{1}{4}$ ac.		
			stone

East 32 $\frac{1}{4}$ N hickory

Beginning
The 2nd division

line begins 80 poles west of the south east corner of the sec. a hickory cr 295 E 10 links do 5 66 N 26 links thence cr 16 162 poles a stake in a pond an elm cr 61 E 64 links do cr 22 E 51 links, continued 32 $\frac{1}{4}$ to the north line. a white oak cr 73 W 18 links do 68 E 18 links

The 3^d line begins on the 2nd line 60 poles south of the last named corner a white oak cr 45 E 12 links do cr 36 N 12 links thence cr 89 $\frac{3}{4}$ N 202 poles to a stake in the west line of the sec.

The 4th line begins at the original go sec. corner in the south 161 poles from either corner thence cr 18 164 poles to a white oak cr 53 E 13 links do 5 276 18 links the centre of the sec.
Nathan & John. George J. G. S. G. Willman
G. S. Lee

152

Jth mo. Sept, 22nd 1832 Survey no 192

152

John
Taylor
et al.

8276

Surveyed 50 acres of land for John Taylor
 Beginning at the S.E. corner of section 30 T 5 R 13
 M.L.S. a black oak 127 ft 50 links. a white oak 113 ft
 18 links. thence N 9 W with the line between sec.
 29 & 30 164 poles to the goth cor. a white oak 173 ft
 15 links - thence N 7 E 47.2 poles. a hickory 187 ft 18
 links - thence S 89 E 164 poles to a stake in the
 east line of the section. thence with said line
 S 1 1/2 W 49.2 poles to the
 beginning containing
 50 acres off the south side
 of the S.E. gr. of said sec.
 John Will
 Richard Ainsdale } 66

50 A	47.2
------	------

 Beginning

St. M. Sherman 165

J. Jones

J. Pollock

Geo. Canmins

G. Shaw

Wm Proctor

9th Mo. Sept, 25th 1832 Survey no 191

Surveyed and divided section 29 T 4 R 13 M.L.S.
 as hereafter described for Jonathan Jones James
 Pollock George Canmins & William Proctor
 Beginning at the corner of sec 29 & 30, 85 ft S 6
 in said S.E. original bearing tree standing a hick
 ovy 8 inches diam. N 70 E 14 links a white oak 112 ft
 33 links. thence between sec 29 & 30 189 ft E, leav
 ing a branch at 86 poles, passed the original goth cor.
 at 160 poles a W. Oak 120 ft 8 links dist a W. Oak 187 ft
 18 links Beginning 60
 320 poles

found no
 cor. but at
 the intersection
 of the original
 lines I marked
 a black oak
 c 7 ft 8 links
 a black oak
 N 72 E 21 links

86 th A.	Geo. Canmins		
86 th A.	G. Shaw	86 th A.	
86 th A.		86 th A.	86 th A.
173 ft	J. Jones	86 th A.	86 th A.
		J. Pollock	W. Proctor

thence with the original line between sect 23 and 29 SW
34 poles to the corner between Sect 22, 23, 25 & 29 one of
the original bearing trees standing a hickory 614 ft 22 links
the other a hickory is down. Thence between section 25 & 29
SW NW 320 poles to the corner of sect 28 29 34 & 35 - the
old corner trees are all destroyed here - thence between
sects 29 & 35 & 16 346 poles to the beginning containing
618 acres - The 1st division line begins at a stake in the
north line, a bur oak 738 ft 18 links on line NW NW 24 links
thence SW 173 poles to a stake in a cornfield -

^{per} The 2nd division line begins at the gr. sec. corner be-
tween Sect 29 & 35 173 poles from either corner a hick-
ory 640 ft 12 links, a hickory 787 ft 12 links - thence S 98 E
160 poles a hickory 771 ft 17 links a hickory 583 ft 29 links
in the center of the section. Continued 160 poles
further to the gr. sec. corner between 23 & 29 a red oak about
4 links a black walnut 68 ft 2 links -

The 3rd division line begins at the gr. sec. corner between Sects.
28 & 29 160 poles from either corner a white oak 723 ft 18
links - thence N 1° E 173 poles to the center corner -
The 4th line begins in the line line between Sect 28 & 29
80 poles from the SE corner of the sec. a red oak 775 ft 18
links a white oak 768 ft 18 links - thence N 1° E 173 poles
to a black oak 730 ft 7 links a hick 538 ft 12 links in the
line through the centre of the sec -

Lemuel Pollock } 66 - J. W. Morrison 65 1/2
George Shaw } 66 -

Wm. gmo. Sept 26 1832 Surveyor 1926
 L. Pollock } 0178 Surveyed and divided the tenth half of
 Robt Clark } Sec. 24 & R. W. M. for Layton Pollock & Robert
 Clark as follows viz: Beginning at the
 gr. sec. corner between Sect 18 & 24 original bearing
 tree yet standing a red oak 720 ft 15 links - thence
 with the line between said sect. south 160 poles to
 the corner of Sects 17, 18, 23 & 24, original bearing trees
 standing a red oak 738 ft 13 links, a dogwood 785 ft 26
 links

(154)

(154) thence between 23 & 24 & $88\frac{1}{4}$ W 320 poles, crossing a
Spring branch, to the corner of 23, 24, 29, 30 a black
Pollock } oak $\frac{7}{16}$ E. 9 links a black oak $\frac{7}{16}$ E 21 links - thence
& Clark } N 139 poles to the gr. sec. corner between sec 24 & 30
a black oak $\frac{7}{16}$ W 12 links, a black oak north 28 links
thence $68\frac{1}{4}$ E 320 poles, crossing the spring branch to the be
gaining con
- taining 28 $\frac{1}{4}$
acres -

The division line

begins at a stake
in the south line

L. Pollock	R. Clark	beginning Rock & stone
14.8 Acres	14.2 Acres	
S. N. gr. S. h. Sec. 40 & 24 R. 13		wood & dry wood

Stake

of the sec. 160 poles from each corner & runs north 144 poles to
a stake in the north line of the half sec. in the prairie -
dividing the half sec. as above marked on the plat


James Pollock } J. C.
Robert Pittman } R. C.
Samuel Macumon } S. M.

11/193

Sam'l. Moore - 9th mo. 27, Sept., 1832 Survey No 193
Robt. Pittman ^{divided} Surveyed sec. 30. T. L. N. 13 M.R. for Samuel
Sue Macumon ⁸²⁷⁹ Moore, Robert Pittman, John Macumon & William
Wiley George ³ George as follows - Beginning at a stake in a prairie
the original of Secs 24 & 30 in T. L. N. thence $18\frac{1}{4}$ W with
the original line 320 poles to the corner of sec 30 & 36 a
stone in a prairie - thence 304 poles, passing the organ.
- al gr. sec. corner between sec 30 & 36 a bur oak $\frac{5}{16}$ E
29 links, a hickory

East 12 links at 16 $\frac{1}{4}$
poles) 304 poles to the
corner of Secs 29,
30, 35 & 36 original
bearing trees a hickory
 $\frac{7}{16}$ E 16 links, a white
oak $\frac{11}{16}$ W 33 links -

thence between 29 &
30 $58\frac{1}{4}$ E 320 poles
leaving the original

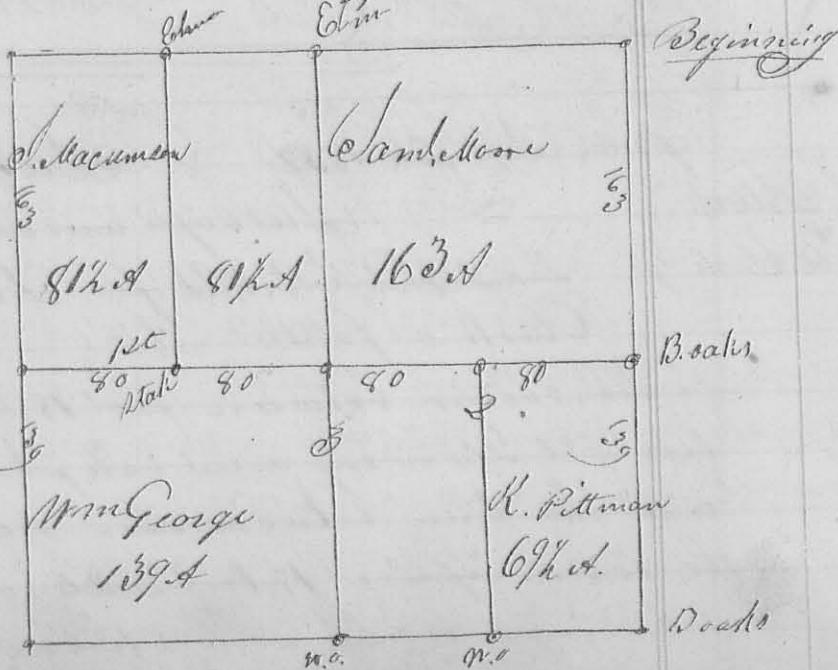

155

gr. sec. corner at 160 poles, a w. oak 470 W 8 links
a white oak 487 E 28 links) to the corner of Sect 23, 24 & 29
& 30 a black oak 411 E 9 links, a black oak 472 E 21 links
thence between Sect 24 & 30 north 304 poles (passing the
gr. sec. corner at 139 poles) to the beginning containing
608 acres -

1st.

The 1st division line begins at the original gr. sec.
corner in the line between Sect 29 & 30 - thence N 89 1/2 E at
80 poles set a stake in a prairie, at 160 poles set a stone in
a swamp at the centre of the sec., at 240 poles
set a stone on a hill side, 320 poles to the gr. sec. corner
between Sect 24 & 30 a black oak 476 W 12 L. a black
oak north 23 L -

2nd.

The 2nd division line begins at the stone
on the hill 80 poles west of the gr. sec. corner last named thence
south 139 poles to a white oak 483 W 19 L in the south line
of the sec.

3rd.

The 3rd line begins at the original gr. sec. corner
on the line between Sect 29 & 30 a w. oak &c - thence north
passed the stone in the swamp & centre of the sec. at 139 poles
304 poles to an elm in the north line of this sec 460 E
4th 25 links - The 4th line begins in the north line of this
sec 80 poles east of the north west corner thereof an elm 80 W
12 links thence 160 poles to a stake in a prairie. All of which
may seen on the plat,

D. M. Marion S. L. C.

Sam'l. Moore }
Wm Pittman } 66

184


annum 9th mo. (Sept, 28th 1832) Surveyor 184

8280

D. Ashen } Surveyed and divided Sect. 23. T. 4 R. 13 M.R.S.
J. Ashen } as hereafter described for David Ashen, John Ashen
Mr Pittman } William Pittman Robert Clark John McDonald &
R. Clark } William New Beginning at the corner of
Sect. 17, 18, 23 & 24 a white oak 438 W 13 links - a dog wood
485 E 26 L - thence on the line between Sect. 17 & 23
41 W 342 poles to the original corner of Sect. 16, 17 & 24
23 a bur oak 413 W 16 L - the other tree is down, which
is called for here - thence between Sects 22 & 23 -

156 At $89\frac{1}{2}$ W 322 poles, (passed a stone, the gr. sec. corner at $16\frac{1}{2}$ poles) to the corner between secs. 22, 23, 28 & 29 a hickory $120^{\circ}W 22^{\circ}L$. a hickory $176^{\circ}W 21^{\circ}L$ thence $18^{\circ}E$, with the line between 23 & 29 (erected a road at 20 poles, passed the gr. sec. corner at 472 poles and oak. $160^{\circ}W 11^{\circ}L$. a black walnut $168^{\circ}E 21^{\circ}L$) 344 poles to the corner of secs. 23, 24, 29 & 30 a black oak $11^{\circ}E 9^{\circ}L$. a black oak $172^{\circ}E 21^{\circ}L$. thence between secs. 23 & 24 ($188\frac{1}{2}^{\circ}E$ 320 poles to the corner of secs. 17, 18 23 & 24 a white oak $138^{\circ}W 15^{\circ}L$. a dogwood $185^{\circ}E 26^{\circ}L$) its original corner - thence between secs. 17 & 23 $6^{\circ}N$ with the old line 342 poles to the beginning containing 688 acres -

Plat

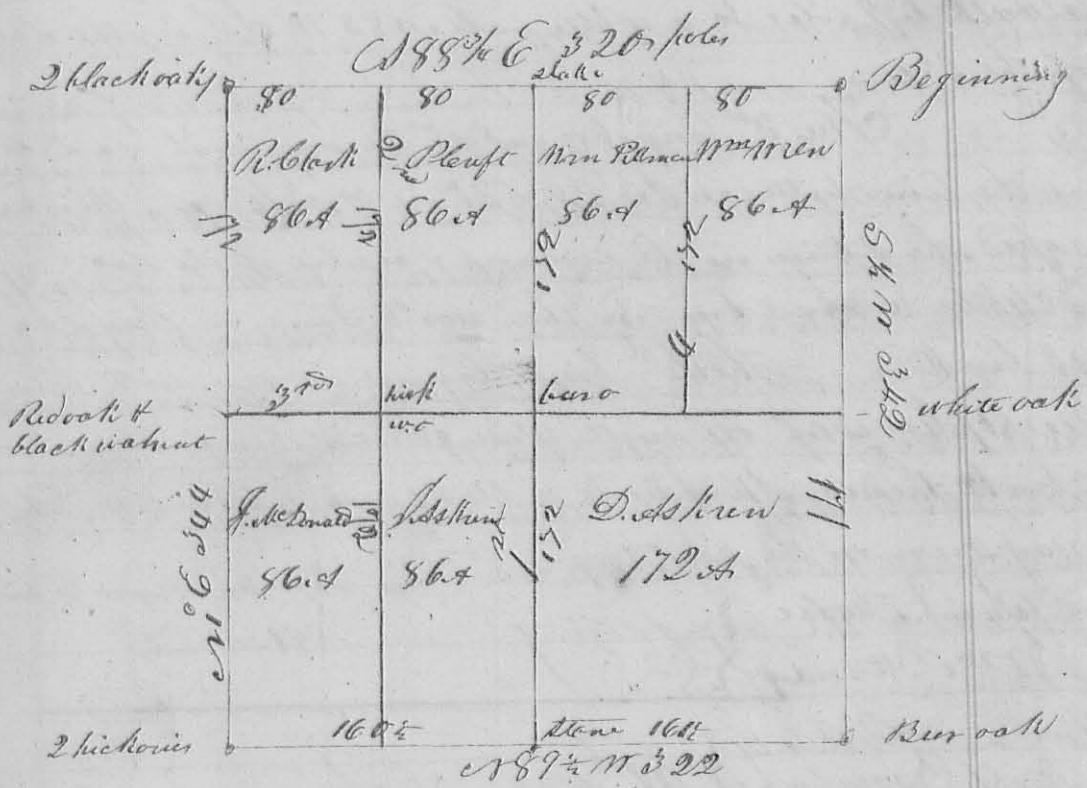

The 1st division line begins in the south line of the sec. 160 $\frac{1}{2}$ poles from the the southeast corner thereof, thence $18^{\circ}E$ at 172 poles passed a bur oak $172^{\circ}E 15^{\circ}L$ the center of the sec. 362 poles to a stake in a prairie in the north line of the sec. The 2nd division line begins at a hickory $172^{\circ}E 6^{\circ}L$ a hickory south 60' in the north line 80 poles from the N.W. corner of the sec. thence $18^{\circ}W 172$ poles a white oak $158^{\circ}E 28^{\circ}L$ a hickory $163^{\circ}E 172^{\circ}34^{\circ}L$ a stake in a prairie in the south line

of the sec 80 poles from the SW corner thereof

The 3^d line begins at the gr sec. corner in the west line of the sec. Thence S 9 $\frac{1}{2}$ E 340 poles, passing the centre corner, to a small white oak in the centre of the east line - The 4th line begins at a stone 80 poles west of the last named corner; Thence N 9 $\frac{1}{2}$ E 172 poles to a stone a hickory S 25 W 26 L. in the north line 80 poles west of the cr E corner of the sec. The number of acres and the owner's names are marked on each division of the plat.

La McMarnow
C, S, L, C,

Sam. Moon } 66
David Peall

R Clark 9th mo. Sept, 29th 1832

Surveyor 195 B.C.


Surveyed the east half of the N.E. gr of sec. 24 T 4 R 13 M.D. for Robert Clark. - beginning at the gr. sec. corner between sec 18 & 24 a stone in a prairie from which a red oak bears N 20 E 150 L. an original bearing tree thence between Secs 18 & 24 cr & fr E 162 poles to the N.E. corner of said sec. a white oak C 8 $\frac{1}{2}$ W 17 L a white oak N 16 $\frac{1}{2}$ E 34 L - Thence N 89 $\frac{1}{2}$ W with the original line 80 poles to a stone, a bur oak S 76 E 68 L - Thence S 9 $\frac{1}{2}$ W

162 poles to a stake in a prairie thence C 89 $\frac{1}{2}$ E.

80 poles to the beginning, containing 88 acres

Layton Pollock }

John Wren } 66

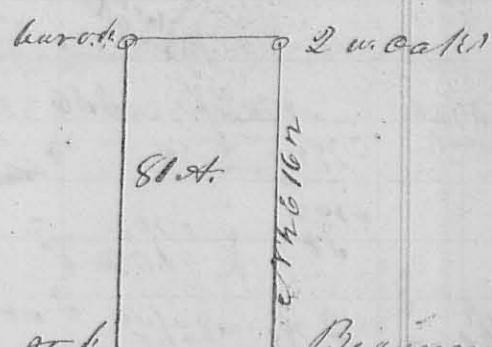

La McMarnow C, S, L, C,

Lake Leinen ¹⁸²⁸ 10 mo. Oct 8th 1832

Surveyor 196

by J. H. Farmer I. desurveyed and divided Zadock


Walker's Surveyor 676 for Lake Leinen

at the request of his atty John H. Farmer

Beginning at a white a dead black oak in Lad.
Louis line N.W. corner of Hamer Washington's survey

108

Surveyor 4479 and at the 30 mile tree on said
 Seeke line - thence with Ludlow's line N 19 $\frac{1}{2}$ W 204 poles
 S. E. corner to a black oak & white oak, formerly 2 black oaks)
 N.W. corner to Zadock Walker's said Surveyor & C. M.
 corner to Samuel Finley's Surveyor 4493 N 46 $\frac{1}{2}$ E
 thence with the south line of Finley's survey N 70 $\frac{1}{2}$ E
 336 poles to a black oak & white oak (S.E. corner to
 Finley's road at 164 & at 270 poles) - thence
 N 19 $\frac{1}{2}$ W crossed the road at 76 poles, 120 poles to
 a black oak and hickory in the east line of Finley's
 Survey, thence N 70 $\frac{1}{2}$ E 108 poles to a hickory, found
 it 4 poles cast, the other hickory is down - thence S 19 $\frac{1}{2}$ E
 182 poles (crossed a branch at 105 poles) to a stake in the
 north line of Thomas Worthington's Survey 4494 E
 thence S 70 $\frac{1}{2}$ W (107 poles) past 3 black oaks (a corner, at
 102 poles crossed a road at 76 162 poles to wherefor
 - meny stood hickories northward corner to Worthington
 Survey. thence S 28 W 188 poles to a black oak
 hickory and cherry tree another corner to Worthington
 thence S 70 W 107 poles to the beginning containing
 428 $\frac{1}{2}$ acres

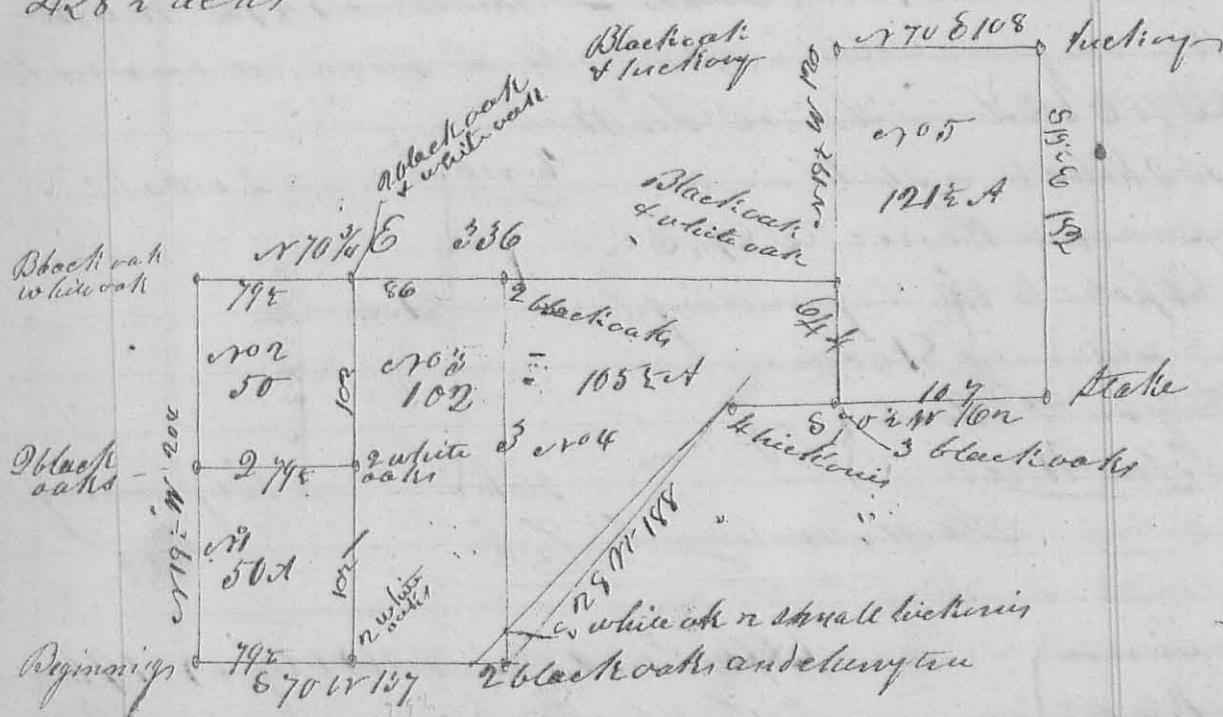

The 1st division line begins at 2 white oaks in the south
 - west line of the survey 795 poles from the south west cor
 ner thereof, thence N 19 $\frac{1}{2}$ W (102 poles to past 2 white oaks)
 corner, 284 poles to 2 black oaks & white oak in Finley's

157

South line - The 3rd line begins at 2 black oaks in Ludlow's line 102 poles from either corner thence c 70 E 79 1/2 poles to the 2 white oaks in the 1st division line -

The 3rd line begins at 2 black oaks in Fifty's line 86 poles east of the 3 oaks at the end of the 1st line, thence C 119 & E 172 poles to a white oak & 2 small hickories in the line of Worthington's survey c 28 E 32 poles from the 2 black oaks and cherry tree corner to Worthington

The 4th line begins at the white and black oak easement corner to Fifty, thence C 119 & E 64 poles to the 3 black oaks in Worthington's north line. The lots each bear the number of acres in each

Richd Shockey { 66
Jeffry Williams {
Geo. Moot mstr

J. W. Marrow
65 L. G.

10 mo. Oct. 10th 1832

Survey N 196

8283

P. Croft D Surveyed and divided section 22 S 4
Wⁿ Scott D R. B. M. R. as follows for Philip Croft, Wⁿ Scott,
J. Steel J. S. Morris, Wⁿ Scott, T. Johnson
Dair. Amis D Donald beginning at the corner of 16, 17, 20 & 24 a
Bur oak C 113 1/2 W 16 L, the other bearing tree is down
thence south with the old line (passed the original gr
sec. corner

	S	dist 3 1/2 rods		
	164	88	78	Beginning
J. McDonald	164 A	88 A	78 1/4 A	W ⁿ Scott 25
	163 A	84 A	78 1/4 A	32 1/2
between sec 16 & 22				
a white oak north				
125 L of 162 poles				
32 1/2 poles to a stake				
in a prairie -				
thence west between	162		83 1/2 78	a white oak
sec 21 & 22 poles the				
original gr sec	163 -		164 A	J. Steel 6 1/2
corner at 162 poles				
a red oak now	162	162 1/2		stake in a prairie
16 L the hickory				
called for here is down				
32 1/2 poles to the corner of 21, 22, 27 & 28, thence between 2, 28 & 25				

11° E 324 poles (skipped the gr. sec. corner at 162 poles a hickory west 6 links) 324 to corner of sec 22. 20, 28, 29, original corner trees yet standing thence between sec 22, 23, 160¹⁶⁰ E 89^{1/2} E 324 poles a stone at 162 poles the gr. sec. corner 322 poles to the beginning. The 1st line begins at the stone in the center of the front of the sec. Thence South 160 poles, a white oak 5 1/2 - 6 26 poles 322 poles to the gr. sec. corner in the south line -

The 2nd division line begins at the gr. corner in the line of the sec. a hickory west 6 L. thence 89^{1/2} E 162 poles, skipped the center corner 1 322 poles to the gr. sec. corner in the east line 3rd division line begins at 89^{1/2} N 78 poles from the last named corner at a stake, thence north 162 poles to a stake in the north line of the sec 78 poles from it e. & s. corner

Henry Wellmann
David Pate

Samuel Mann
C. S. G. C.

(3384) 10th mo, Oct. 27th 1852 ✓ Survey No 197
Sec. Gordon 3 Surveyed Fractional sec. 27, T4 R 14th Wth


for James Gordon: Beginning at the corner of sec 27, 28, 33 & 34, the original bearing trees are all down thence between sec 27 & 33 S 26° W 326 poles to the original corner of sec 26, 27, 32 & 33, a white oak 12d 5 1/2 ft 20 L. a white oak 6 1/2 ft 43 L all down marked a white oak 17 20 ft 26 L thence between sec 26 & 27 S 89^{1/2} E, crossed all Kep Creek at

160 poles 234

Bapt.

poles to the corner of 26 & 27 a white oak
at 25 6 32 L a white oak 14 6 W 22 L

in Judson's line
thence with said
line at 19 5 W 3 6 6
poles to the corner of
sec 27 & 28 trees down
thence between said

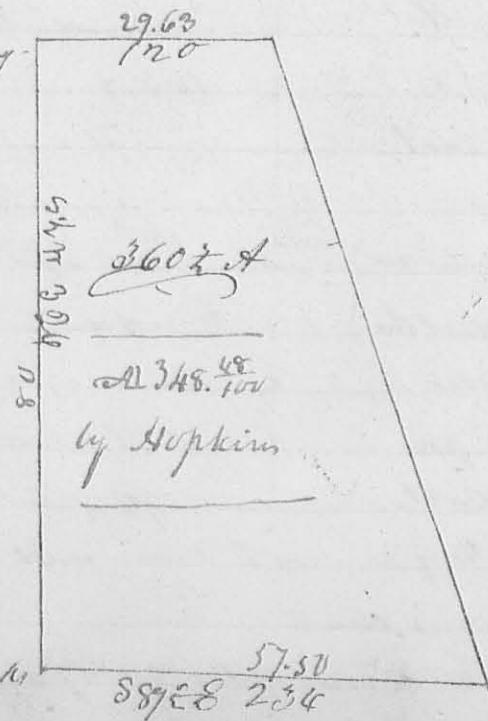

white oaks

Secr 789¹ N 120 poles to the beginning containing
368 $\frac{1}{4}$ acres.

John Gunn
Walter Gunn

La Motte M'nn
65.96

11th Nov. 1832

V. Surveyor No 198

Ano. Smith 3
Thomas Macason 3
John Riddell 3

Surveyed the north half of sec. 26 82.95
S. S. R. H. M. M. for John Smith Thomas
Macason & Jonathan Riddell as follows

No 198

Beginning at the corner of secs 26, 27 & 28 & 33
a red oak cemetery; thence between secs 26 & 27
589 $\frac{1}{4}$ E 326 poles to the corner of secs 20, 21, 26 & 27 a white
oak 585 E 142. a white oak 789 N 58 L. — thence between
secs 20 & 26 S 1/4 W 162 poles to a stake in a prairie in the east
line of sec 26 — thence S 89 $\frac{1}{2}$ W crossing a branch at 142
poles 326 poles to a stake in a prairie in the west line of
sec. 26. — thence N E 162 poles to the beginning containing
328 acres —

Beginning	326			W. oaks
815	Redo	2ds		
Southern	Smith	Cemetery		
Yellow				
84.5	84 A	168.0		
stake	87 $\frac{1}{2}$	stake		stake in prairie

The 1st division line begins at a stake in the north line of the
sec 815 poles from the N.W. corner of said sec a red oak 580 E
S 15 N 25. a white oak S 46 E 37 L — thence S 1/4 W 162 poles to
a stake in the south line of the half sec. — The 2nd line
begins at a stone in the centre of the sec. thence N E 8
at 815 poles marked a white oak S 63 E 36 L — a white
S 86 W 33 L, continued 162 poles to 2 small elms &
red oak in the north line of the sec. in a swamp —

La Motte M'nn

162) 11th M.O. (A.R.) 5th 1832 ✓ Survey R^o 199 162
 G. Broughton } Surveyed and divided the S.E. gr of Sec
 Annot & Amos } 20th R 14 M.R.S. for Gordon Broughton & Amos
 James } James & Abram James as follows. Beginning
 8286 at the corner of sect 2 & 3 in said T.R. a white oak
 162 E 10 L a black oak N 73 W 25 L original bearing trees
 thence between said sect. 88 $\frac{1}{2}$ 178 161 poles, a white 61¹ E 25 L
 a white oak N 53 E 29 L thence S 17 161 poles, a white oak
 N 15 E 11 L a black oak N 86 W 18 L thence S 89 $\frac{1}{2}$ E 161 poles to
 a white elm S 9 $\frac{1}{2}$ W 45 L in the east line of the sec —
 thence with said line N 18 161 poles to the beginning con-
 taining 162 acres

The 1st division line begins in the south line of the gr 53 $\frac{1}{2}$ poles west of the S.E. corner of the gr a hickory N 10 W 24 L thence N 18 161 poles to a stake in a prairie in the north of the sec —

		161		
6 $\frac{1}{2}$	2	6 $\frac{1}{2}$		
53 $\frac{1}{4}$	53 $\frac{1}{4}$	53 $\frac{1}{4}$		
			161 mi	Eldon

24 L Book

The 2nd division line at a stake in the prairie in the north line of the sec. 53 $\frac{1}{2}$ poles west of the last named corner thence S 17 W 161 poles to a stone in the south line of the gr.

John Grindle } 66 Sam Mannon
 Eliphalet Gray } 66 ——————
 —————— 65 L.G.

8287 11th M.O. (A.R.) 6th 1832 ✓ Survey R^o 2002
 John Grindle } Surveyed the N.E. gr of Sect 1 Town 3 -
 ex 200 } 164 M.R.S. for John Grindle Beginning
 at the corner of

sect 1 & 2 in said T.R.
 a white oak 62¹ W 30 L
 a hickory N 14 W 65 L
 thence S 17 W 162 poles
 to a stone a white oak
 55¹ E 8 L. same

John Grindle	Beginning
164 Acres	$\frac{5}{3}$ 62


S.D.

163 189 N. crossing a prairie 162 poles a white oak
180 N 302 L a n. E 12 $\frac{1}{2}$ E 33 L. thence N 162 poles a white
oak S 83 E 16 L orig in al corner down in the north line
of the sec. - thence with said line S 89 E 162 poles to the be
ginning containing 164 acres

Gordon Braghton C.C. *D. W. Harmon 65 1/2*
Abraham James

11th M.O. Nov 28th 1832 ✓ Survey r^o 201
Hannah 3 Surveyed the east half and the west half
Benson 3 of the N 89 E of Sec. 26, R 12 E & T 4 S, Harden
201 County for Hannah Benson - Beginning in
the north line of said sec. 84 poles west of the E corner
thence a bur oak S 70 E 4 L - a maple N 86 W 28 L. thence
S 13 $\frac{1}{2}$ E crossing the Sandusky road at 46 poles, 164 poles to
Brading - thence S 87 $\frac{1}{2}$ N. crossing said road, 167 poles
a buck S 58 W 7 L
a buck S 85 E 17 L
thence N 3 $\frac{1}{2}$ W 16 $\frac{1}{2}$ poles
a buck S 57 E 11 20 L
a buck S 69 E 23 L
in the north line of
the sec. - thence with
said line S 57 E 2 buckles 887 $\frac{1}{2}$ 107 30 m²
167 poles to the beginning
containing 170 acres *D. W. Harmon 65 1/2*

Philip Mackethan C.C.
Samuel Johnson

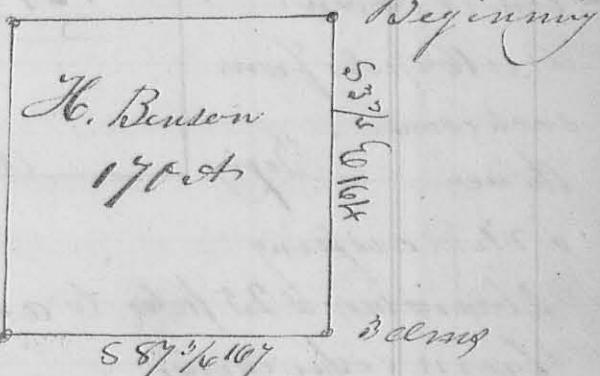

11 M.O. Nov, 30th 1832 ✓ Survey r^o 202
Geo. Hellman 3 Surveyed divided Sec. 12 T 4 S R 14
Christy Hautz 3 & others 3 M.R. opposite for Christy Hautz, George
Hellman, & others, Beginning at the corner
of Sec 11, 12, 17 & 18 a white oak original corner
down, thence between Sec 12 & 18 S 7 $\frac{1}{2}$ E crossing a
branch at 25 poles, 32 poles to the E. W. corner of sec
12, the original corner down, set a stake - thence

8288

164

thence S 89 1/2 E. crossing a road at 234 poles, one at
 260 poles, 327 poles to the corner of Sec 6 & 12, a white oak
 S 72 W 62 No cr 1/4 E 26 L. thence S 70 W, crossed a road at
 78 poles one at 120 poles, a branch at 236 poles, one
 at 312 poles, 324 poles to the corner of Sec 15 & 6, 11 & 12 a
 bur oak at 37 N 26 L a sugar tree cr 1/4 E 10 L now
 down, thence between S 11 & 12 west, crossing Tuckers
 run at 40 poles a small pond at 138, 328 poles to the
 beginning

The 1st division

line begins
 at the original
 gr. sec corner in
 the south line of
 the sec. a white
 oak (S 47 E 28 L
 (the other bearing
 true it down,
 it is 164 poles from
 each corner

thence Begin
 and crossing

S 89 1/2 E 327 -			
163 t	163 h	white oak	
63 G. H.	167 s	167 e	63
	G. H.		S 47 E 28 L
163 t	163 h		52 X
	167 i & A	167 e & A	
164	164		Bur oak & sugar tree
west 328			

2 branches 325 poles to a stake in the north line 163 poles
 from either corner

The 2nd division line begins at the original gr. sec corner
 in the east line of the sec. 163 poles from the S.E. corner
 of the sec a red oak at 84 E 21 L a white at 76 N 14 L
 thence S 89 1/2 W cross, a branch, 327 poles to a white
 oak N 28 E 20 L a white oak 10 E 16 L in the west line
 163 poles from the S.W. corner of said sec

Henry C. Plowman
 John Keauty

John Keauty > 12th M. D. 1832 Surveyor #203
 Jacob Good Surveyor the South half of sec 14
 1832 R. McR. for John Keauty and Jacob
 Good Beginning in the west line at the S.E. corner


6189

1605

of said sec. a white oak 161 ft 13 L, a white oak N 50 E
 53 L, thence between sec 3 & 4 & 89 N crossing a branch
 at 2118 poles) 323 poles, to the corner of sec 3 & 4 9 & 10 a
 black oak 161 ft 12 L a white oak 166 ft 11 L thence
 N 60 E 10 ft N E crossing a spring branch at 98 poles) 160
 poles to the original quo se corner, a white oak 163 ft 30 L
 a white oak 161 ft 35 L, the latter is down - thence C 89 1/4 E
 crossing a branch at 298 poles, 322 poles to a small bur oak
 in the east line of the sec - thence S W crossing a branch
 at 160 poles) 160 poles to the beginning containing 32.2
 acres

The division
 line begins
 in the north
 line of the sec.

81 1/2 poles from
 the corner of
 the quo a bur oak

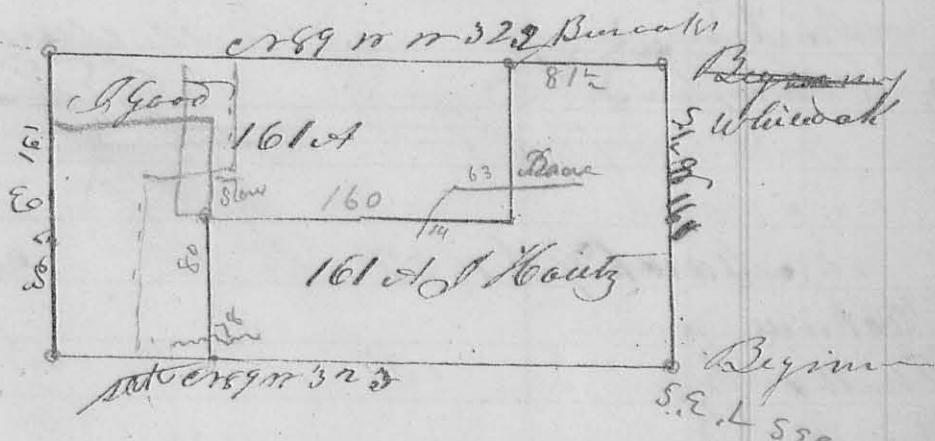

east 6 L a bur oak 161 ft 13 L - thence S W crossing
 a mill race at 63 poles) 80 poles to a white oak 164 ft 6
 10 L thence C 89 1/4 W. crossing the mill race at 14 poles -
 100 poles to a stone - thence C 89 1/4 W crossing a branch
 at 78 poles 88 pole, to a stake in a prairie in the south
 line of the sec -

I. Scott 3 D^o m^o. Feby 1833 Survey No 204 (8290)
 J. Blouse 3 Surveyed the south half of sec

No 204 3 A. T. & R. M. S. for Isiah Scott & John Blouse

Beginning at the corner of sec 3 & 4 9 & 10 a hickory

north 5 L. oak & hick

a hickory 524 ft 16 L


thence between

sec 3 & 4 East 326

poles to the corner

between 3 & 4 a

black oak 66 ft 13 L 13 ft

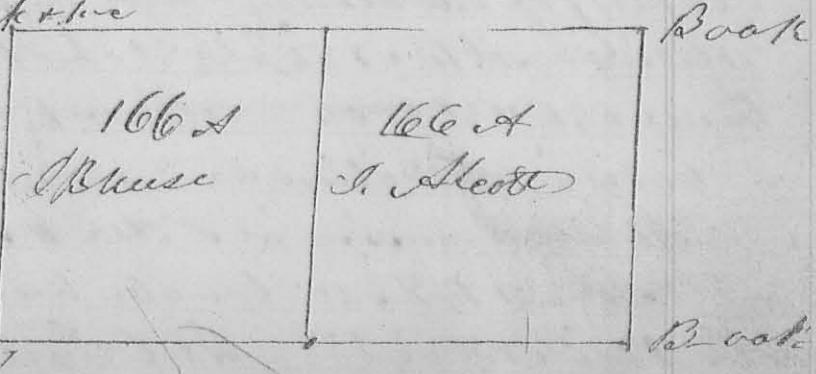

at a bur oak 1865 ft N 12 L (the black oak is broke down
 thence on the east line of the sec^t 18 E crossed a small
 branch at 118 poles) 163 poles marked a small black
 oak at 85 E 11 L a black oak bush at 26 N 10 E L
 thence west 323 poles to the original go sec corner between
 Secs 4 & 10 a white oak 577 ft N 12 L a hickory at 576 20 L
 thence between Secs 4 & 10 S 5 E or 163 poles to the beginning
 containing 332 acres - The division line begins in
 the south line of the sec. at 163 pole from each
 corner a hickory, 129 E 16 L which, 558 ft N 12 L, then
 at N 8 E 163 poles to a stake in the centre of the sec.

S. A. King & J. C.
 H. Clayton

Asst. Surveyor
 G. S. G. C.

March 9th 1833

✓ Survey of R. 205

Stockwell }
 Smith & }
 Downy }
 Cross }
 Rd }
 rt of }
 Deputy }
 return }

(3)

	ch L	ch L
D	40.20	40.20
	40.40	40.37
	163.05	163.57
	100	100
	Stockwell	Stockwell
(4)	2010	40.20
	81.50	163.37
	Stockwell	Smith
A	2012.5	40.25
	81.86	40.12
	Stockwell	Downy
B	8	8

(2)

(1)

Bearing of the section lines in the above plat is as
 follows A. N. 84 1/4 E Stockwell thence N 8 W Stock
 thence S 88 W 50 ch - thence S 88 ch -

Corners of section and division lines are as follows
 At 1st sec. corner also Ash 10 ft D. 116 35 L 1 ft on
 wood 183 ft N 17 L. at 6 water bush 40 ft. 83 ft N 17 L
 ash 22 ft D. 30 ft E 2 1/2 ft O Lynn 36 ft East 17 1/2

Swampash 18 S.E. 36 1/2 L - at 7 bush 10 S.E. 161 1/2 15 L
bush 18 S.E. north 50° At original corner post —
At B see corner at 2 old gr sepost at C see
corner post at 3 bush 18 S.E. 161 1/2 15 L Brownwood Dist
11 L at D see corner at 4 bush 30 L east 44°
~~12 L~~ 161 1/2 5 65 N 20 L — corner tree

I certify the foregoing to be correct and true as made
by me March 9 A.D. 1833 for Stockwell, Smith &
Israel Downy on Run Cr. being the resurvey and
subdivision of sec 26 & 2128 E - D Hopkins Deputy Surveyor
I certify the foregoing a true copy as returned to me

J. W. Mellenow
6526-

March 15th 1833.

✓ Surveyor 1833

Hugh Howell 3
R. Braider 3
J. Hays 3
18. 206

No 2 of
Dept'y
Survey
etc

		East		
19	5	39.08	156.22 A	39.16
		38.57		
		26.1	12.90	
		104.36	50.4	11.31 A
				1/8 Acre
		25.70	12.90	38.10
				Stake

Small w. gr East

original corner
ash & hickory -
posts

Original corner
of the sec -

The two north corners of the above fifty acres lot
no trees near — This survey No 2 (of survey returned
by my Deputy) represents sec 11 & R 13 Mds - for
Hugh Howell, R Braider, Hays & Hays - adjoining
Brown - March 15th 1833 D. Hopkins Deputy Surveyor
I certify the foregoing to be a correct copy of the surveyor or
of my Deputy D Hopkins as returned to me for record -

J. W. Mellenow
6526-10

168 April 3rd 1833 ✓ Survey or 207 168
 (8293)

Sodum 3 Survey or 207 represents Sect. N 3 S 2
 Banks 3 R McBeth & C. 6 qr of Sect 2 Lawrence
 Town 3 Ship of Range - Owner names on marked
 ro 3 of 3 on the several quarters
 survey 3 Green & E. of Bowditch Church
 Cleared April 3rd 1833 D. Hopkins Deputy S.

original sec. corner		East	original sec. corner (the opposite corner is down)
Original sec. corner	Not surveyed	40.20	
		7 Divn 160.80 100 W prairie 40.20	
original post corner	40.10 Banks	7 Divn	
	160.40	160.80 ft	
Original sec. cor.	40.20 State in prairie	40.20 East 7 Divn 160.50 ft	old corner cut down (only Jack oak & 12 ft. e 71 18 28 do 80 85 18 16 4
Bur oak N 36 57 W 77 4 do 16.1 26 75 W 80 L		40.20 C 78 56 8	corner between Smith & Banks made by A. McBeth

I certify the above to be a correct copy of Survey
 no 3 as made or returned to me by Dan Hopkins
 Deputy Surveyor Gen. - Farmer McBeth

D. Hopkins

Chewell 3 April, 4th 1833

McBeth 3
ro 4 of
Copy Survey
 (8294)

✓ Survey or 208

Surveyed, for Samuel Chewell & William
 McBeth, the 3rd qr of Sect 3 T 13 R 12
 as follows - Beginning at the E. corner of
 the section at a black oak 12 ft. corner tree, thence
 S 2° W 40.25 chs to original corner on the east line of
 the sect. thence west 42.06 chs to a jack oak 6 ft. 758 ft.
 50 L. and a jack oak 3 ft. 76 ft. 57 L. (State in the Liberty
 road) - thence in the road 1 3/4 E 48.5 ft chains to a N.W.

169 15 A. D. 740 E 30 L, Black oak 15 A. D. 7568 N. 56 L. on
the north line of the sec. Thence with said line S89 $\frac{1}{2}$ E.
43.75 chs. to the beginning containing 174.803 acres —


Then cut off the south side

of said gr. for milian.

• McBeth 24 acres by a
line as follows — begin.
—ning N $\frac{1}{2}$ E. 5.5 chains
from the S.W. corner thence
at a N. O. 18 A. D. 756 N

33 L + W. 022 A. D. 650 M 2 yds. east
35 L — thence East 4.5 chains to a N. O. 18 A. D. 617 H. 32 L —

(Carried off April 29th 1833) D. Hopkins Deputy Surveyor
George F. Rock 166. Certify the foregoing to a corner
Handy Powell 166. as returned to my office by D. Hopkins
his Deputy Surveyor

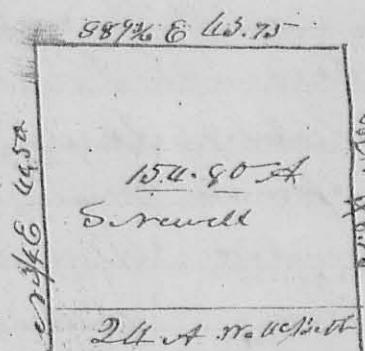

Beginning
black oak

original corner

D. Hopkins Deputy Surveyor

James Marmon
C. S. L. C.

5 Madison

1605 cap. April 30th 1833

Surveyor 169.

for James Ferguson et al grs 18 & 19 of

8295 R. & Lewis town Reserve — Beginning at the original gr. corner on the west boundary — thence N $\frac{1}{2}$ E. 40 chains to a white oak 18 A. D. 736 H. 12 L. N. C. 9. D. 5 H. 6 5 L. thence N $\frac{1}{2}$ E. 40.5 chs.


40.5 chs. to original gr. sec. corner on the north line of the sec. — thence S86 $\frac{1}{2}$ W. 10 M.

thence to N.W. corner of sec.

thence with its west line

W $\frac{1}{2}$ E 40.5 chs. to the beginning, containing

162 acres

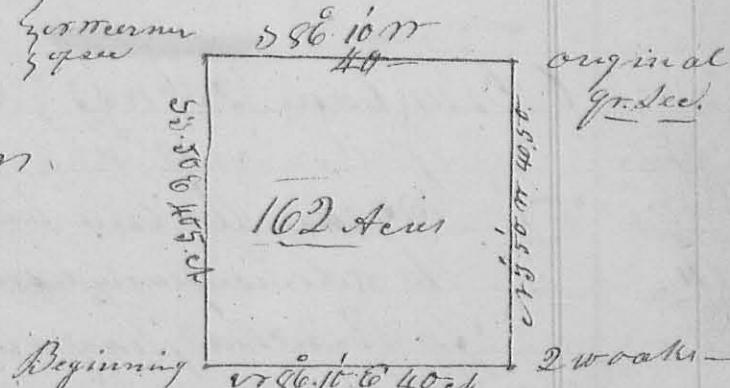

original
gr. sec.

Beginning N. C. 9. D. 5 H. 6 10 M. 2 weeks —

D. Hopkins Deputy Surveyor

Martin Leger 166. Certify the foregoing to a correct copy
James Leger 166. of Surveyor's return, to my office
April 30th 1833 by D. Hopkins — J. Marmon

C. S. L. C.

May 5th 1833

170

Surveyor 210
Subdivision of Sec 36 T³ R 14 W.B.

Barn

Mefford

Ripogle

Lerrell

No 6 of

Dept Survey

3

3

3

3

Stake in
a prairie

Barn	40.00	405.8	Stake in a prairie
Barn	81.08.4	20.12	Hickey 65721172
Stone	44.60		Burook 18526623
Mefford			
163.405.8	81.70	20.12	
Stone			
Mefford			
82.11.8	40.70		Burook 8560729
82.11.8	20.35	20.35	Hickey 5554820
Ripogle	82.11.8	26.65	
Lerrell	82.11.8	82.11.8	
	82.11.8	40.70	
	82.11.8	20.45	
	82.11.8	20.45	Stone in a prairie

N.W. 1/4 D. 10 S. 10 W. 2d. L.
do 18 d. 865 E 47 L

20.35	20.35	Stone	
Lerrell	Ripogle	Mefford	
82.11.8	82.11.8	82.11.8	

Street of sec

Stone

no trees near

D. Hopkins Deputy Surveyor

John Mc Neal
Dan'l Jones
May 5th 1833

I do certify the above to be a correct copy of Surveyor no 6 returned to my office by D Hopkins
Deputy Surveyor L.C. Cla Wellerman 6626

8296

6th mudham 1833 Surveyor 211

V. Gray
C 70-
211

Bran the line between Sec 107 T³ R. 14 W.B.
the adverse party having previous notice thereof
for Vincent Gray and took the depositions
which follow on the ground - Beginning at
a stake in a prairie, which stake is the one referred to
by Abner Noddy in his deposition no 1 the line etc
at gopher took the depositions of George Dumb
no 2 John Haller no 3 and Abner Noddy no 4 for it being
on the south bank of a small creek came to the water

171 in the lake at 107 poles; it is 20 poles wide at 160 of 171 poles took the deposition of John Hall all in the 5th arr off S. Darrow et al. and here I caused a stone to be planted which bears 145 & 6 poles and 3 links from a spring at the base of the hill, present John Head & Snoddy Geo^t Dunn, Rachel Blaylock, Samuel Carter, & chain men, continued same course, passed an old lime tree at 272 poles, 322 poles to the line between the 1st & 2nd tier of sections in this township, planted a stone from which a white oak bears 145 & 54 links.

Isaac Powell ⁶⁶ James McNaughton ^{65 L C}
Adam Cappy ⁶⁶

Depositions taken on the ground where making the foregoing survey —

The State Of Ohio ^{1/4 Twp}
Logan County

The deposition of Abner Snoddy taken relative to the existence of a stake at the intersection of the lines running east and west & north and south at the corner of sections 6 & 12 & 4 & 13 & 1 & 7 Sec R 16 M 12
which was taken the 28th day of June A.D. 1833, the adverse party having previous notice, who being duly sworn deposed and saith "That in the summer of 1810 he the deponent in company with John Dunn & John Foster searched for said corners, and found an old stake in the following manner to wit, by placing one of their party in the prairie, while the other two took the range of the lines, and gave directions to the one in the prairie to stand at the point of intersection, but that before they had fully accomplished their directions, by taking the range of the lines, the one in the prairie cried out to them that he had found the stake, and that he the deponent has ever since been acquainted with the place and really believes that the old stump of

172 a stake now remaining in this prairie is at ¹⁷²
the same place, it having been recognized by the neigh-
bor ever since as a section corner and further this de-
ponent saith not how sworn to and subscribed
on the ground before me by said Abner Shroddy
the date above written J. A. McElroy Esq C.

No 2

The deposition of George F. Dunn
taken on the line between Sec 17 & Town
Rd 3 R. Rd 10 at 90 poles from the south corner
of said Sec. who being duly sworn deposeth
and saith

That he has known that there was a line marked here
on some of the trees in this grove, and that he has re-
peatedly seen said line, and that he has seen one or
more line trees between this point and the corner marking
a line (or more than twenty years ago) and frequently
since that period until the trees were cut down
and further this deponent saith not G. F. Dunn
Sworn to and subscribed on the ground before me this
28th of January D. 1833 J. A. McElroy Esq C.

No 3

The deposition of John Hall taken on the line
aforesaid, who being duly sworn deposeth
and saith That he traced this line from
the corner, south, to this ~~place~~ 26 years ago, and that
there were three trees marked between the corner and the
lake, and that they were at or near the place which
I have just now removed! and further this deponent
saith not John Hall

Sworn to and subscribed before me on the
ground this 28th day of January D 1833 J. A. McElroy
Esq C

No 4

The deposition of Abner Shroddy taken
on the line between S. Sec 17 T 3 R. 14 M.R. at
90 poles from who being duly sworn deposeth & saith

173

173 a That for a period of 23 years he has known
that there was a line on this bank marked as a
line between said sec. & that said tree formerly
stood near the line which the Surveyor has just
now run." — At 106 poles he further saith that
he knows that there were trees marked on that
bank near this place, which were considered by
himself and others as a continuation of said sec.
line" and further the deponent saith not —

Abner Alnoddy,

Swear and subscribe on the ground before me
this 28 of June AD 1838 Garrison C.S.L.C.

cX^o5

The deposition of John Hall
taken on the aforesaid line at 106 poles
who being duly sworn deposeth & saith
"That 18 or 20 years ago he was here, and at that point
then stood 2 trees marked as a gr sec. corner trees
usually are —

Questioned by Surveyor

What kind of timber were these trees?

Ans^r of the deponent — They were white oaks

Q. by Surveyor — What was the size of these trees?

Ans^r. — They were about 15 inches in diameter

Q. by the Surveyor. How were these trees marked?

Ans^r. — They were blazed about 1 inch long about
three feet from the ground, and a small notch
cut into this blaze —

Q. by Surveyor. On which side were these trees marked

Ans^r. — "The tree that stood most easterly was marked
the westerly side, and the one most westerly was
marked on the northeasterly side"

Q. by Surveyor — Art thou sure that the roots which I caused
to be dug up to day were at the place where one
of said trees stood —

Ans^r — I believe that it is the place. And further this deponent
saith not

John Hall

174

174

Sworn to and subscribed on the ground before me
the 28th day of June AD 1834 James Williamson
G.S.L.C.

176

The deposition of George F Dunn taken on
the aforesaid line at 160 poles it being on a
bank north of a small lake, who being duly
sworn deposeth and saith "That about 20 years
ago he was first acquainted with this place, that there
were then, and for several years since trees some where
near this point marked as quarter section corners
and believe the place when the roots were dug out and
referred to in John Halls' deposition were at the place
when one of said trees stood" — And further this depon-
ment saith not. — G. F. Dunn

Sworn to and subscribed before me on the ground
the 28th day of June AD 1833 James Williamson
G.S.L.C.

I James Williamson County Surveyor of Logan
County do hereby certify that the foregoing are
true copies from the original a, taken on the ground
and placed on file in my office June 28th 1833

James Williamson

G.S.L.C.

8191

P.McIntire 21st May 1833 C. Winters

Surveyed the N.W. and E. of S.E. gr. of
Sec. 9 & 1 R 8 E of Meridian for Patrick McIntire
and Owen Winters. Beginning at the south west
corner of said sec. original bearing tree standing a buck 52 E
27 L. a buck 27 W 5 L. thence between sec. 9 & 16 or 86 E
240 poles a buck South 2 L. thence 14 W 160 poles, crossing
the road from Bellefontaine to (Shady) to a buck east
29 L. thence 186 W 240 poles a bur oak S 58 E 12 L a
buck N 7 E 13 1/2 L in the west line of the sec. — thence with
said line 54 E 160 poles, crossing said road to the beginning

Survey N° 912

Surveyed the N.W. and E. of S.E. gr. of

(Sec. 9 & 1 R 8 E of Meridian for Patrick McIntire
and Owen Winters. — Beginning at the south west

containing 240 acres

The division line begins on the south line of the sec. a large white oak 820 ft. S.L. a buckeye 546 ft. L. thence N.W. Beginning C.R. 546 200 Buck
Buck

(crossing the road) 160 poles to a buck G 182 E 16 L. in the north line of the 9th sec. making two equal lots of 120 acres each

John Hannan C.S.Y. 6.

11th instant, 9th 1833 ✓ Surveyor # 213

A Brown { Surveyed 200 acres of land for Aaron Brown 8298
No 213 who presented to me a certificate from George Trouss - top Auditor of Logan County dated at Bellefontaine Decr. 12th 1831 certifying "that 200 acres of land of 711 acres of land surveyed in the name of Richard Call et al of Entry # 4810 on the waters of Mill Cr. in said County which land is forfeited to the State of Ohio in the name of Fremial Melone for non payment of taxes interest and penalty for the years 1823 to 1831 inclusive, amounting to \$1790.7 was this day sold by me to Aaron Brown, a quantity to an act entitled an act to provide for the sale of lands forfeited to the State for the non payment of taxes, passed March 16th 1831" You are therefore hereby required to proceed at the request of the purchaser to ascertain the boundaries of such tract of land so purchased. — Wherefore I began at the north west corner of Richard

Call's survey # 4810 on the waters of Mill Cr. at a hickory Sugartree, buckeye & walnut all of which are down, except the Hickory, corner to said survey and it's corner to Wm Croghan's Survey # 4689. —

Hence with the north line of Call's { small buckeye Survey # 753° E (present bearing)

178.9 poles to a buck, lynn and Sugartree, — thence S 37° E 178.9 poles to a

