


C. Thompson's Tract 4 overlaps Lot #14.

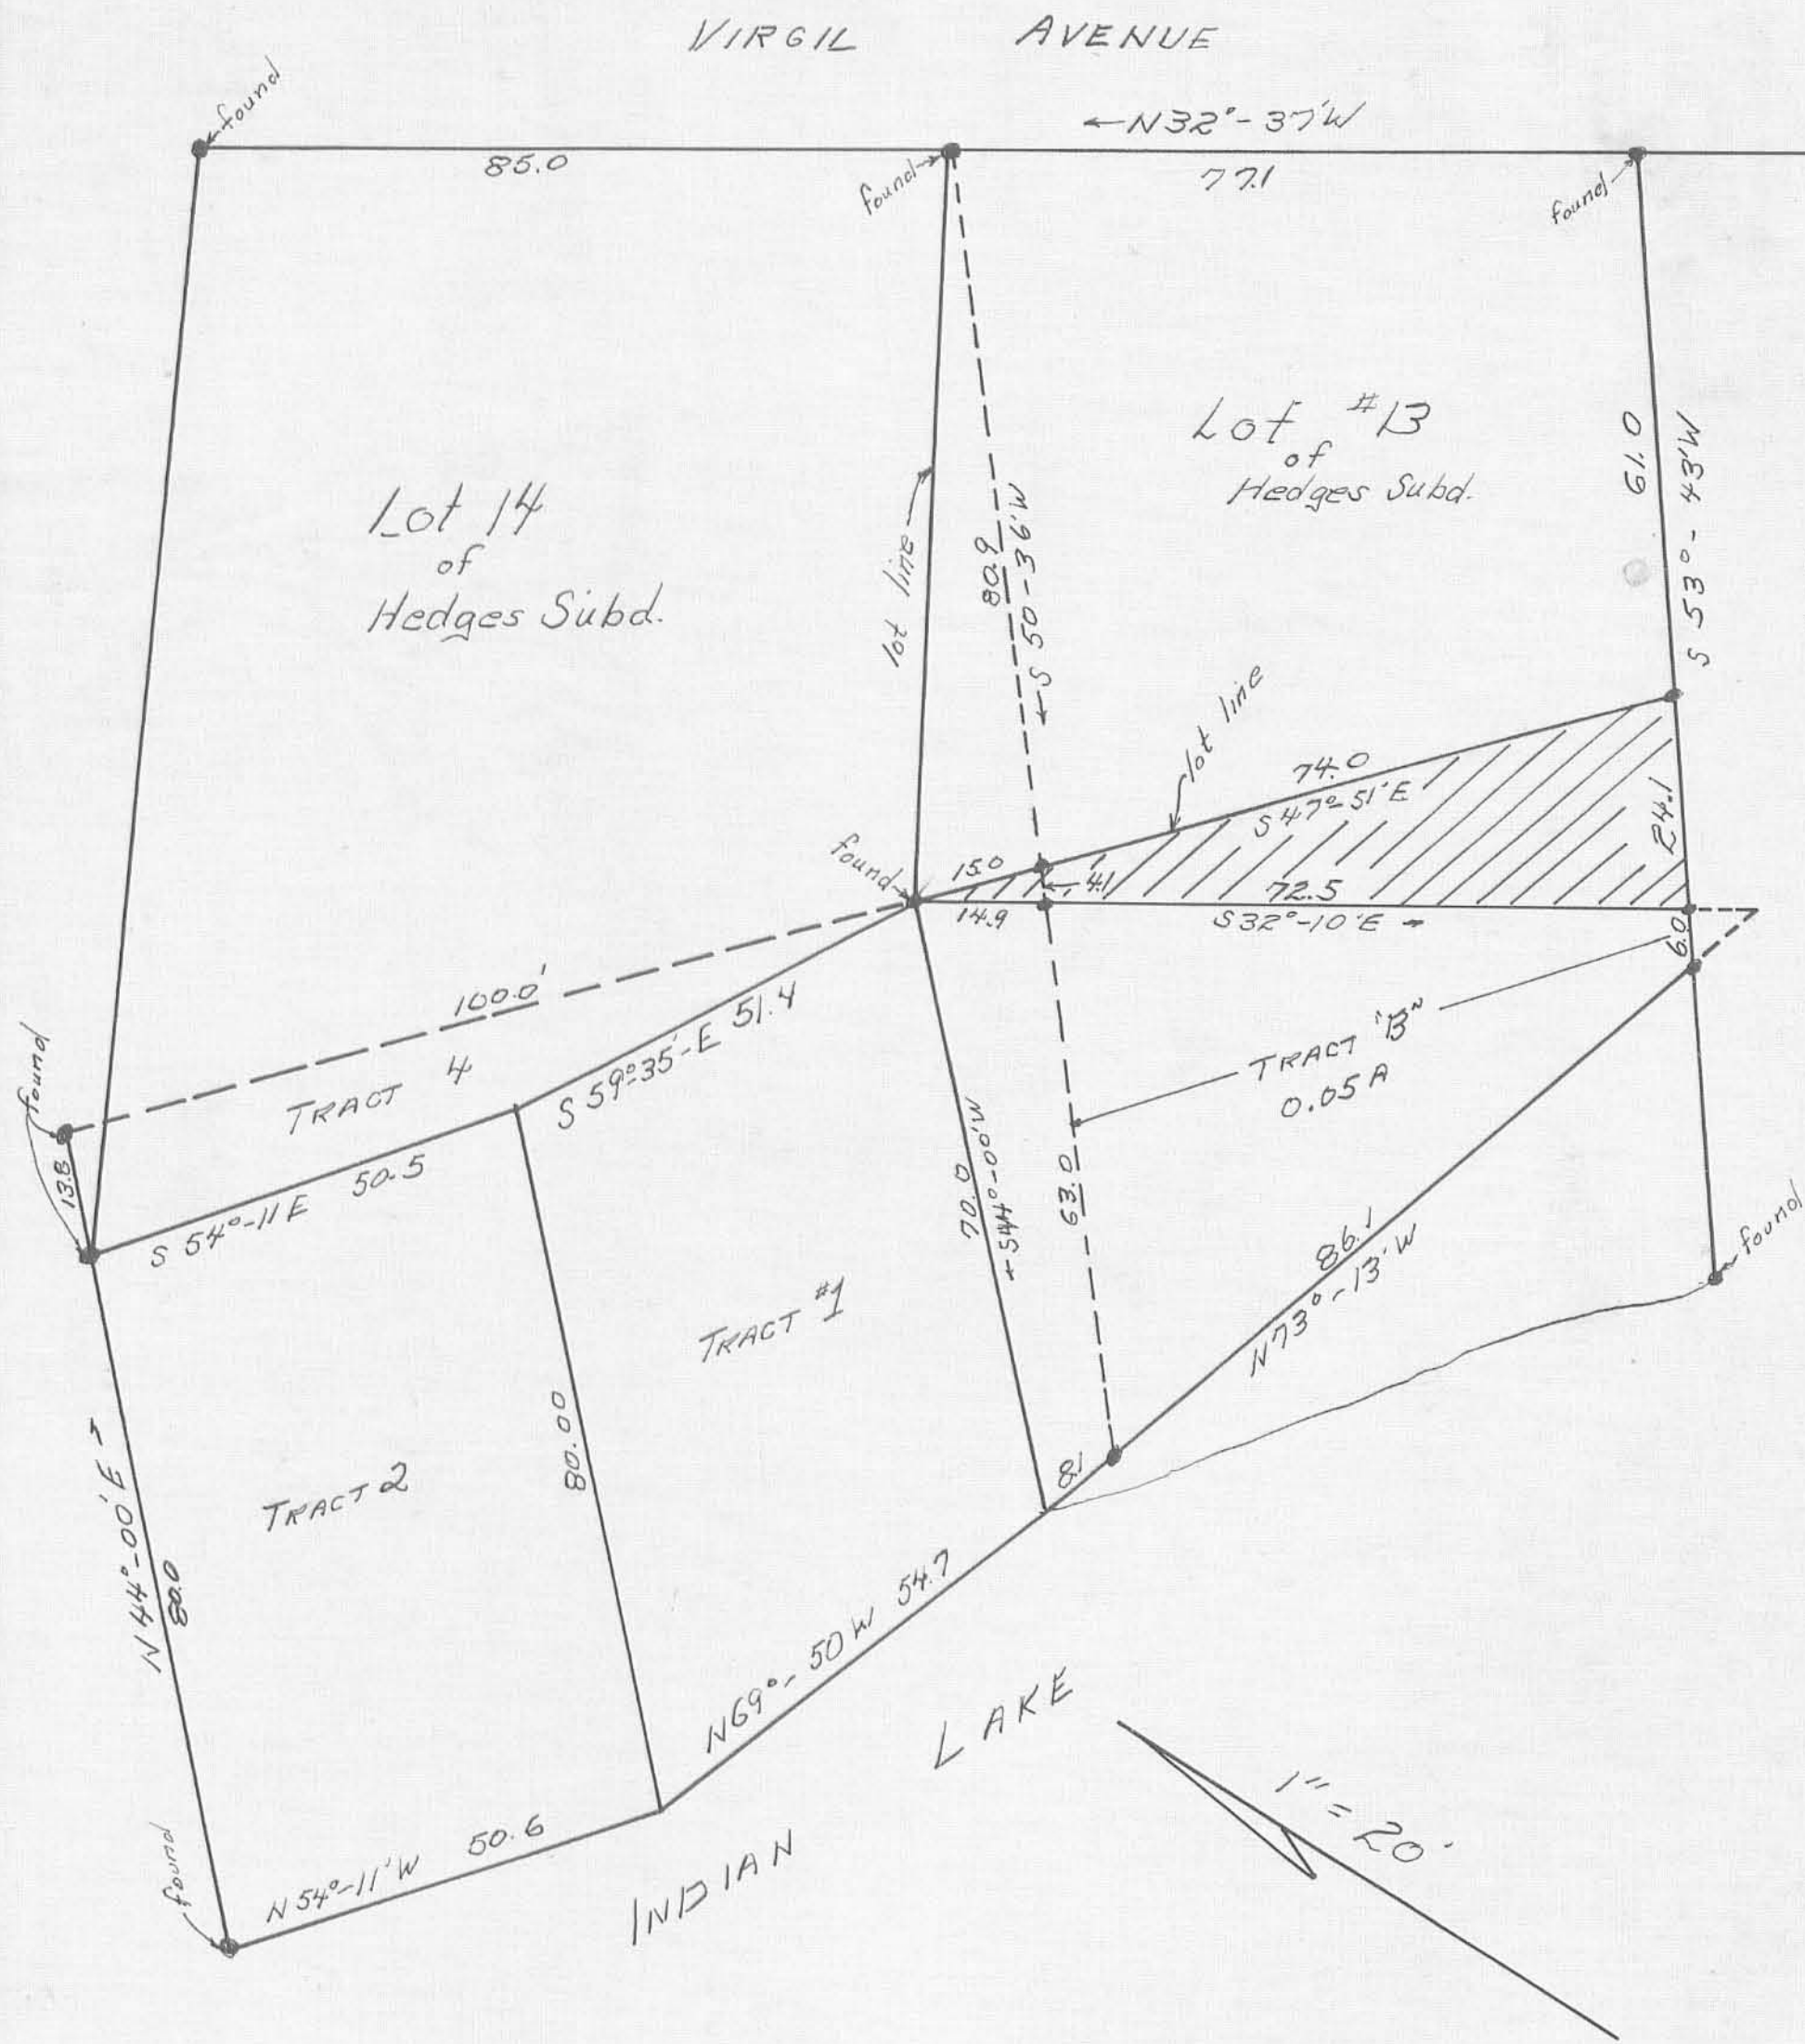

Lot #12  
Shaded area is land between Lot #13 + C. Thompson land.

Thompson Survey  
 Washington Twp., Logan Co., Ohio  
 V.M.S. 9925, 9946, + 10121  
 June 4, 1960  
 Owen K. Shirk; Reg. Surveyor 4271