


Layton Shoots

N 40°-36' W 2667.5



Steel Post  
N 88°-13' E  
139.0

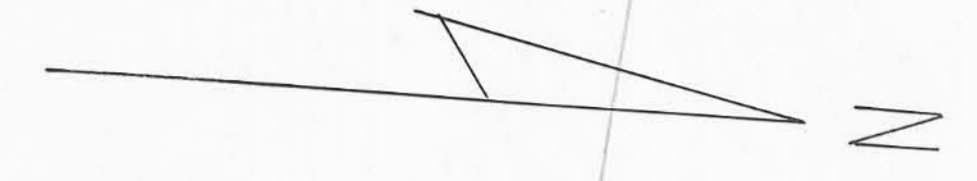

26.56 Acre Tract

N 88°-12' E  
721.0  
V.M.S. # 3327  
V.M.S. # 9823

MOUNTAIN LAKE

JEFFERSON TWP  
RUSHCREEK TWP

S 3°-57' E 1308.5

S 84°-56' W 8523  
STATE ROUTE #47

NOTE:

I made a survey of the east side of Mountain Lake & tied it to the "Old Kitchen Line" & west property line. Co. Engr. Field Books #19, page 58, # 480, page 4 were used to re establish the "Old Kitchen Line". The Twp was scaled from County maps. There is a total of 68.20 acres in V.M.S. 3327; 22.40 acres of this total is in the lake.

JEFFERSON & RUSHCREEK TWPS.  
LOGAN CO., OHIO  
PETERSIME SURVEY  
OWEN K. SHIRK, SURVEYOR 4271  
BELLEFONTAINE, O. SCALE: 1"=100'