
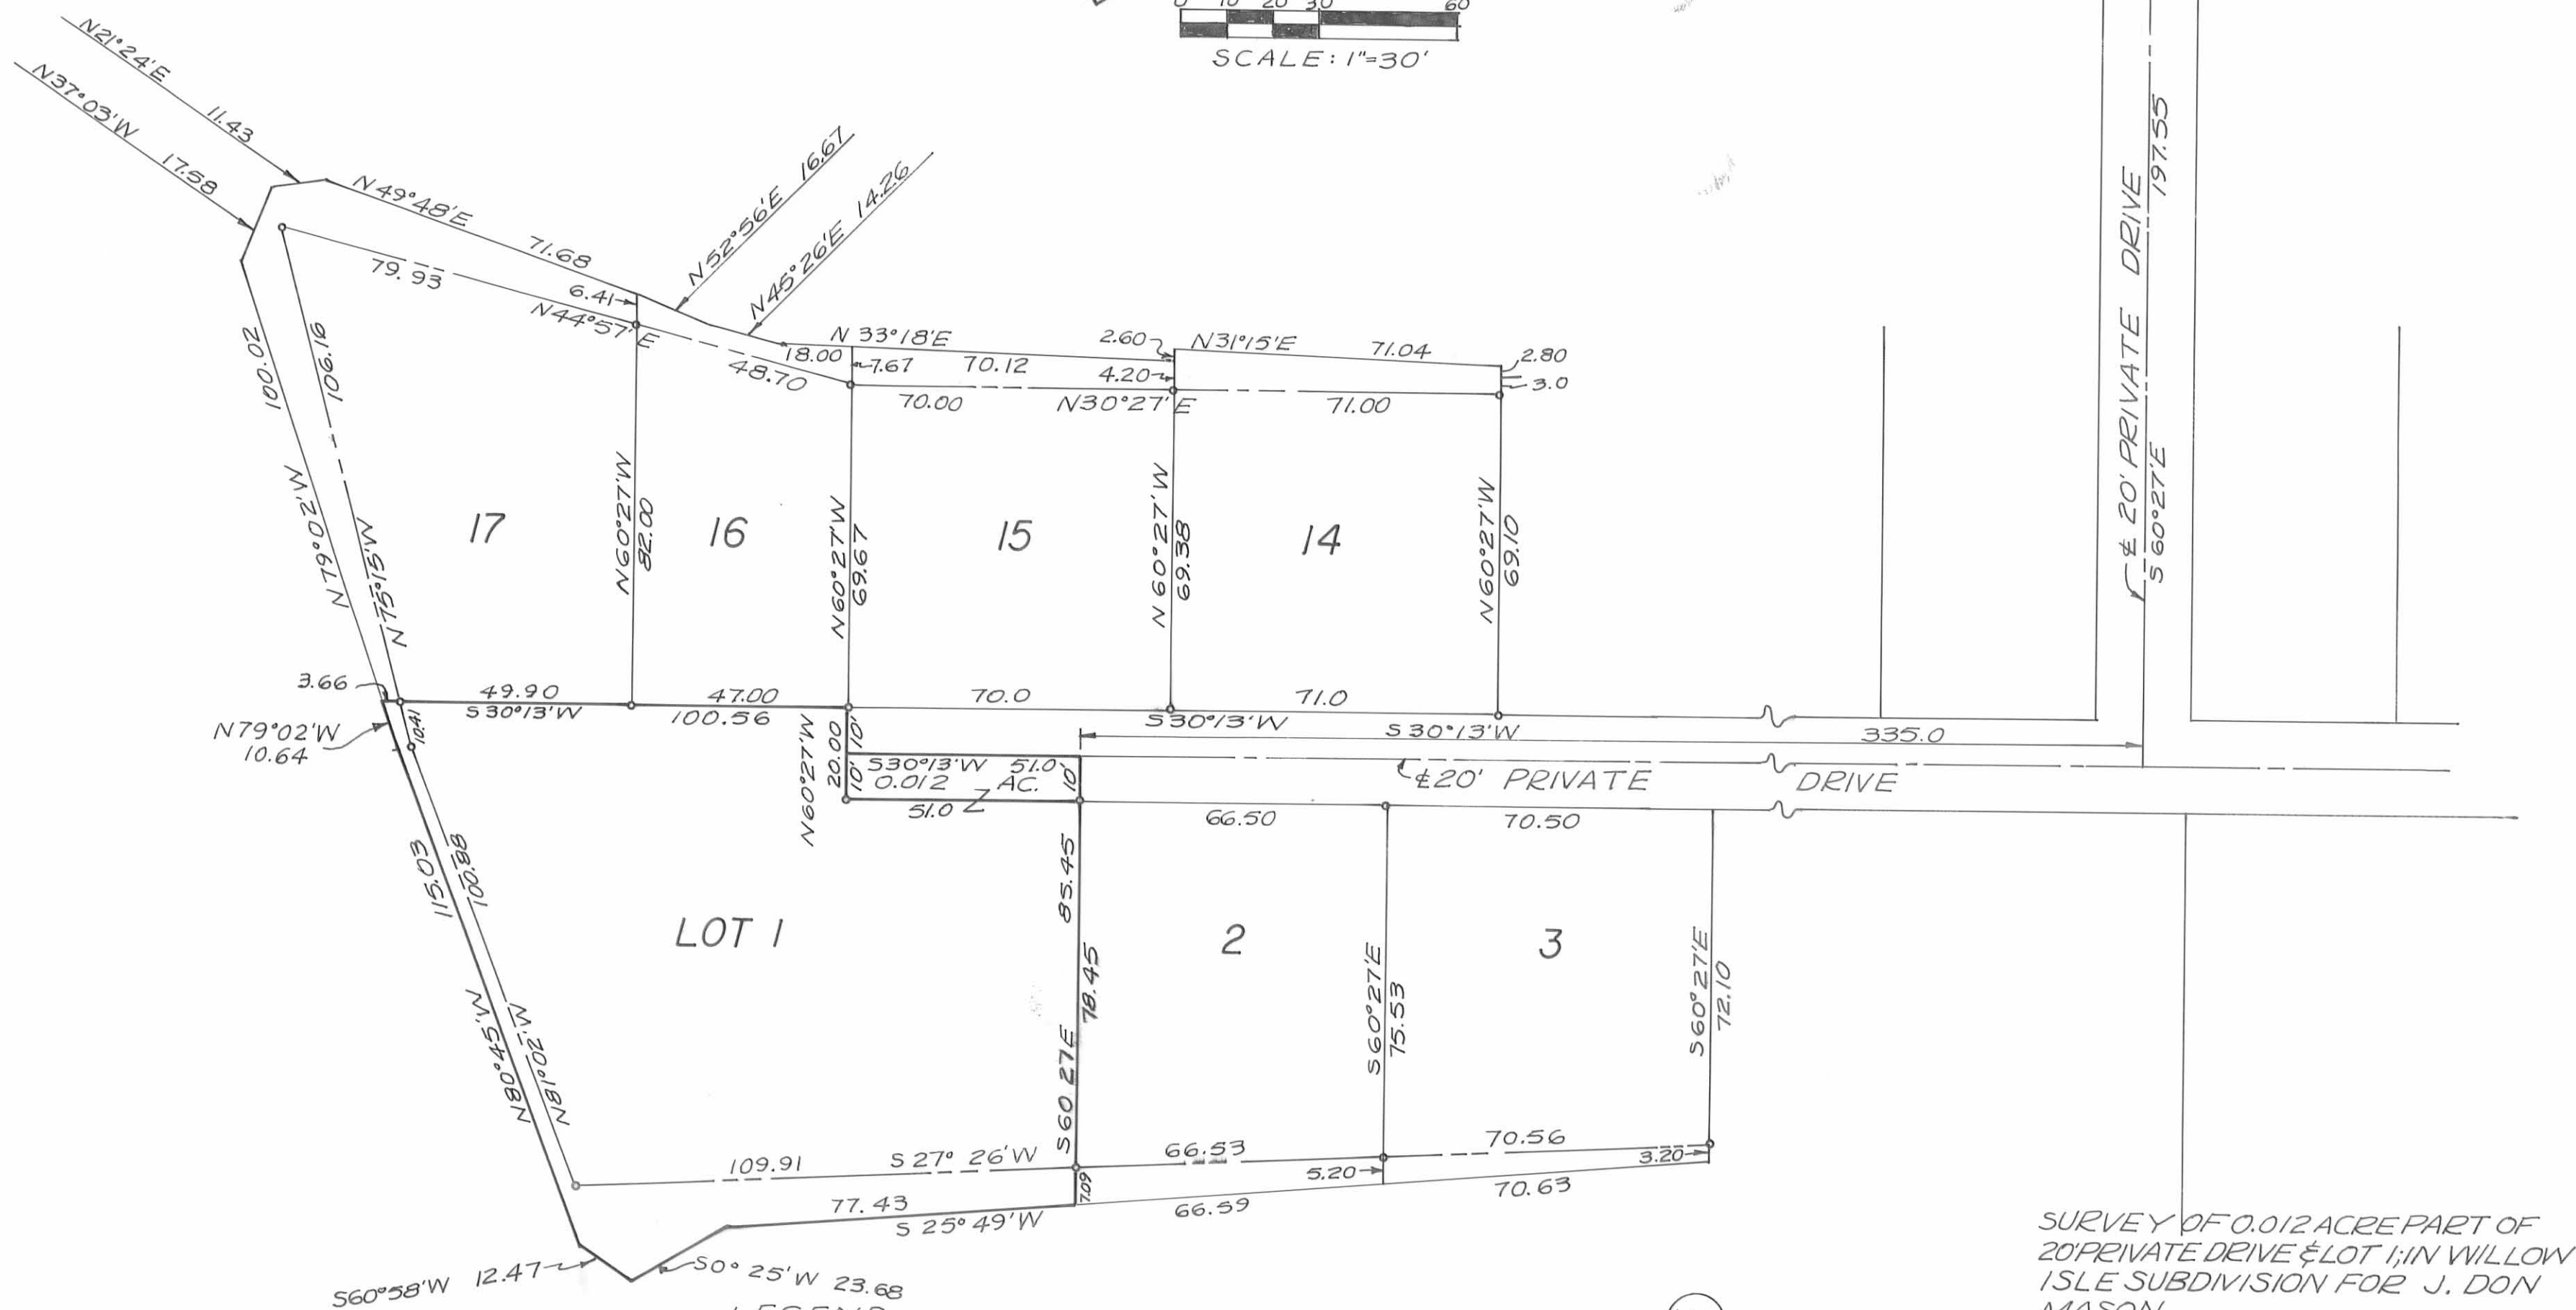


DATED: 20 OCT 1981

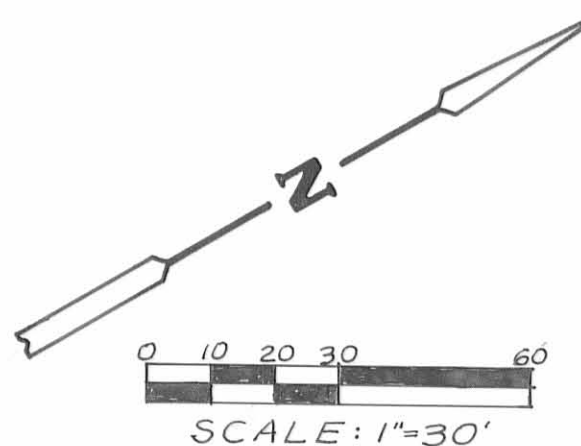

LEGEND
• = IRON PIN (SEE RECORD PLAT)

SURVEY REFERENCE
WILLOW ISLE SUBDIVISION -
RECORD PLAT BOOK 4; VOL. D; PG. 78

SURVEY OF 0.012 ACRE PART OF
20' PRIVATE DRIVE & LOT 1; IN WILLOW
ISLE SUBDIVISION FOR J. DON
MASON.

INDEXED ON MAP



Richard W. Klockner
PROFESSIONAL SURVEYOR #4370
RICHARD W. KLOCKNER & ASSOC., INC.
CIVIL ENGINEERING & SURVEYING
16 E. WATER ST.
TROY, OHIO 45373
(513) 339-5331