


SURVEY OF
 LOTS 157-158-159-160
 RUSSELLS POINT, OHIO
 OCTOBER, 1967
 SCALE-1"=10'

- = Iron Pin
- ⊕ = Utility Pole
- WM. = Water Meter
- W.V. = Water Valve
- G.M. = Gas Meter
- G.V. = Gas Valve
- ⊕ = Tree

BENCH MARK (ASSUMED ELEV.)
 S.W. corner conc. walk at S.W. corner of
 2 Story Frame Metal Bldg.
 Elevation 1000.00

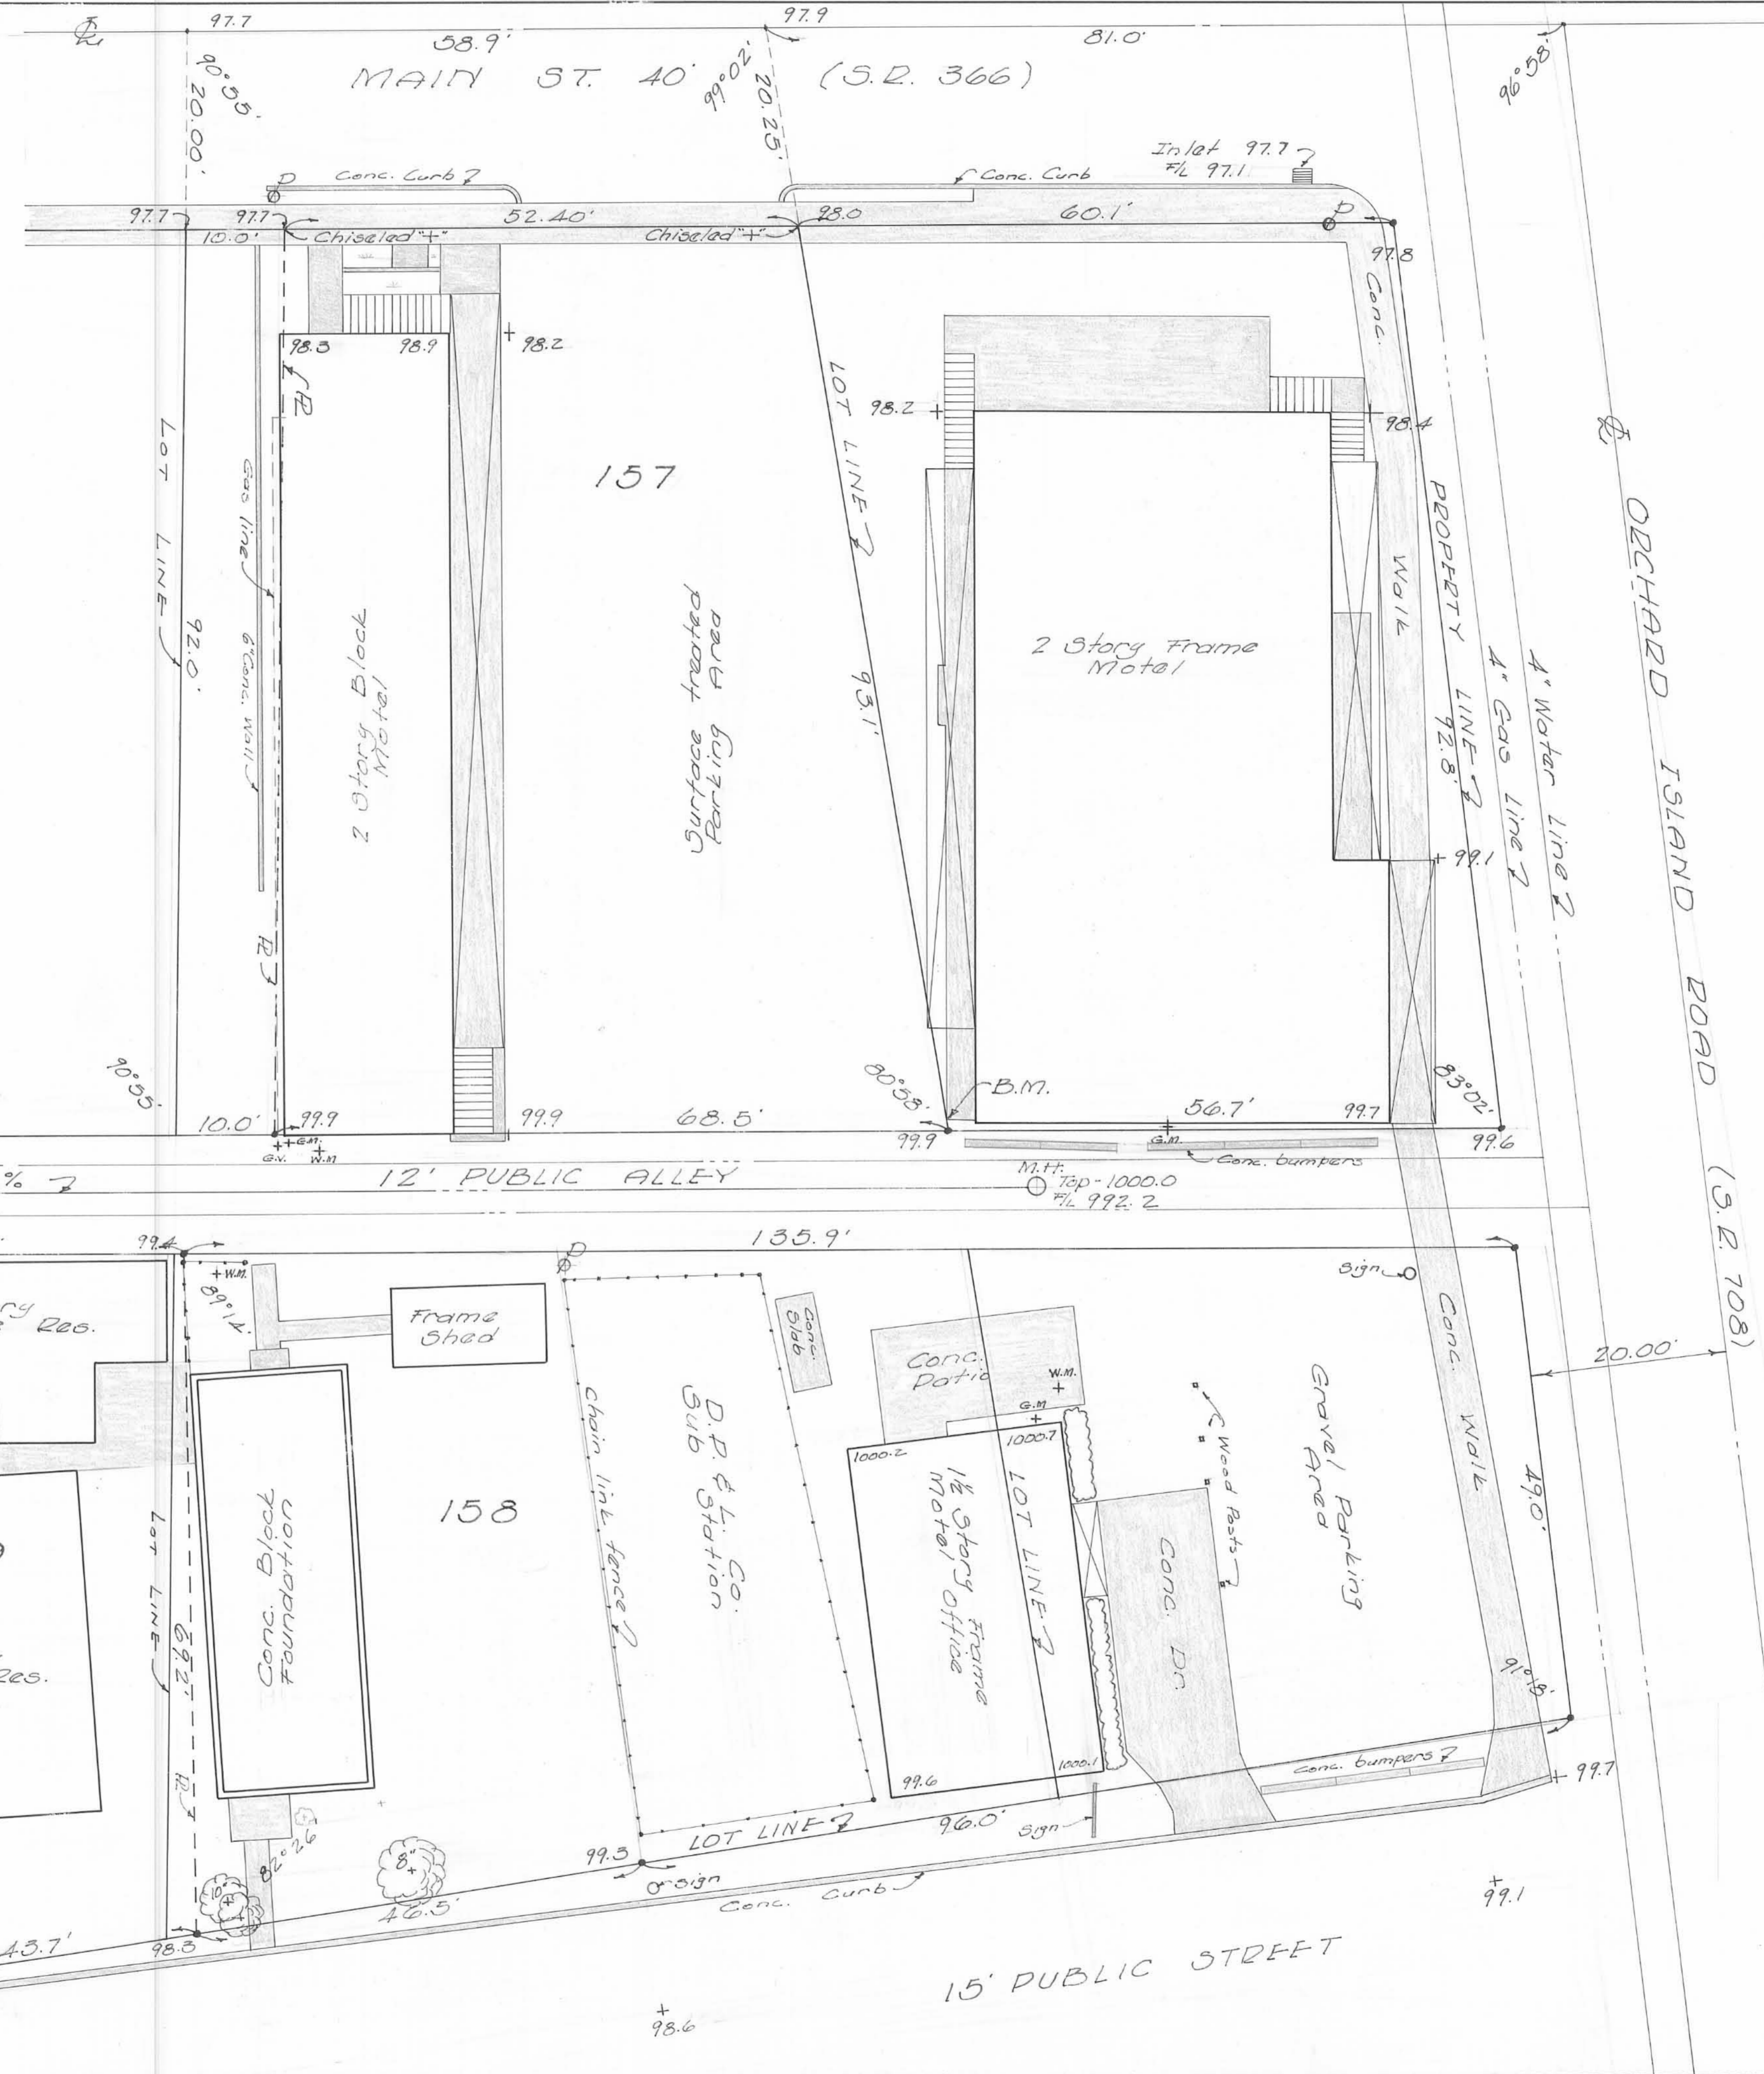

NOTE:
 2 Story Block Metal Bldg.
 on lot 157 encroaches at
 N.W. corner.

REFERENCE:
 Logan County Engineers
 Field Book 390-A, Pg. 1.

Dan L. Dodson
 Dan L. Dodson
 Reg. Surveyor 4270
 Bellefontaine, Ohio