


SEWER & WATER LOCATION PLAN  
 POINT VILLAGE  
 RUSSELLS POINT, OHIO  
 AUGUST, 1980  
 SCALE 1" = 50'

Note: Int figures are as built, located  
 May 2, 1981  
 Elevations are as built using Point Village  
 Datum which is 0.42 higher than U.S.G.S.  
 Datum.

*Dan L. Dodson*  
 Dan L. Dodson  
 Reg. Surveyor 4270

PLAN PREPARED BY  
 DAN L. DODSON  
 REG. SURVEYOR 4270  
 BELLEFONTAINE, OHIO

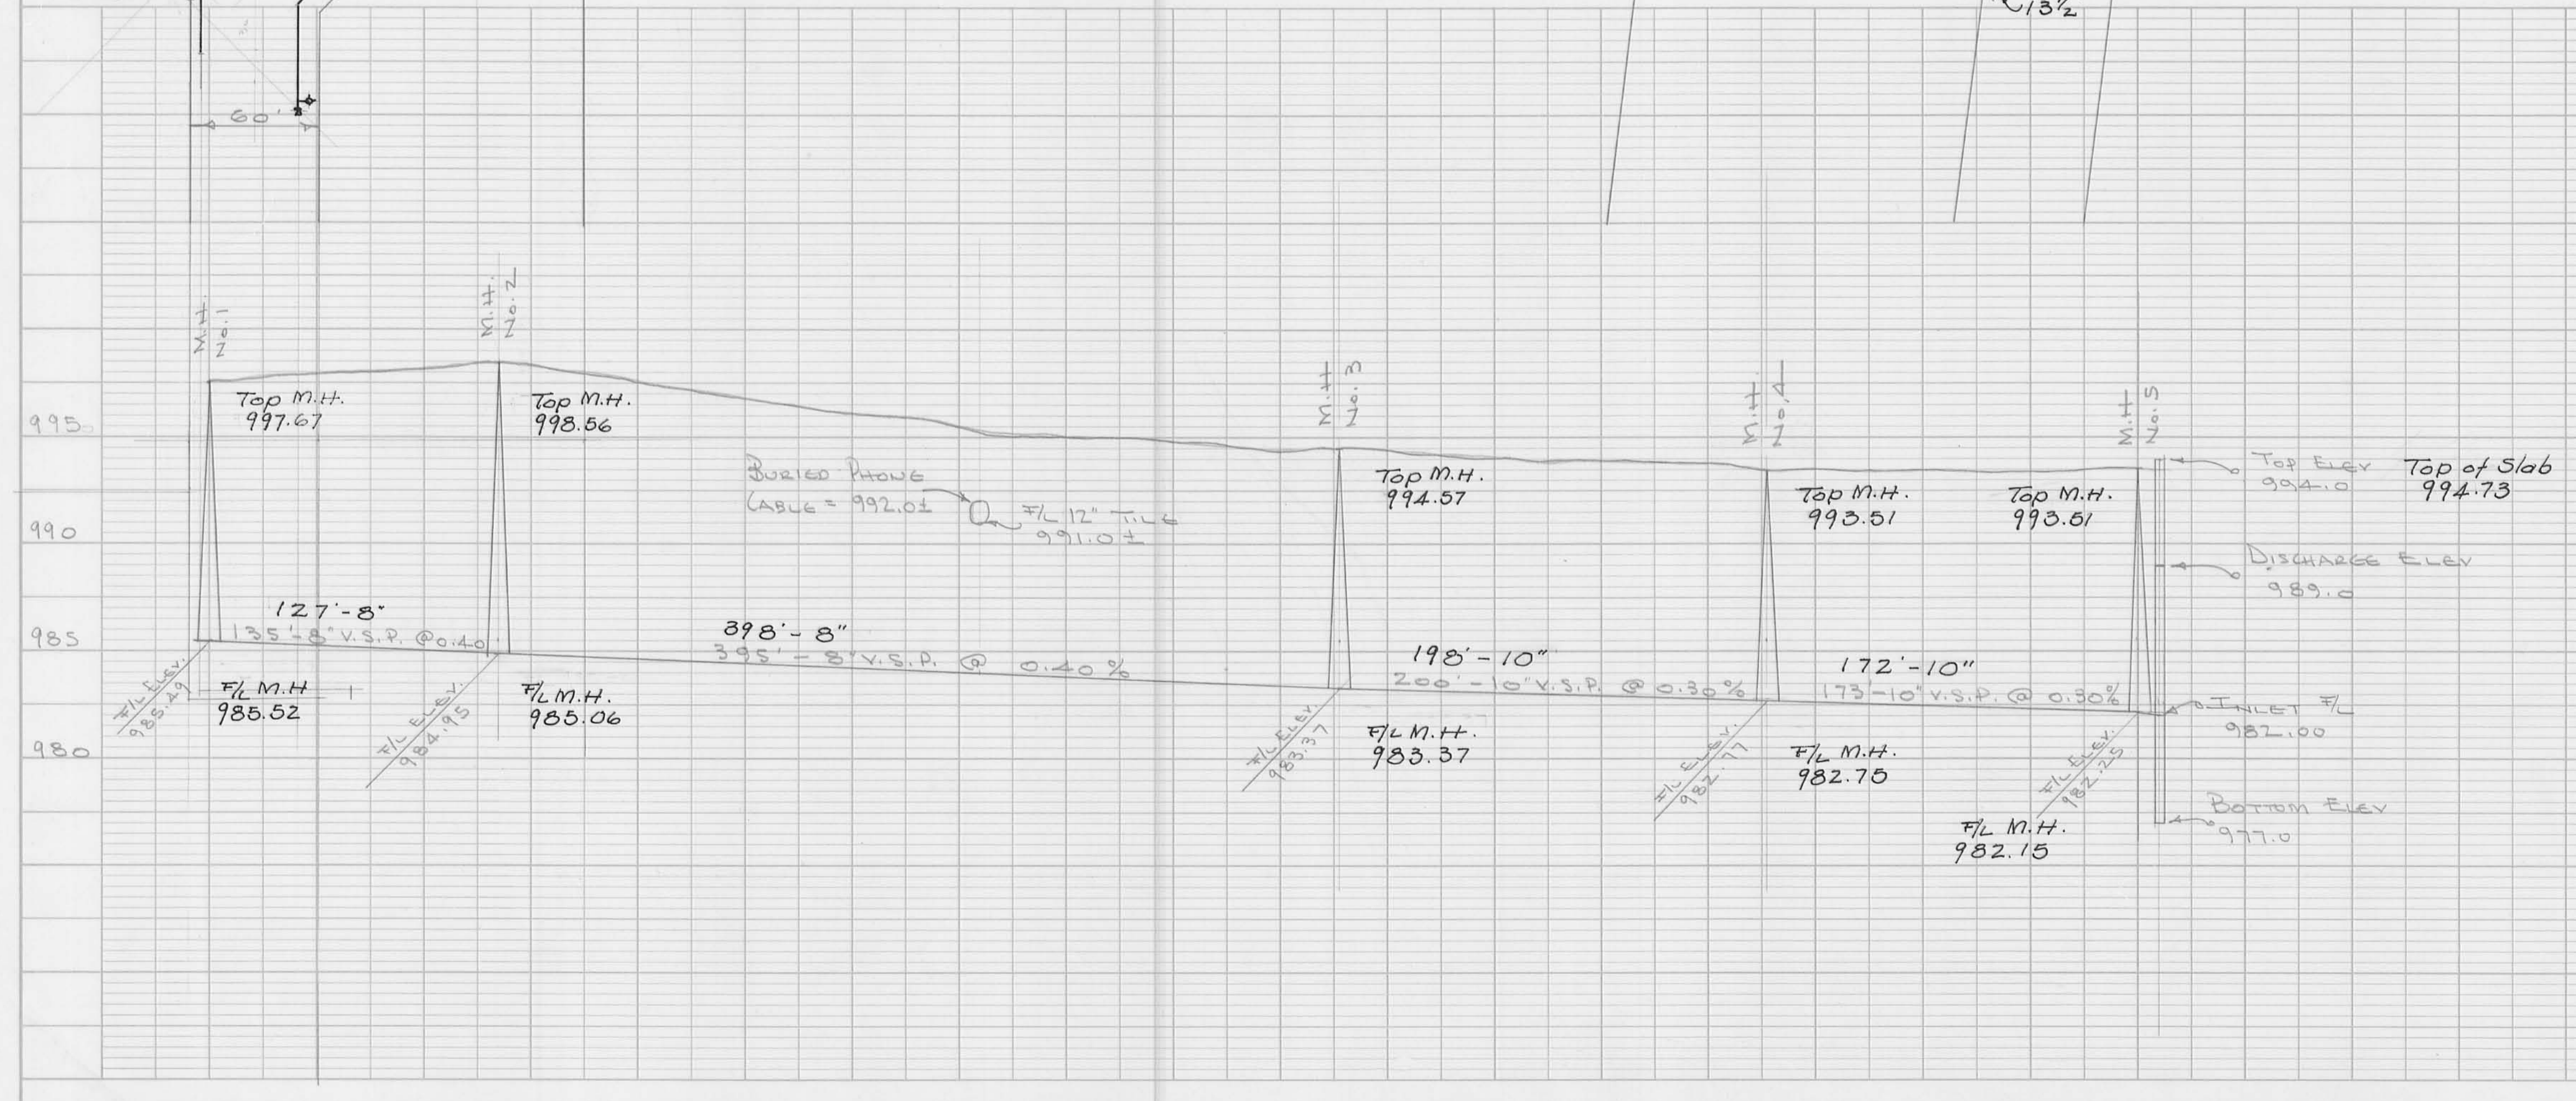

PLAN  
 SURVEYED BY  
 NOTE BOOK  
 GRADE CHECKER  
 & M.A. NOTED  
 STRUCTURE INDICATIONS CHECKED

PROFILE  
 SURVEYED BY  
 NOTE BOOK  
 GRADE CHECKER  
 & M.A. NOTED  
 STRUCTURE INDICATIONS CHECKED