


FLOYD C. HEADINGS  
81.21 AC.

FLOYD C. HEADINGS  
160.00 AC.

100.00 AC.

FROMAN SURVEY  
BLACK LAKE  
SEC. 35 T-4 R-13  
MIAMI TOWNSHIP  
LOGAN COUNTY, OHIO  
JUNE, 1968  
SCALE 1"=200'

FLOYD HARPEST  
85.54 AC.

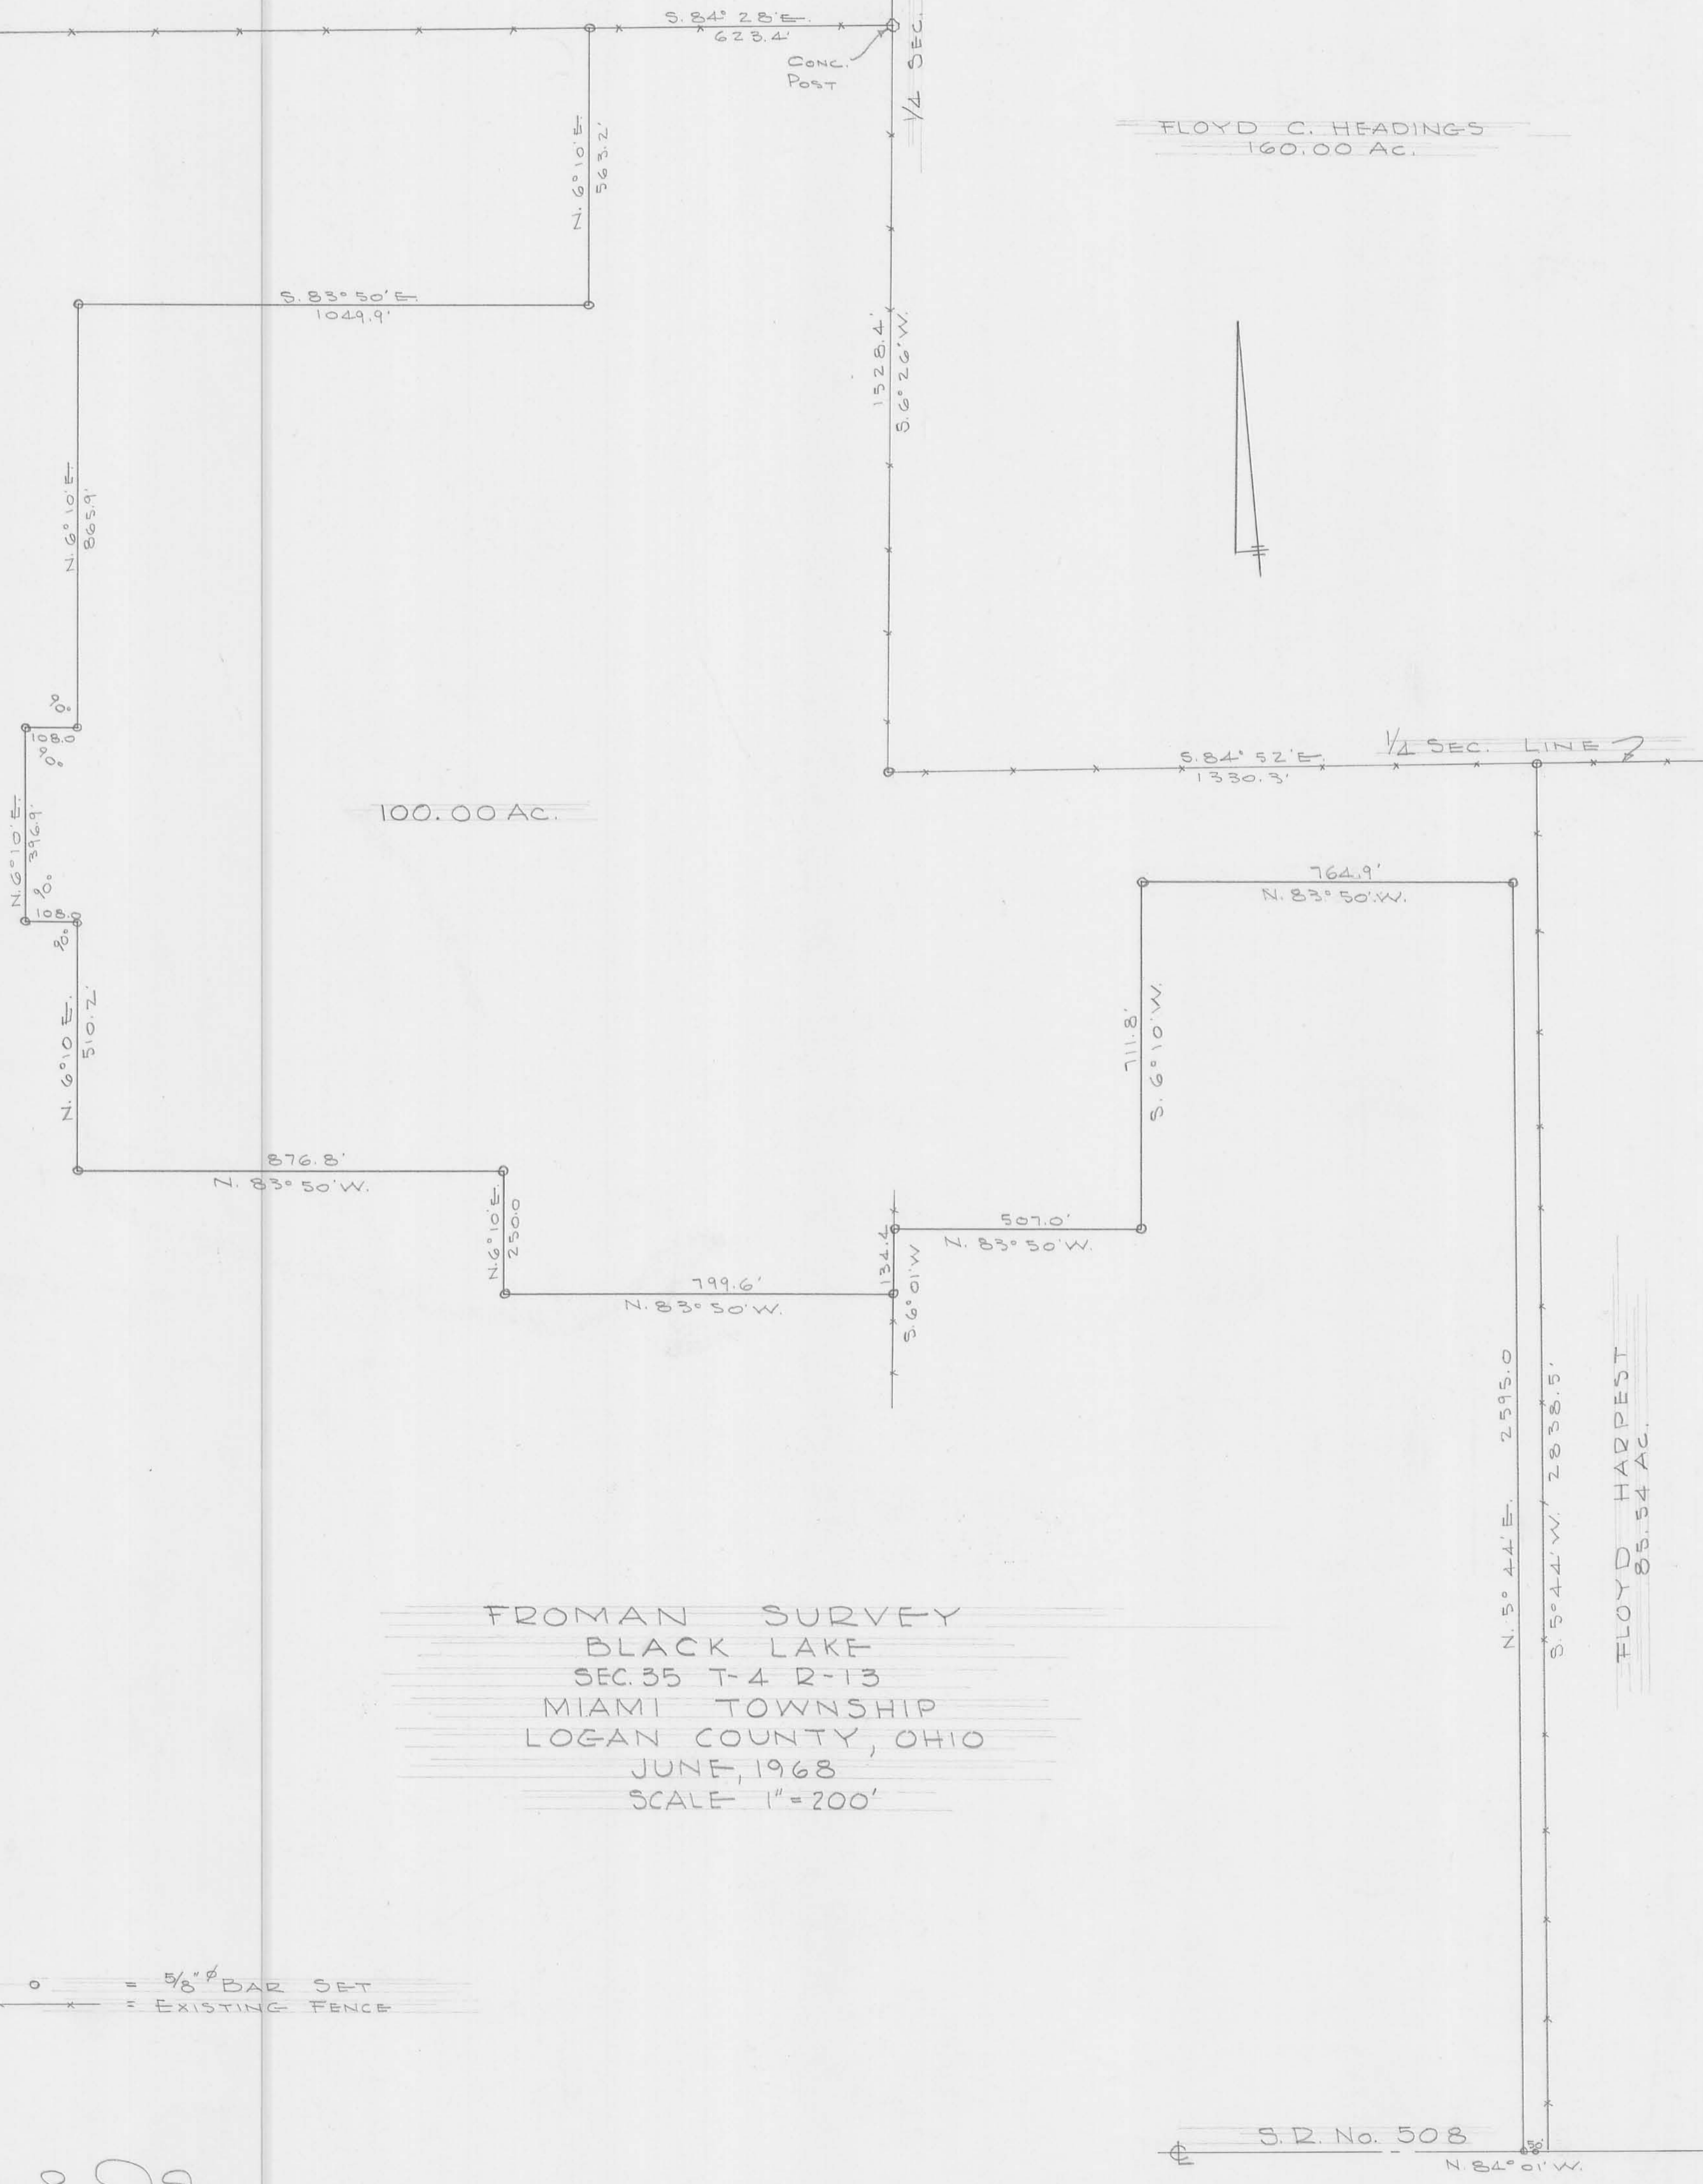

S.R. No. 508  
N. 84° 01' W. 65.0'

*Dan L. Dodson*

DAN L. DODSON  
REG. SURVEYOR 4270  
BELLEFONTAINE, OHIO