



PLAN
 SCALE - 3/8" = 1'

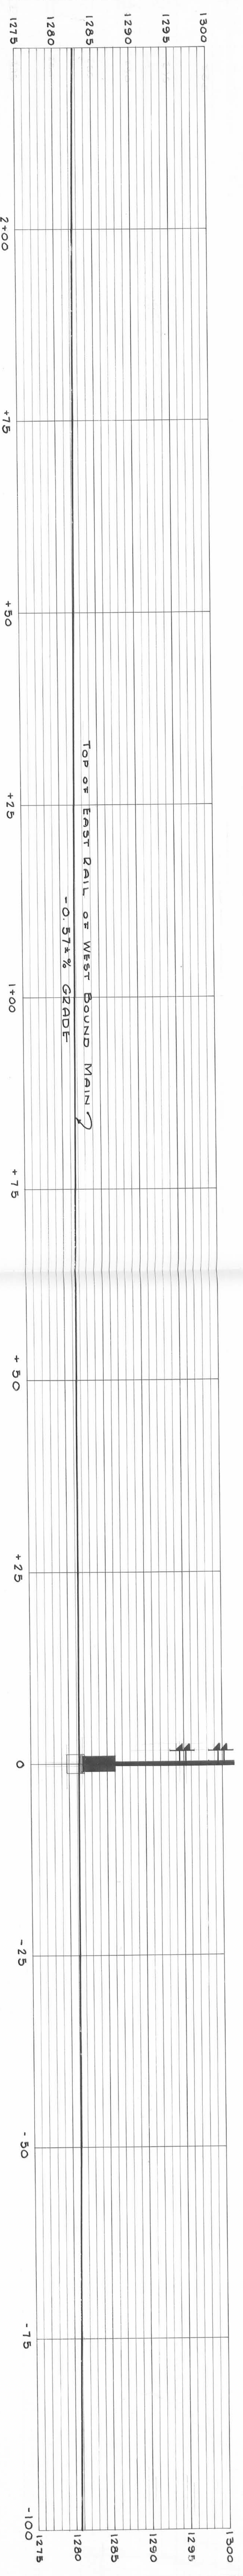

PROFILE
 SCALE: HORIZ. 3/8" = 1'
 VERT. 3/8" = 1'

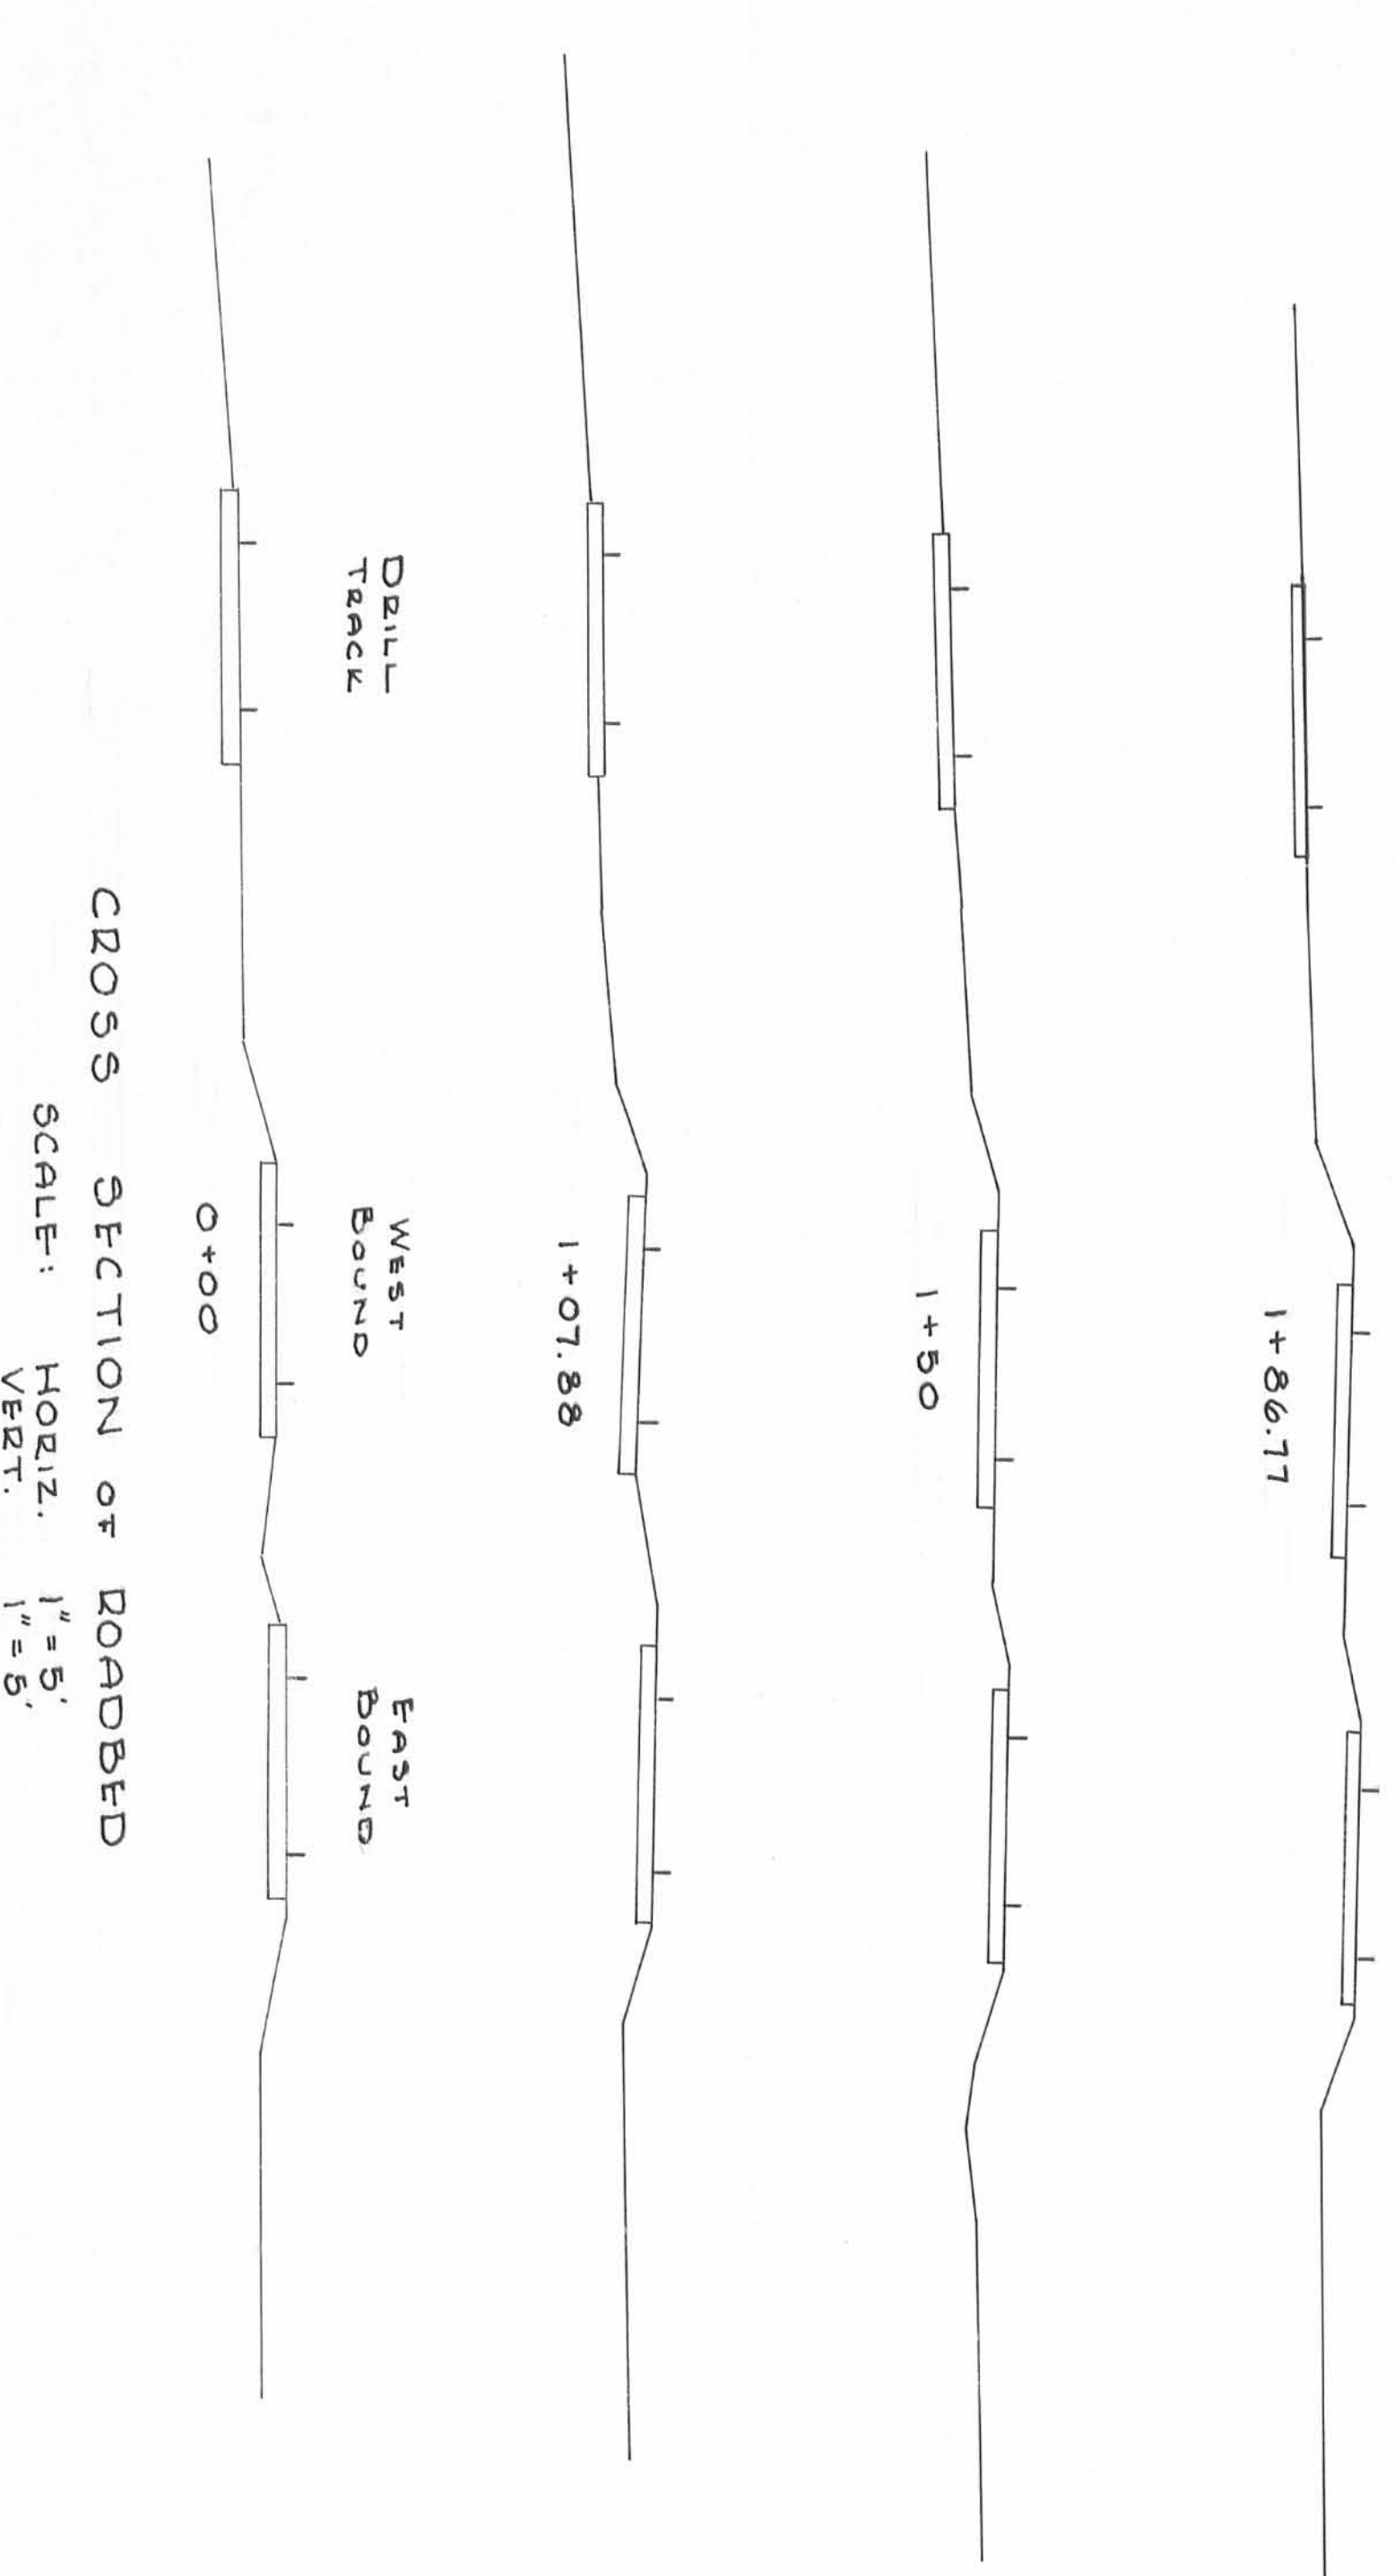

CROSS SECTION OF ROADBED
 SCALE: HORIZ. 1" = 5'
 VERT. 1" = 5'

BENCH MARK - U.S.G.S. DATUM
 N.E. CORNER OF HOME SIGNAL ON
 TOP OF CONCRETE PIER
 ELEVATION 1281.85

SURVEY FOR
 PENN CENTRAL RAILROAD
 BN YARD
 V.M.S. 2875
 LAKE TOWNSHIP
 LOGAN COUNTY, OHIO
 APRIL 6, 1968

I HEREBY CERTIFY THAT THIS PLAN
 IS A CORRECT REPRESENTATION OF THE
 SURVEY MADE BY ME ON APRIL 6, 1968

DAN L. DOBSON
 REG. SURVEYOR 4270
 DELAWAREVILLE, OHIO